




0055-127

DEPARTMENT OF MINES TROPICAS  
 PLAN RECEIVED UNDER SECTION 311 MINES INSPECTION ACT  
 A/CARD NO. 85023  
 ELECTROLYTIC ZINC CO. OF AUSTRALIA, LTD.  
 ROSEBERY MINE, 16 LEVEL - 2  
 CO. REF. WORKINGS AT 12/84

DEPARTMENT OF MINES  
 BROUGHT TO DATE 31 DEC 1984  
 MINE MANAGER: *[Signature]*  
 MINE SURVEYOR: *[Signature]*

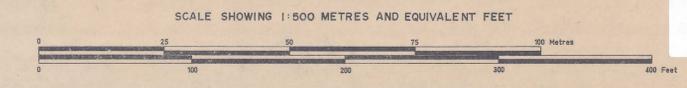

ELECTROLYTIC ZINC COMPANY OF AUSTRALASIA LIMITED  
 WEST COAST MINES, T.A.S.

SURVEY BY		SCALE	1:500
DRAWN BY		DATE	1975
TRACED BY	I.T.M.	REFERENCE	

ROSEBERY MINE  
 No 16 LEVEL (2)

DRAWING No: 1 2 3