



0055 - 129

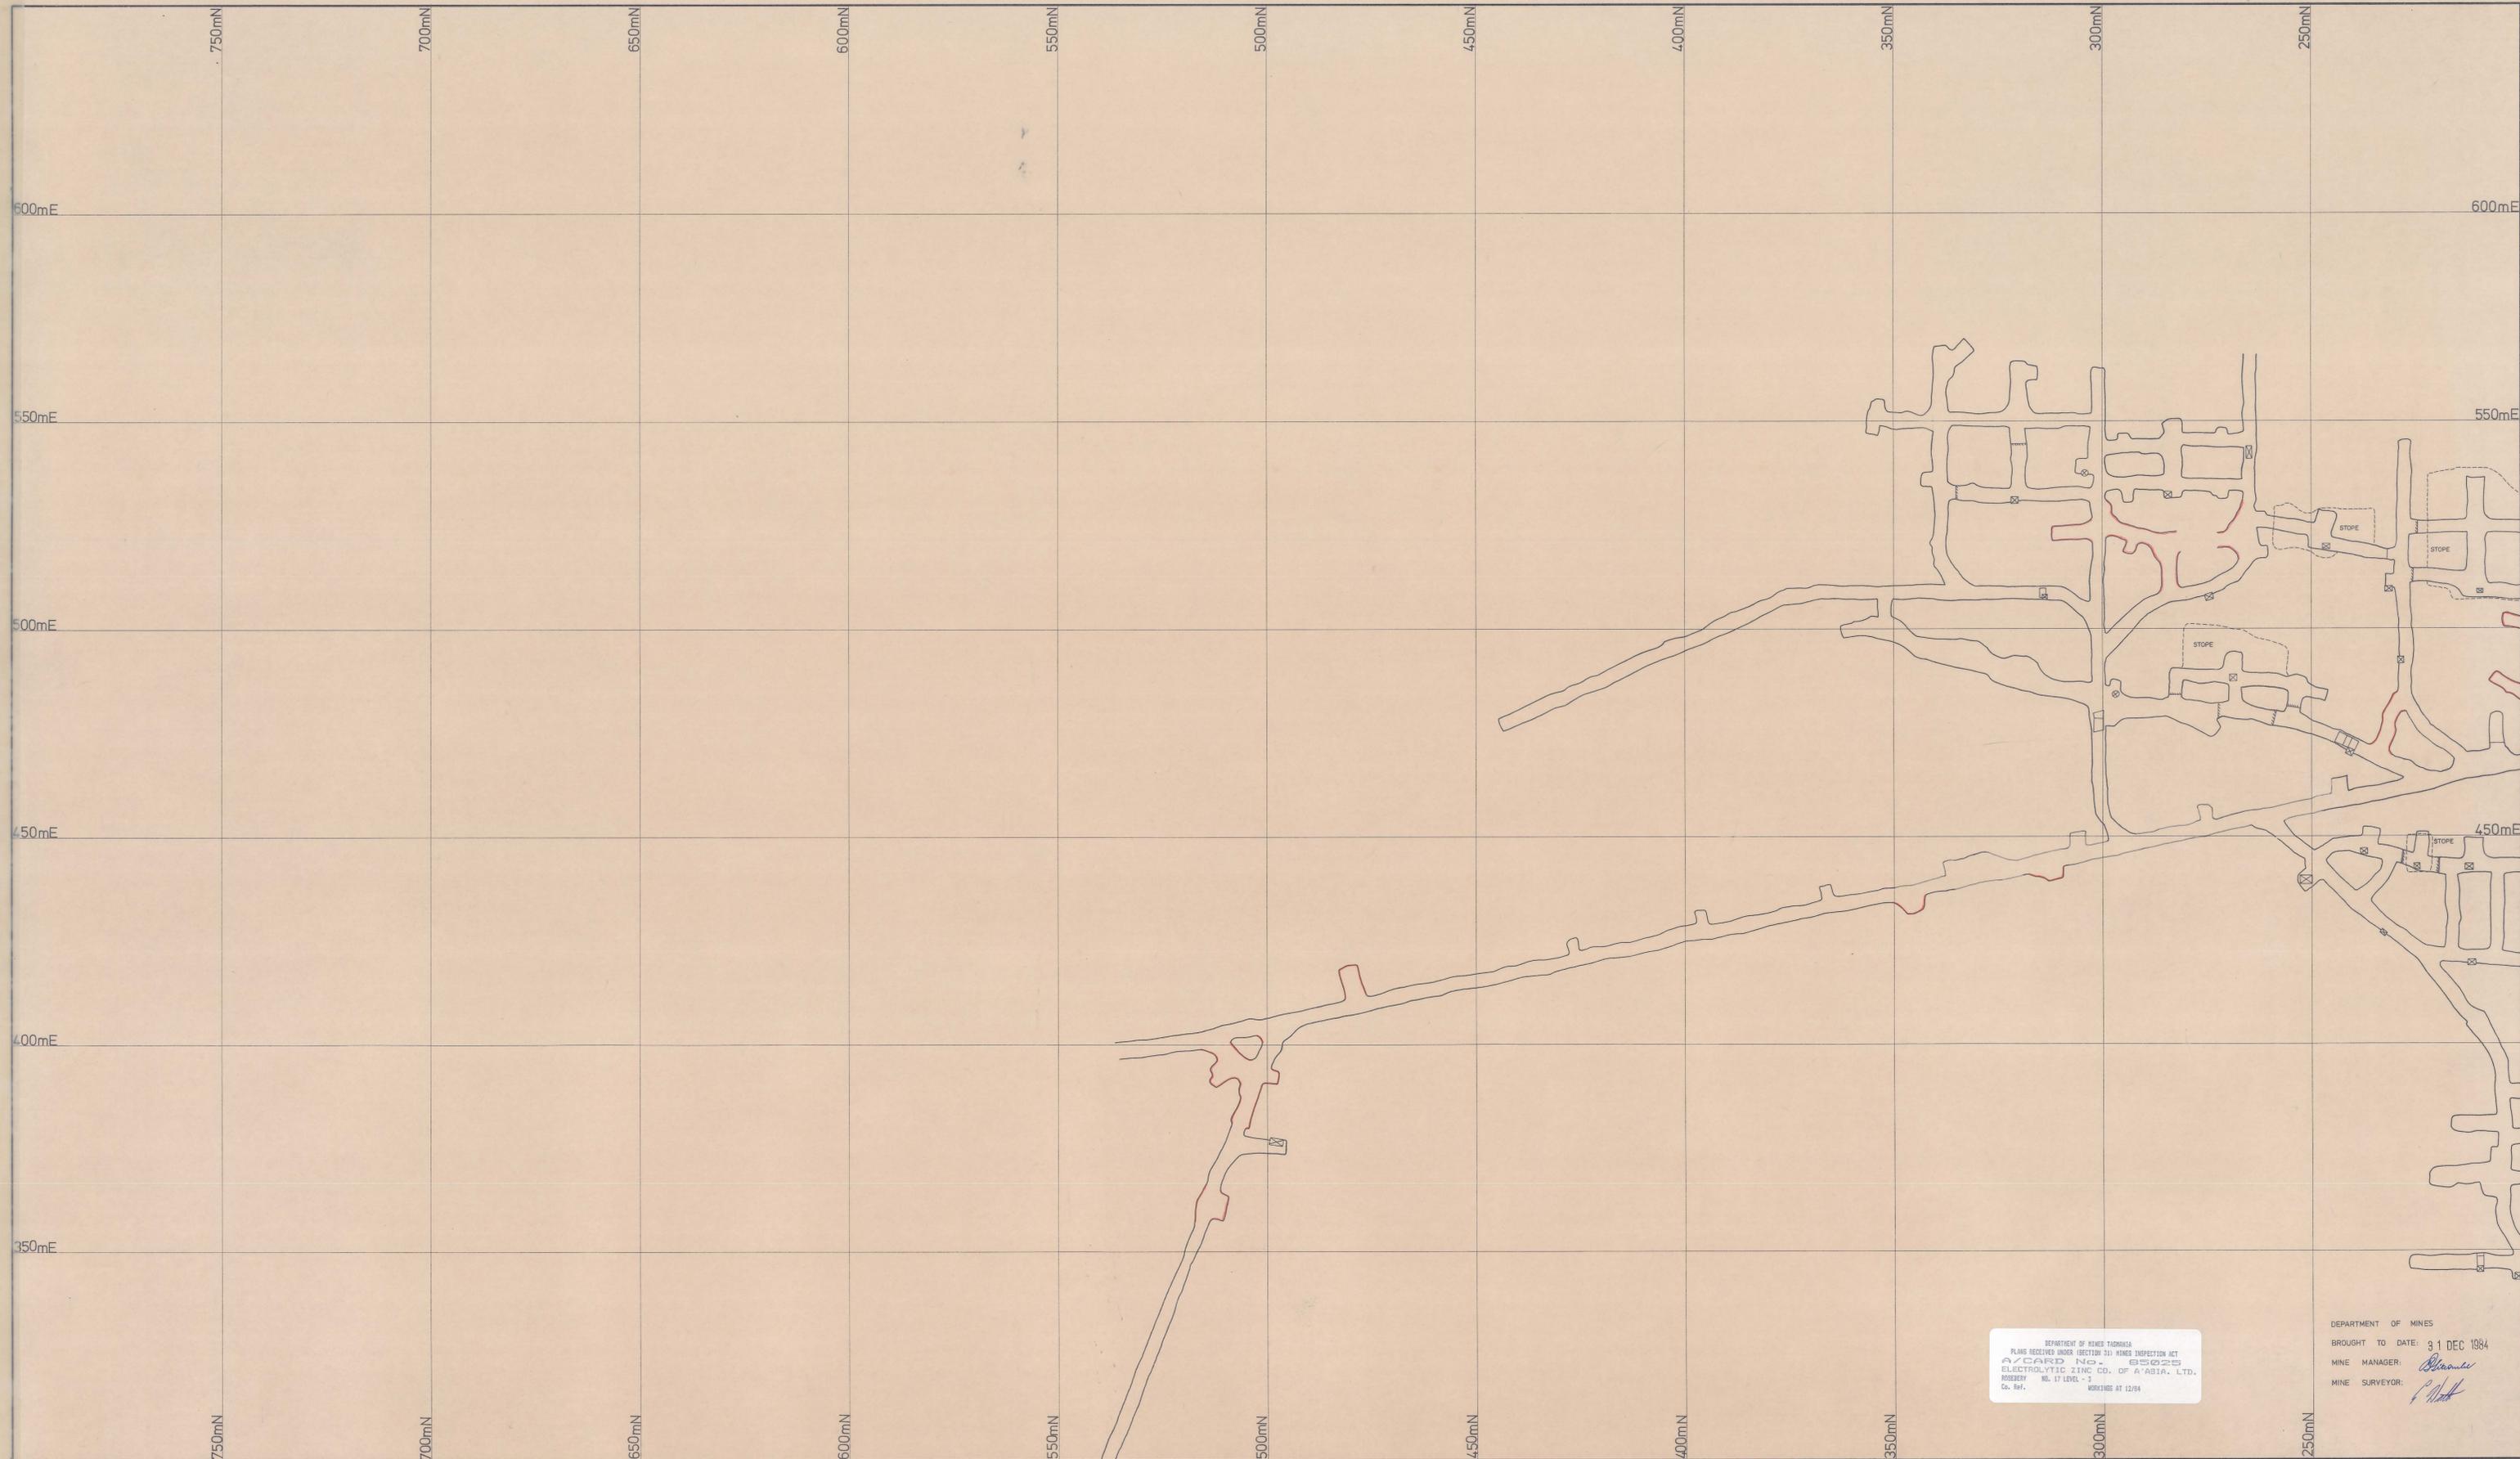

DEPARTMENT OF MINES TASMANIA  
 PLANS RECEIVED UNDER SECTION 31, MINES INSPECTION ACT  
 A/CARD No. 85225  
 ELECTROLYTIC ZINC CO. OF AUSTRALASIA, LTD.  
 ROSEBERY No. 17 LEVEL - 3  
 Co. Ref. WORKINGS AT 12/84

DEPARTMENT OF MINES  
 BROUGHT TO DATE: 31 DEC 1984  
 MINE MANAGER: *[Signature]*  
 MINE SURVEYOR: *[Signature]*

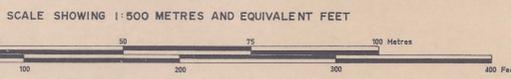

ELECTROLYTIC ZINC COMPANY OF AUSTRALASIA LIMITED  
 WEST COAST MINES, T.A.S.

SURVEY BY		SCALE	1:500
DRAWN BY		DATE	1975
TRACED BY	I.T.M.	REFERENCE	

ROSEBERY MINE  
 No 17 LEVEL (3)

