

0055 - 131

ELECTROLYTIC ZINC COMPANY OF AUSTRALASIA LIMITED


WEST COAST MINES DEPT.

Drawn	G.M. Bennett	29 05 84
Traced		
Checked		
Approved		

ROSEBERY MINE
18 N° 1 SUB LEVEL

SCALE:	FILE:
DESIGN:	DRAWING No.
SURVEY:	1

DEPARTMENT OF MINES
BROUGHT TO DATE: 31 DEC 1984
MINE MANAGER: *[Signature]*
MINE SURVEYOR: *[Signature]*

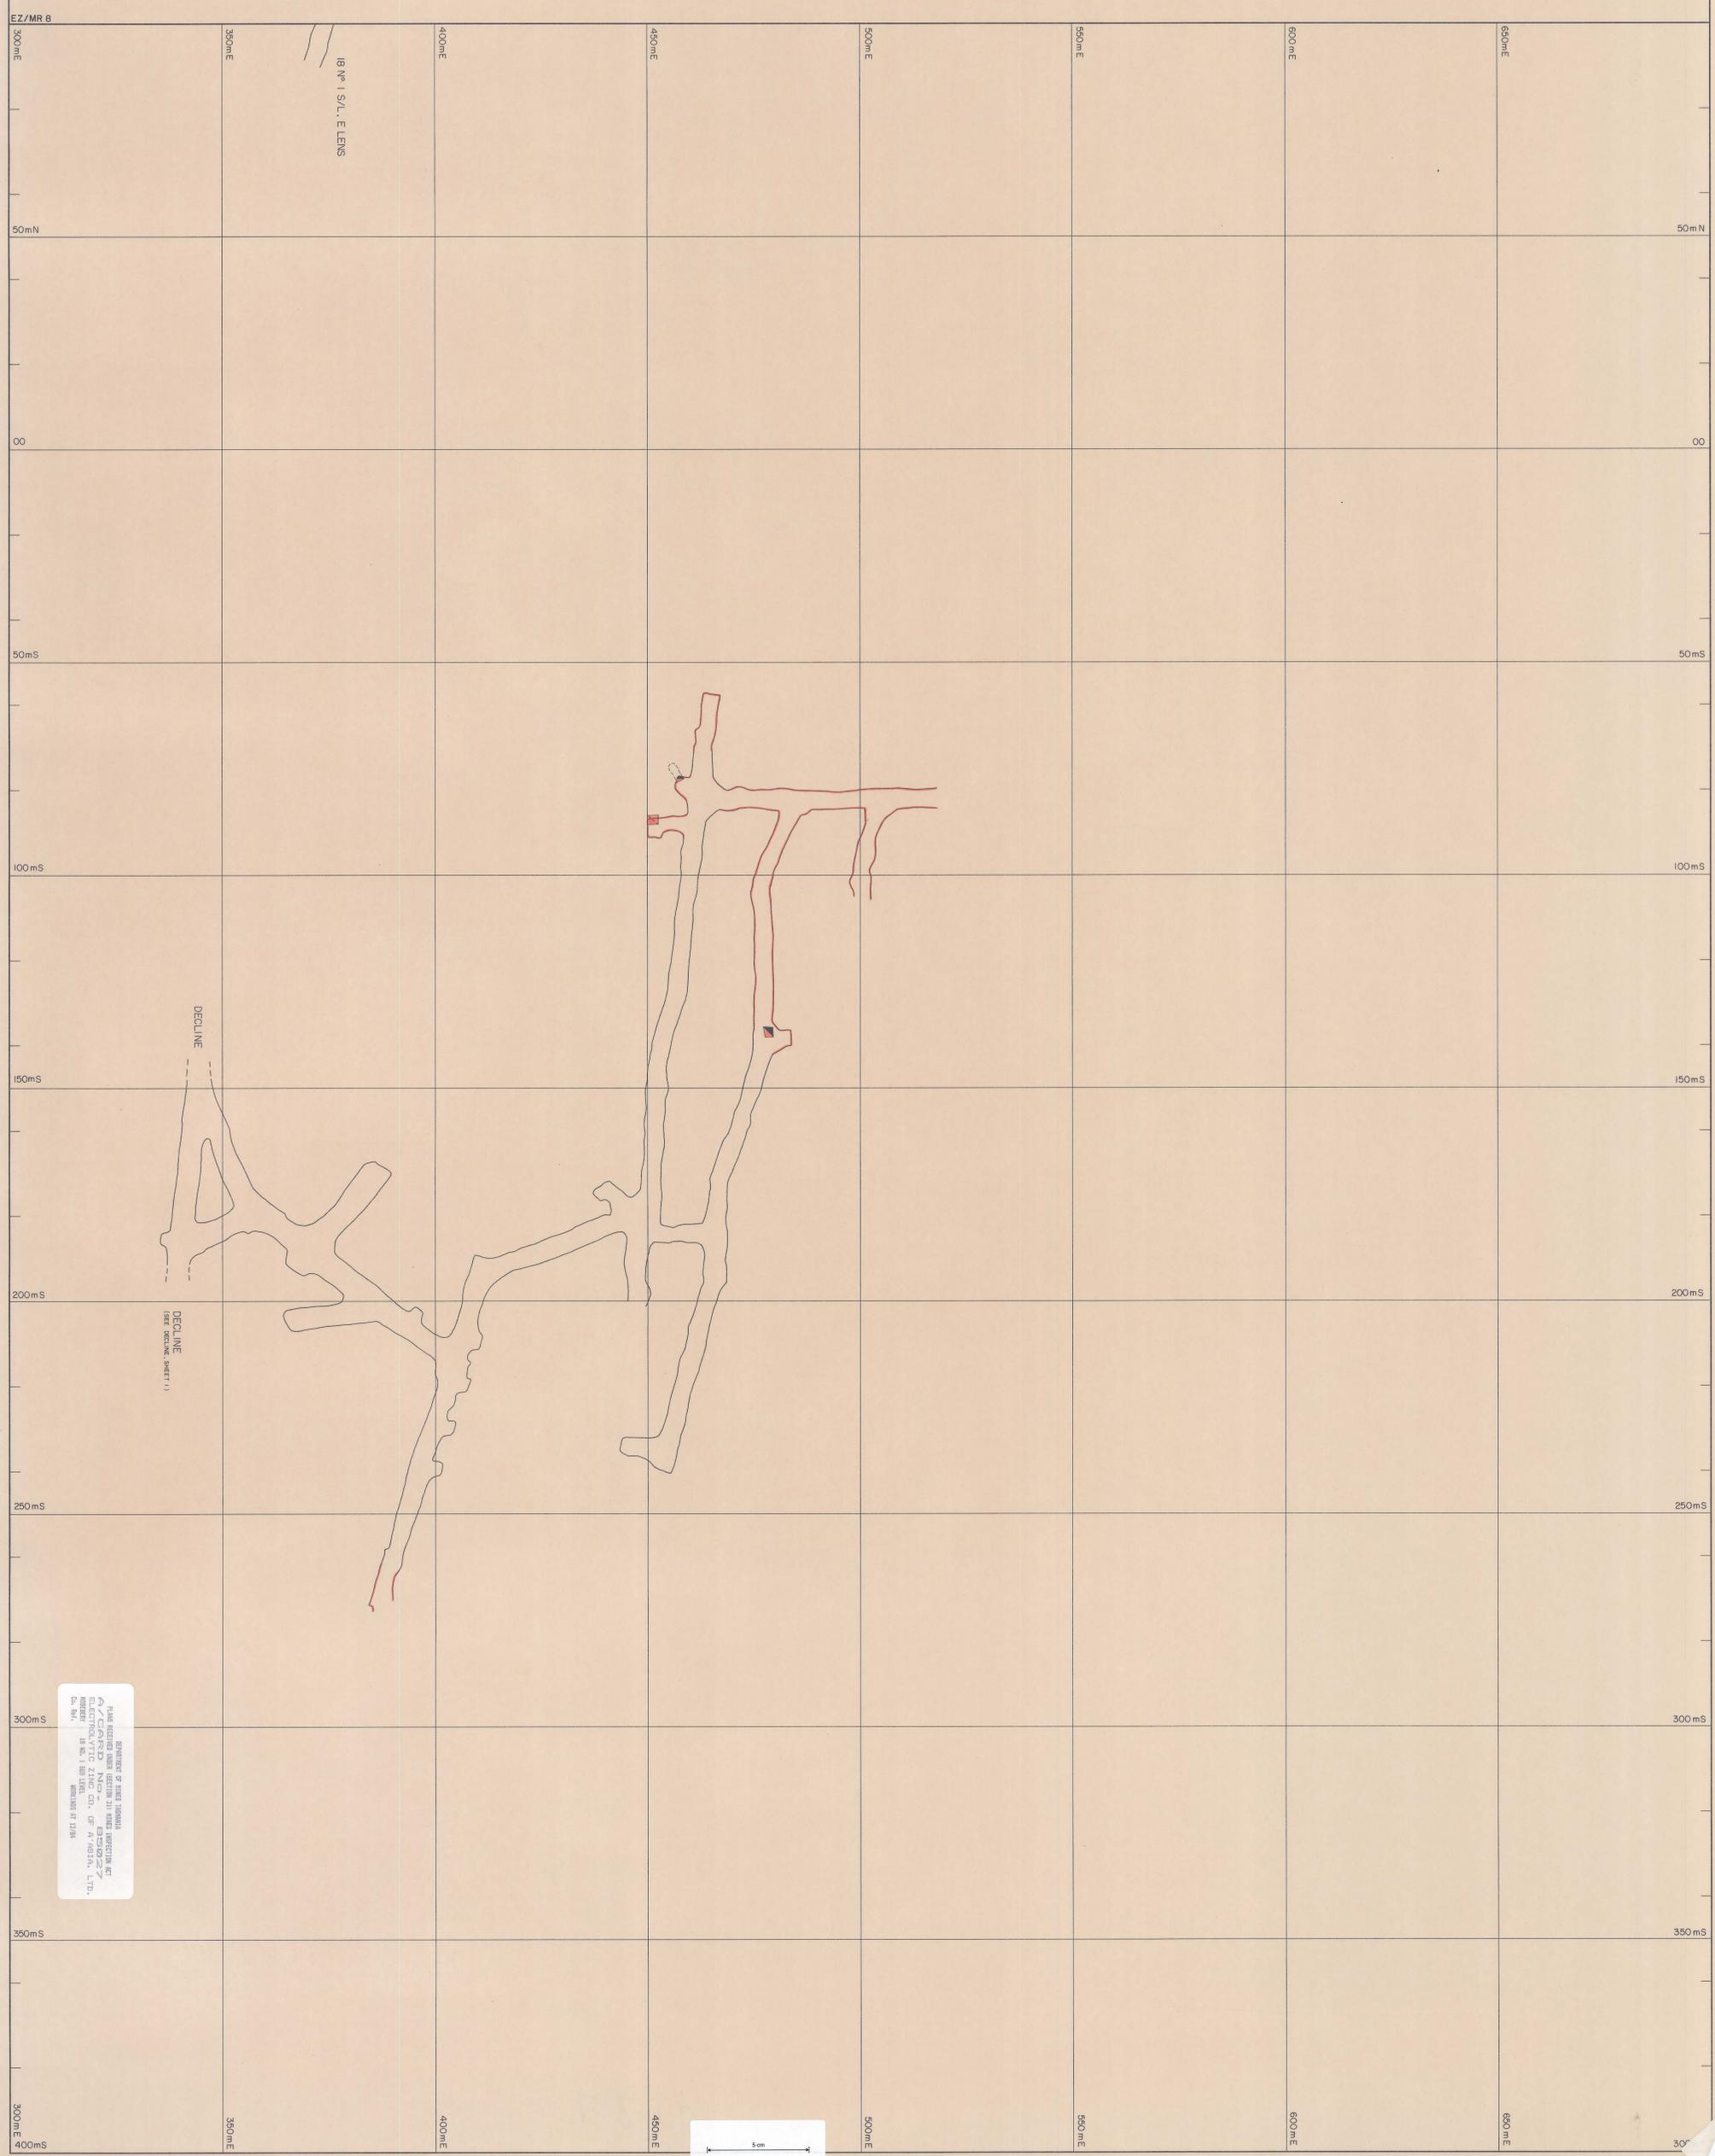

DEPARTMENT OF MINES
BROUGHT TO DATE: 31 DEC 1984
MINE MANAGER: *[Signature]*
MINE SURVEYOR: *[Signature]*