

0055-133

ELECTROLYTIC ZINC COMPANY OF AUSTRALASIA LIMITED

WEST COAST MINES

DEPT.

ROSEBERY MINE
18 N° 2 SUB LEVEL




SCALE:	FILE:
DESIGN:	DRAWING No.
SURVEY:	1

Drawn	By	Date
G. M. Bennett		31 05 84
Traced		
Checked		
Approved		

Revisions	Details			References		
	No.	By	Date	No.	By	Date

DEPARTMENT OF MINES
 BROUGHT TO DATE: 31 DEC 1984
 MINE MANAGER: *B. Brown*
 MINE SURVEYOR: *P. H. H.*

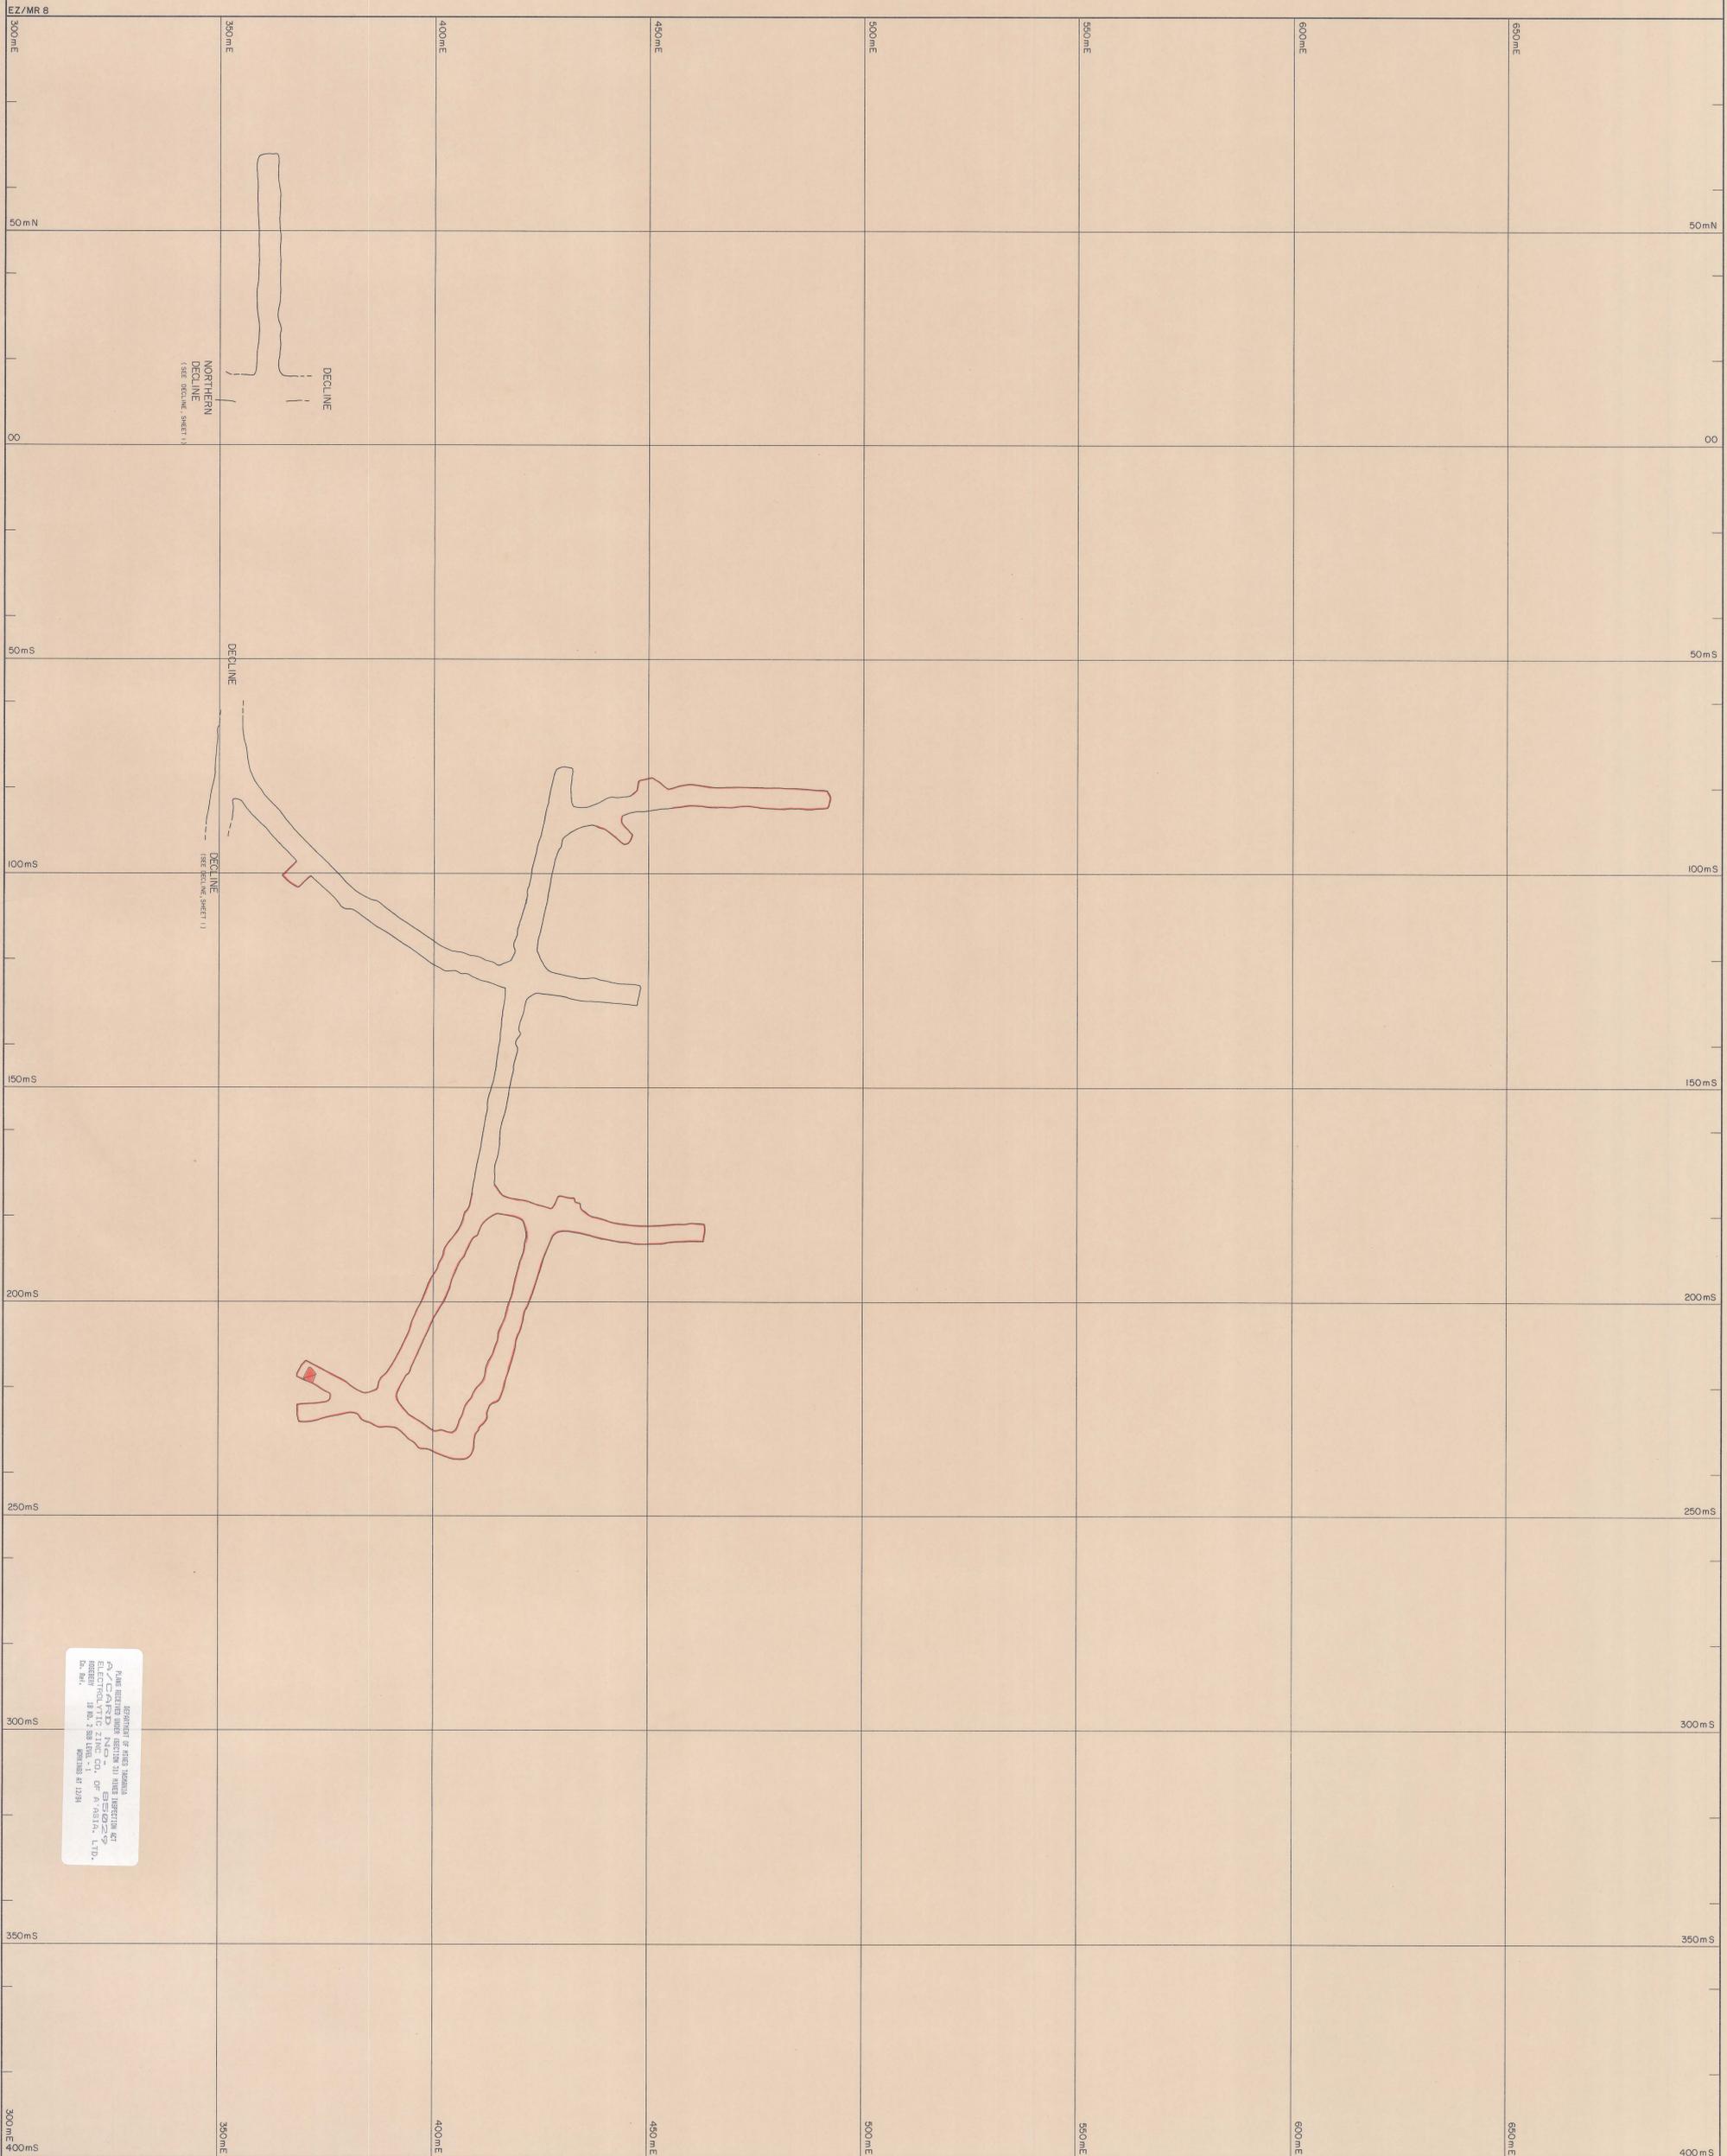

DEPARTMENT OF MINES
 A/C AND S/CS
 ELECTROLYTIC ZINC CO. OF AUSTRALASIA, LTD.
 DE. No. 18 N° 2 SUB LEVEL
 1984