

ELECTROLYTIC ZINC COMPANY OF AUSTRALASIA LIMITED WEST COAST MINES DEPT.

ROSEBERY MINE 18 CROWN SUB LEVELS




SCALE:	FILE:
DESIGN:	DRAWING No.
SURVEY:	1

By	Date
G. M. Bennett	06 06 84
Drawn	
Traced	
Checked	
Approved	

Revisions	No.		By		Date		Details		App.		No.		By		Date		Details		App.		References		No.	

DEPARTMENT OF MINES
 BROUGHT TO DATE : 31 DEC 1984
 MINE MANAGER : *[Signature]*
 MINE SURVEYOR : *[Signature]*

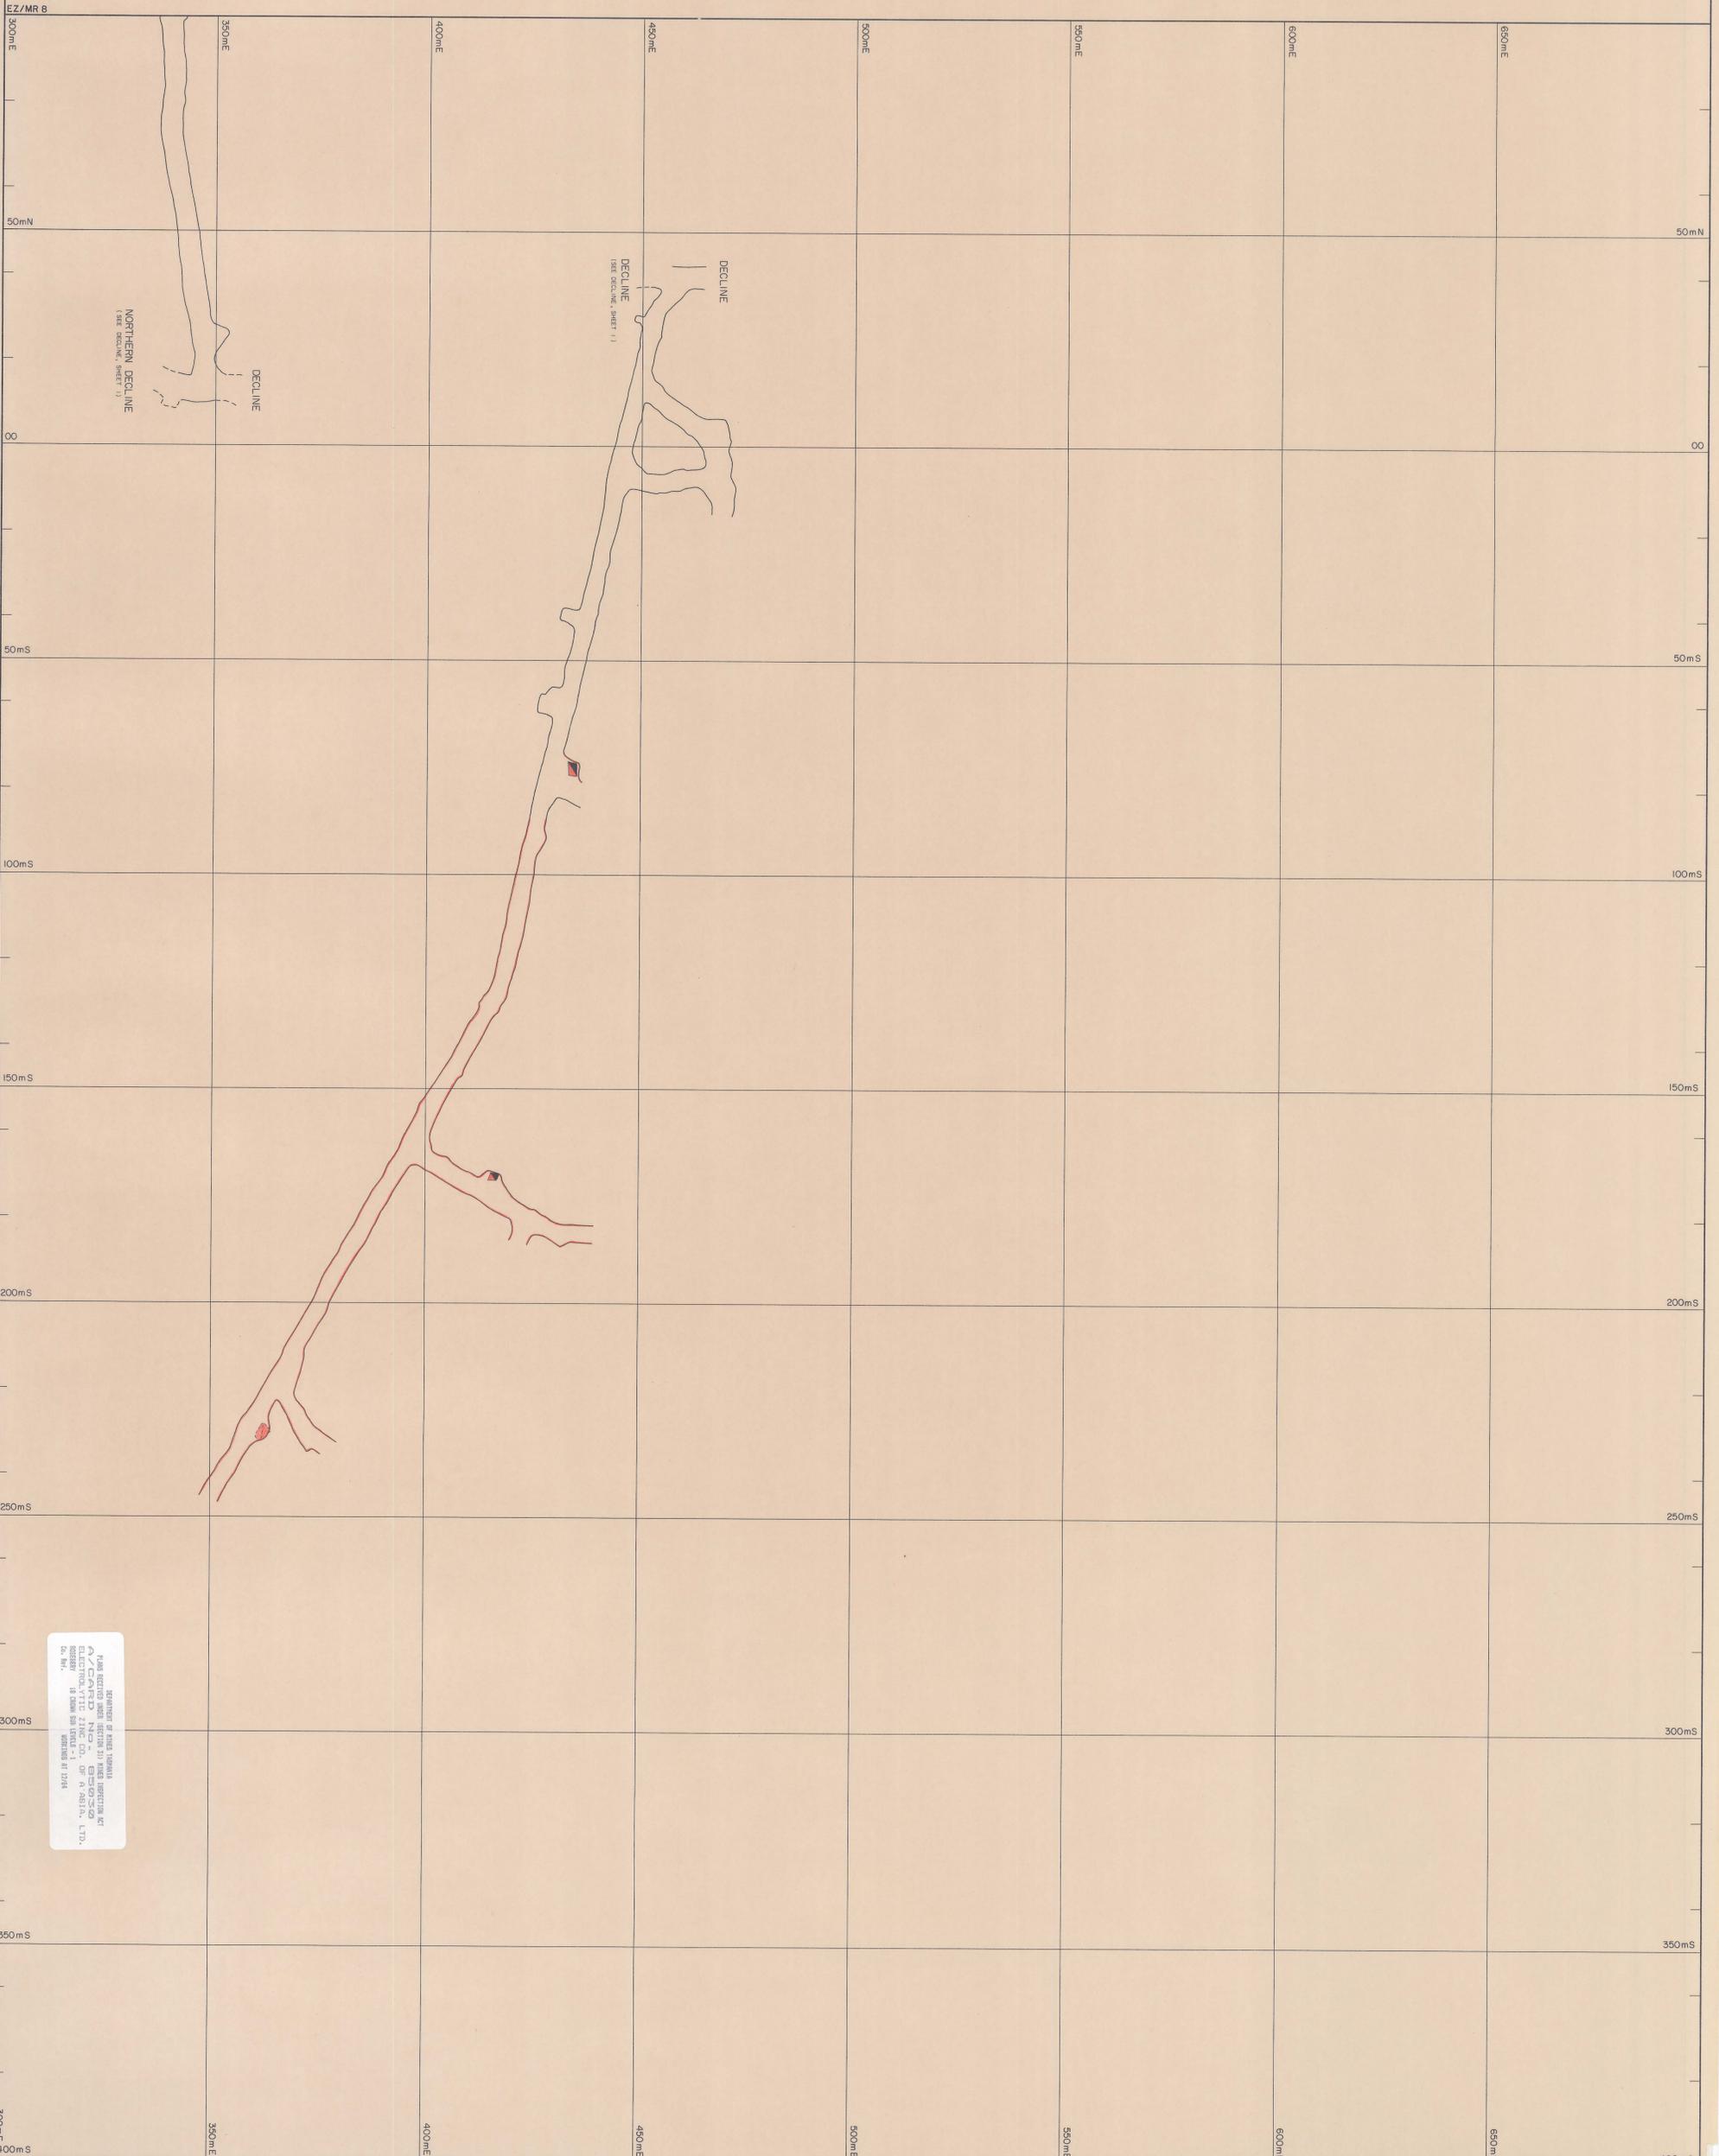

DEPARTMENT OF MINES
 MINE SURVEYOR
 M. J. CROFT
 MINE SURVEYOR
 18 CROWN SUB LEVELS - 1
 06.06.84