

0055 - 135

ELECTROLYTIC ZINC COMPANY OF AUSTRALASIA LIMITED

WEST COAST MINES

DEPT.

By	Date
Drawn G. M. Bennett	07 06 84
Traced	
Checked	
Approved	


ROSEBERY MINE 18 CROWN SUB LEVELS



SCALE:	FILE:
DESIGN:	DRAWING No.
SURVEY:	2

Revisions	No.			By			Date			Details			App.			References		
	No.	By	Date	No.	By	Date	No.	By	Date	No.	By	Date	No.	By	Date	No.	By	Date

DEPARTMENT OF MINES
 BROUGHT TO DATE: 31 DEC 1984
 MINE MANAGER: *P. ...*
 MINE SURVEYOR: *J. ...*

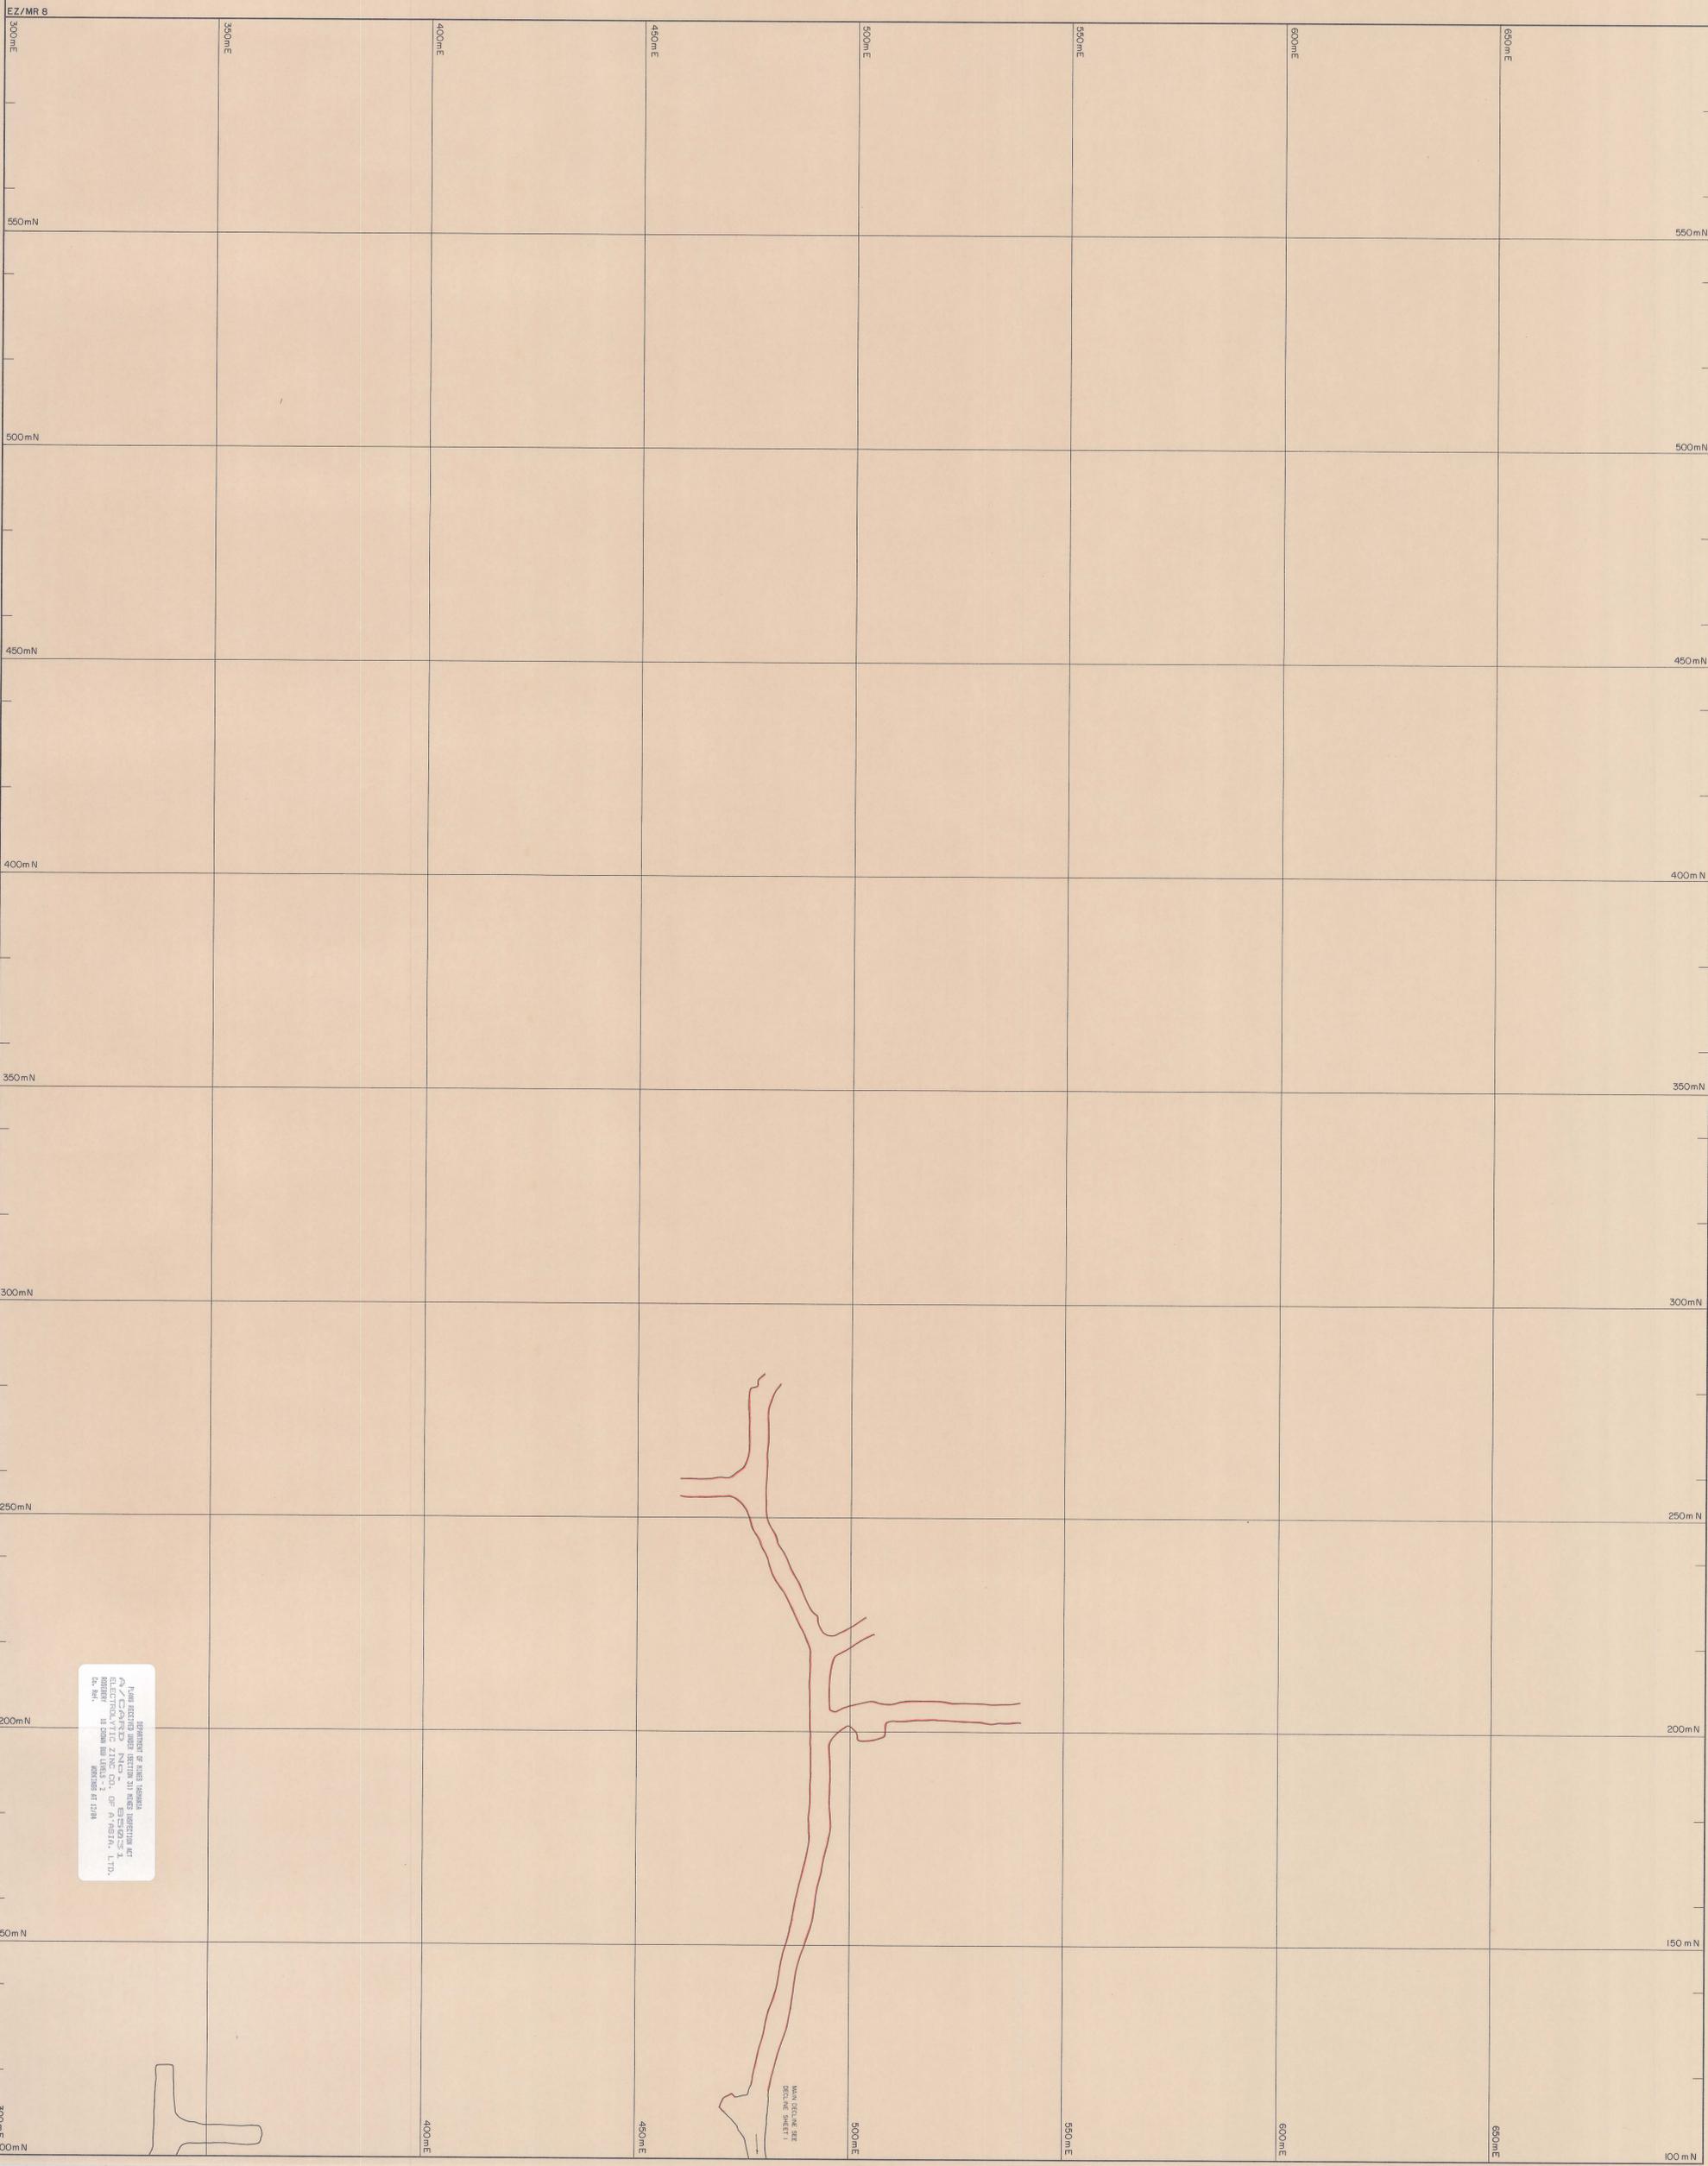

DEPARTMENT OF MINES
 12/86 SECTION 303A (SECTION 301) MINES REGULATIONS ACT
 ELECTROLYTIC ZINC CO. OF AUSTRALASIA LTD.
 ROSEBERY 18 CROWN SUB LEVELS - 2
 DRAWN BY G.M. BENNETT
 DATE 07/06/84

MAIN NORTH-SOUTH
 SECTION SHEET