


ELECTROLYTIC ZINC COMPANY OF AUSTRALASIA LIMITED

WEST COAST MINES

DEPT.

Drawn	By	Date
	G M Bennett	20-06-84
Traced		
Checked		
Approved		


ROSEBERY MINE
19 N° 2 SUB LEVEL

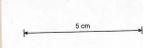

SCALE:	FILE:
DESIGN:	DRAWING No.
SURVEY:	1

Revisions	Details				References			
	No.	By	Date		No.	By	Date	

DEPARTMENT OF MINES
 BROUGHT TO DATE : 31 DEC 1984
 MINE MANAGER : *[Signature]*
 MINE SURVEYOR : *[Signature]*

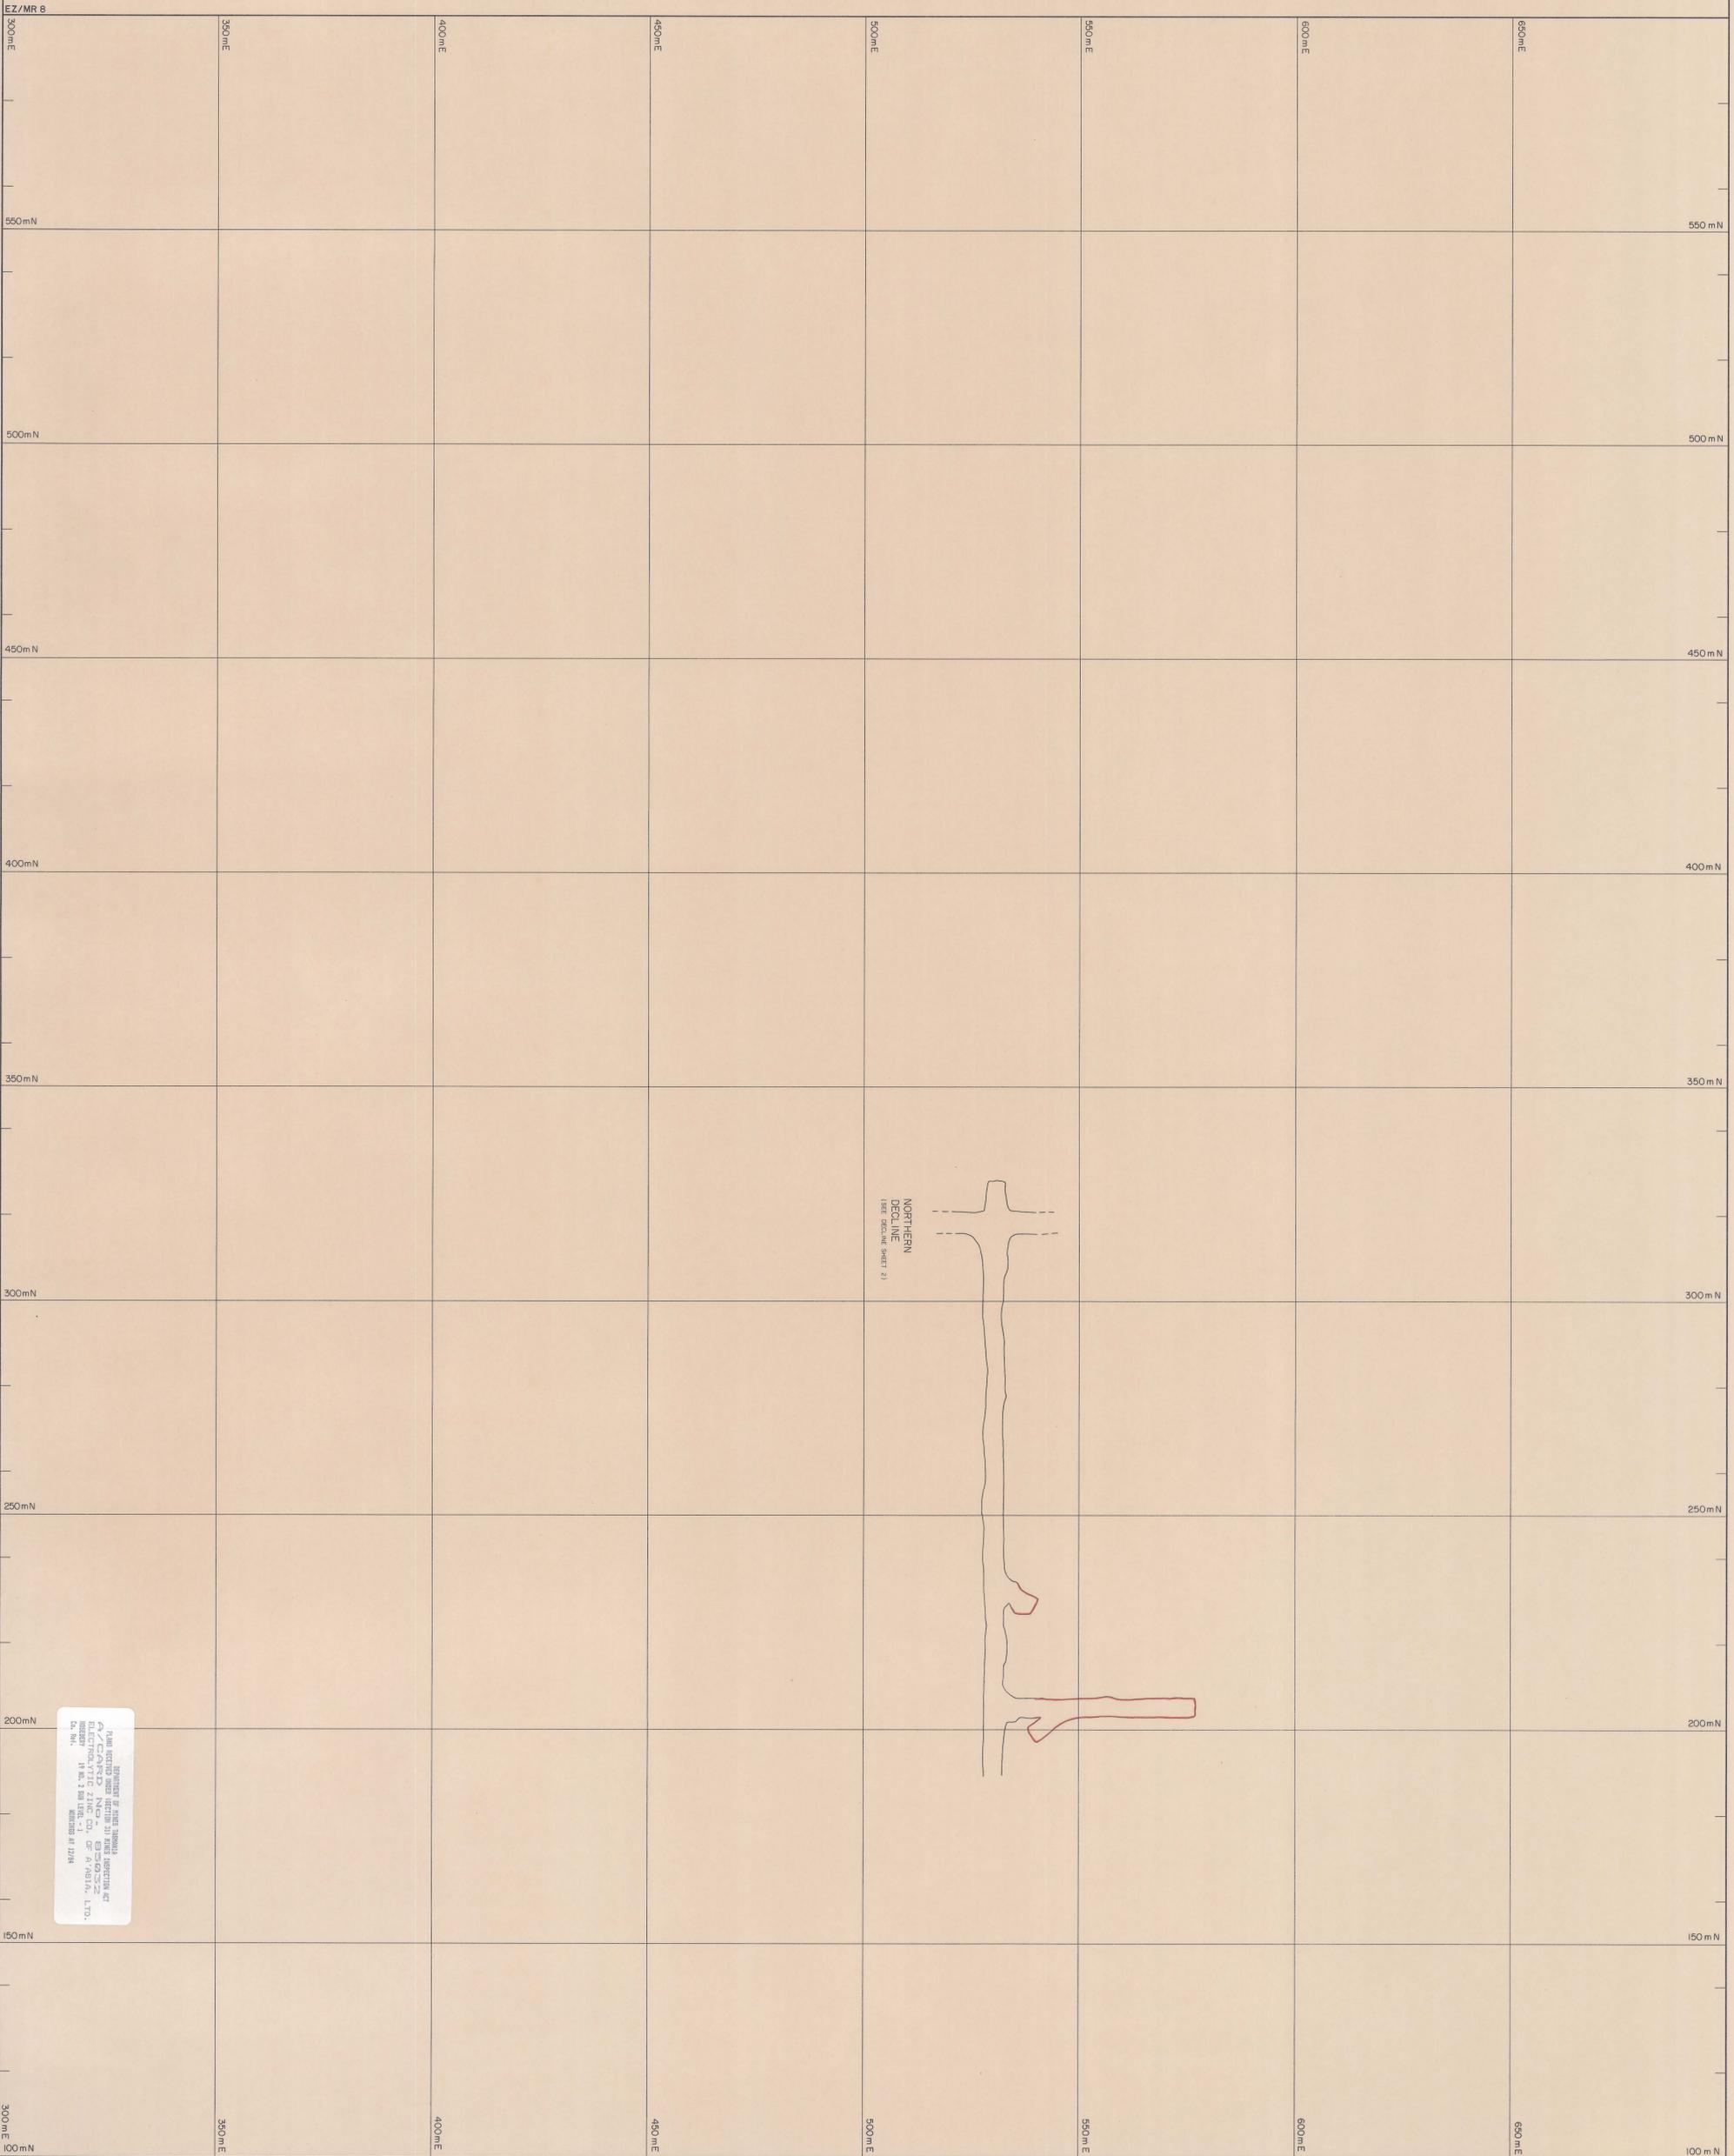

NORTHERN
DECLINE
1984 DEC 31

DEPARTMENT OF MINES
 A/CARD NO. 27
 ELECTROLYTIC ZINC CO. OF AUSTRALASIA LTD.
 11th Floor, 12th Street, Sydney, N.S.W.