

ELECTROLYTIC ZINC COMPANY OF AUSTRALASIA LIMITED

WEST COAST MINES

DEPT.

Drawn	G. M. Bennett	07.06.84
Traced		
Checked		
Approved		

ROSEBERY MINE


19 CROWN SUB LEVELS



SCALE:	FILE:
DESIGN:	DRAWING No.
SURVEY:	1

Revisions	No.			By			Date			Details			App.			References		
	No.	By	Date	No.	By	Date	No.	By	Date	No.	By	Date	No.	By	Date	No.	By	Date

DEPARTMENT OF MINES
 BROUGHT TO DATE : 31 DEC 1984
 MINE MANAGER : *P. Bennett*
 MINE SURVEYOR : *P. Bennett*

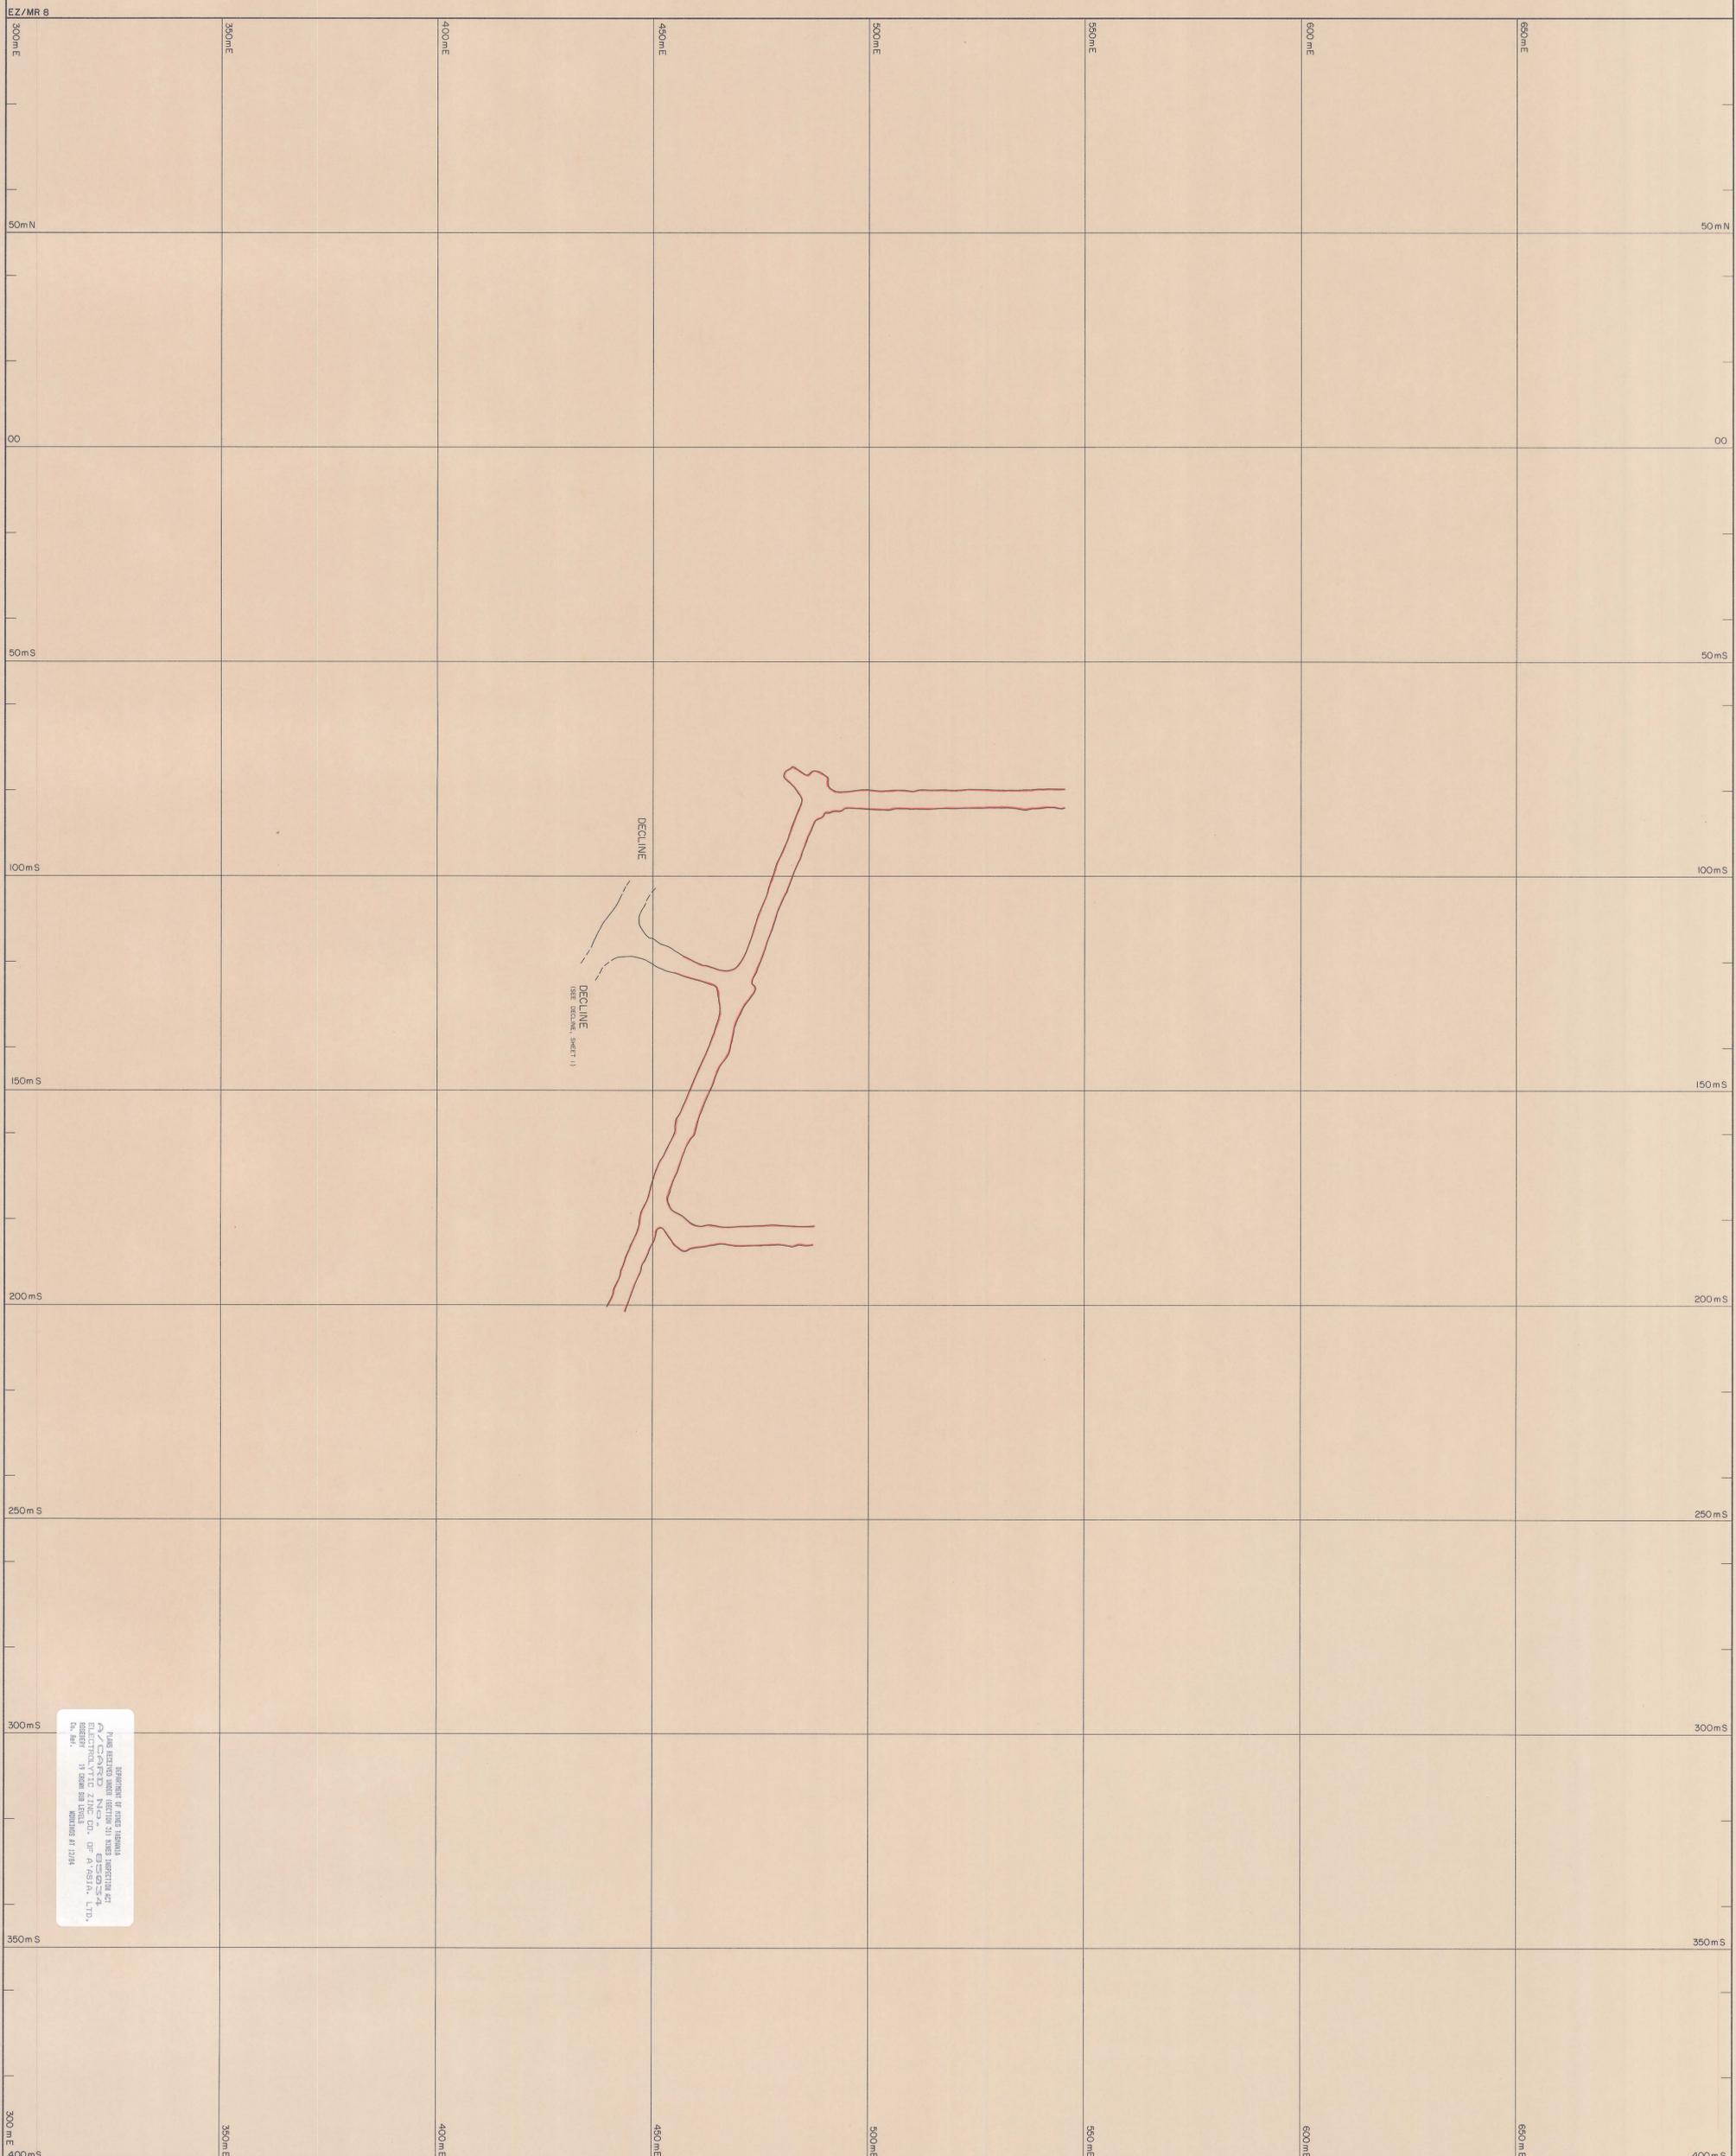

EZ/MR 8
 300mE
 50mN
 00
 50mS
 100mS
 150mS
 200mS
 250mS
 300mS
 350mS
 400mS
 300mE
 350mE
 400mE
 450mE
 500mE
 550mE
 600mE
 650mE

DEPARTMENT OF MINES
 19 CROWN SUB LEVELS
 ELECTROLYTIC ZINC CO. OF AUSTRALASIA LTD.
 11 DUNE STREET
 PERTH WESTERN AUSTRALIA 6150