



0055 - 14D

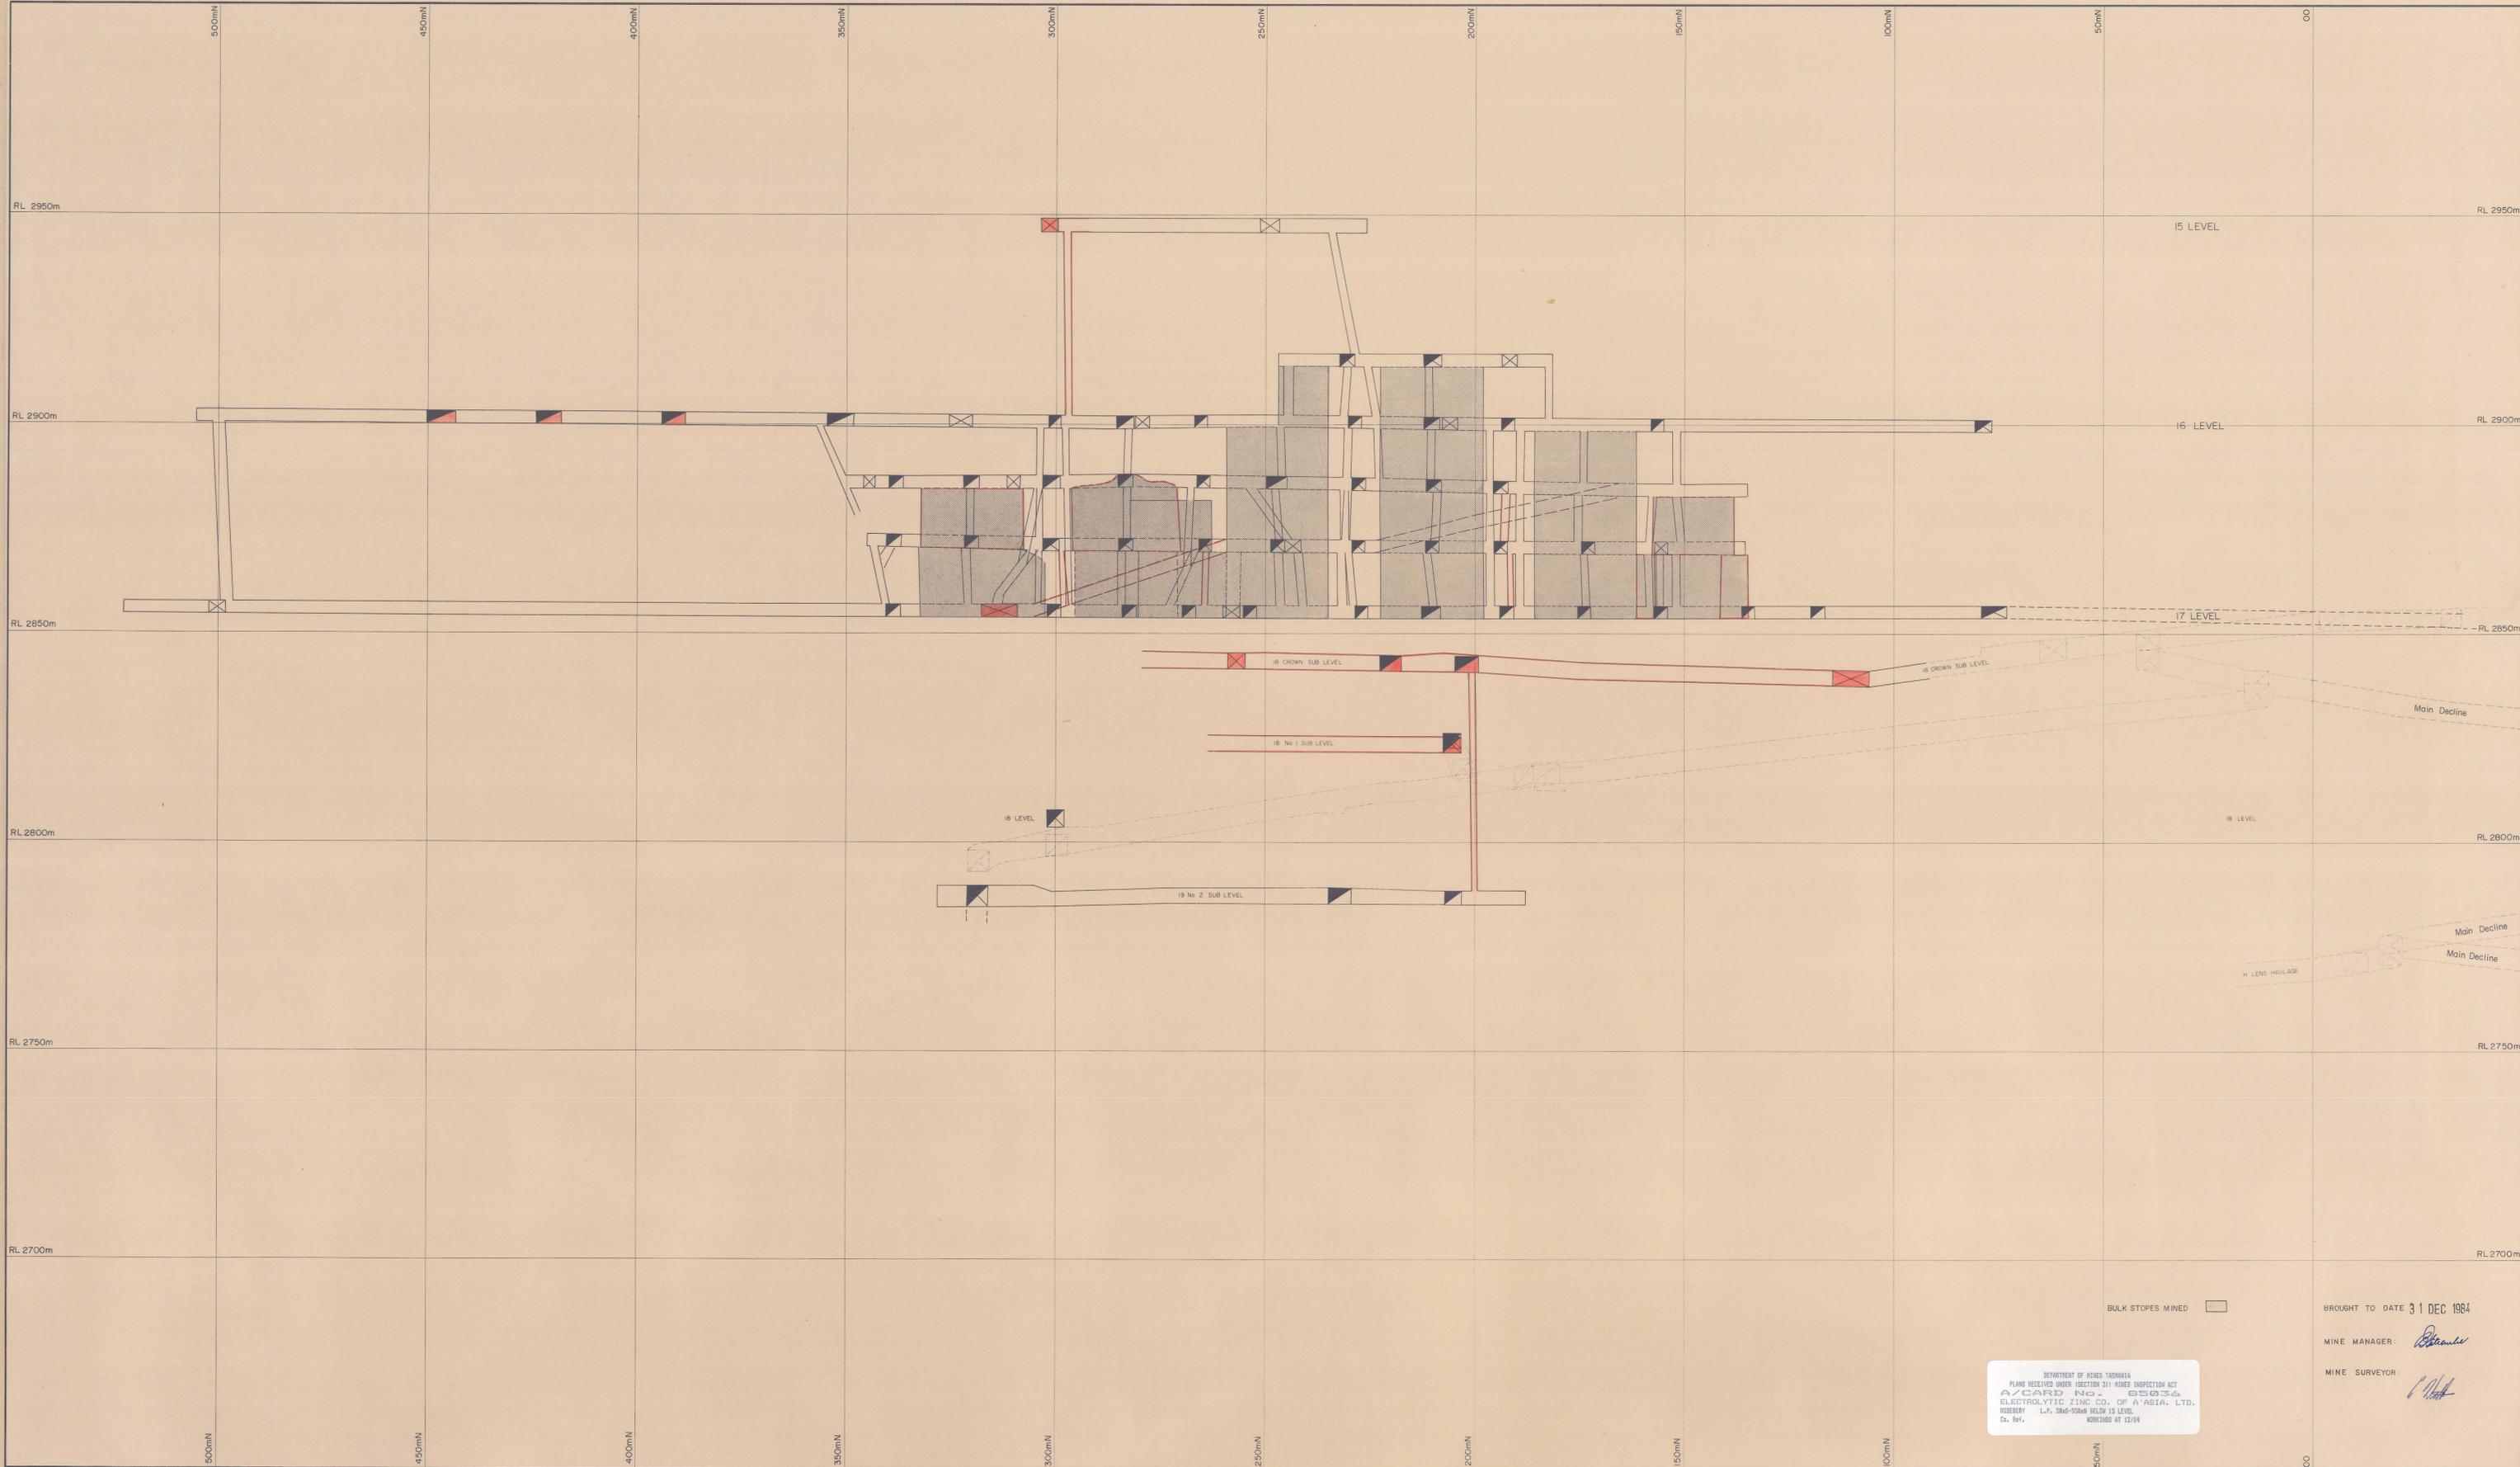

BULK STOPES MINED

BROUGHT TO DATE 31 DEC 1984
 MINE MANAGER: *[Signature]*
 MINE SURVEYOR: *[Signature]*

DEPARTMENT OF MINES TASMANIA
 PLANS RECEIVED UNDER (SECTION 31) MINES INSPECTION ACT
 A/CARD No. 6504
 ELECTROLYTIC ZINC CO. OF AUSTRALASIA, LTD.
 ROSEBERY L.P. 50mS-550mN BELOW 15 LEVEL
 Co. Ref. WORKINGS AT 12/84

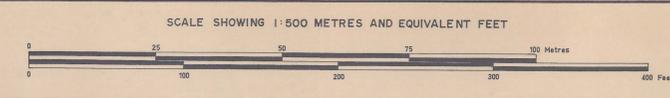

ELECTROLYTIC ZINC COMPANY OF AUSTRALASIA LIMITED
 WEST COAST MINES, T.A.S.

SURVEY BY		SCALE	1:500
DRAWN BY	A. G. MORRISON	DATE	19.01.79
TRACED BY	A.G.M.	REFERENCE	

ROSEBERY MINE
 LONGITUDINAL PROJECTION
 'H' LENS H/W STOPE
 50mS-550mN BELOW 15 LEVEL

DRAWING No:
 DEPARTMENT OF MINES