
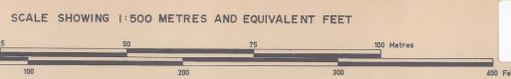


0055-141

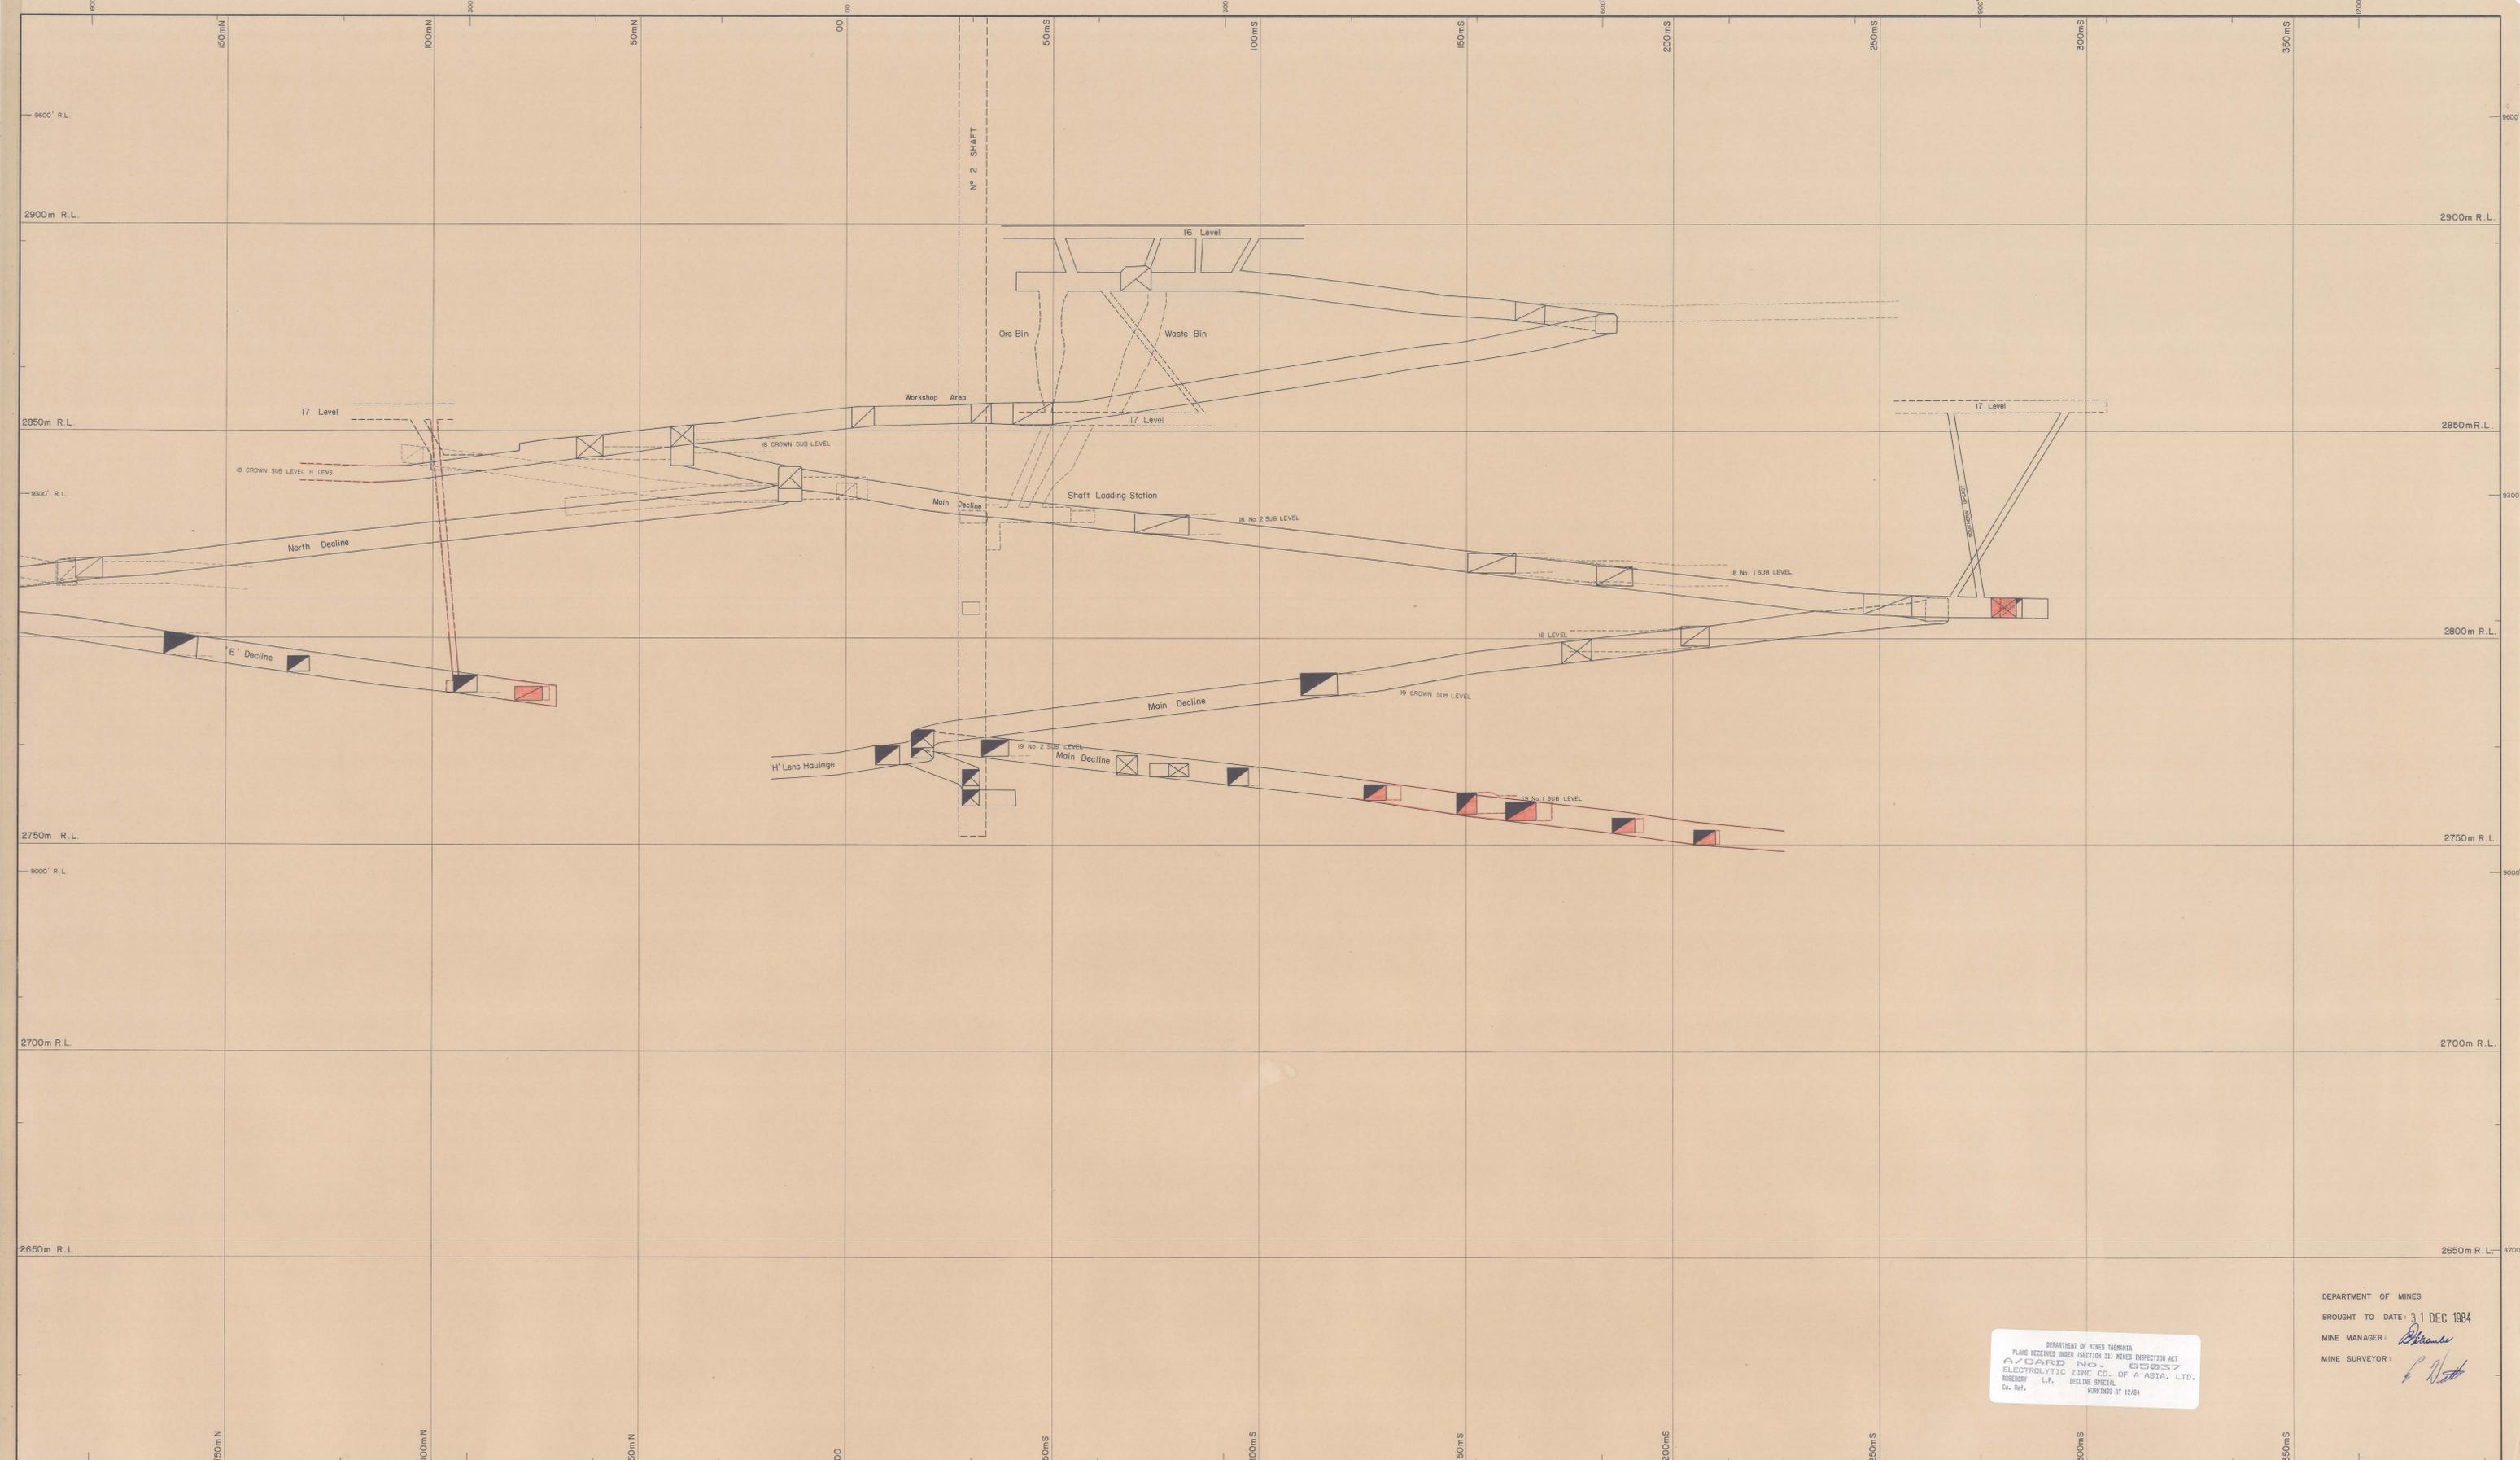

ELECTROLYTIC ZINC COMPANY OF AUSTRALASIA LIMITED
WEST COAST MINES, T.A.S.

SURVEY BY		SCALE	1:500
DRAWN BY	K. CAREY.	DATE	19-05-80
TRACED BY	A. G. MORRISON	REFERENCE	

ROSEBERY MINE
LONGITUDINAL PROJECTION
DECLINE SPECIAL

DRAWING NO.:
DEPARTMENT OF MINES

DEPARTMENT OF MINES TASMANIA
PLANS RECEIVED UNDER SECTION 33(1) MINES INSPECTION ACT
A/CARD NO. 85037
ELECTROLYTIC ZINC CO. OF AUSTRALASIA, LTD.
ROSEBERY L.P. DECLINE SPECIAL
Co. Ref. WORKINGS AT 12/81

DEPARTMENT OF MINES
BROUGHT TO DATE: 31 DEC 1984
MINE MANAGER: *[Signature]*
MINE SURVEYOR: *[Signature]*