

ELECTROLYTIC ZINC COMPANY OF AUSTRALASIA LIMITED

WEST COAST MINES

DEPT.

| | | |
|----------|----------|----------|
| Drawn | By | Date |
| | P. J. S. | 29 05 84 |
| Traced | | |
| Checked | | |
| Approved | | |


ROSEBERY MINE
LONGITUDINAL PROJECTION
400mS to 100mN - BELOW 17 LEVEL



| | |
|--------------|-------------|
| SCALE: 1:500 | FILE: |
| DESIGN: | DRAWING No. |
| SURVEY: | No. |

| Revisions | No. | | | By | | | Date | | | Details | | | App. | | | References | | |
|-----------|-----|----|------|-----|----|------|------|----|------|---------|----|------|------|----|------|------------|----|------|
| | No. | By | Date | No. | By | Date | No. | By | Date | No. | By | Date | No. | By | Date | No. | By | Date |
| | | | | | | | | | | | | | | | | | | |
| | | | | | | | | | | | | | | | | | | |
| | | | | | | | | | | | | | | | | | | |

DEPARTMENT OF MINES
BROUGHT TO DATE: 31 DEC 1984
MINE MANAGER: *[Signature]*
MINE SURVEYOR: *[Signature]*

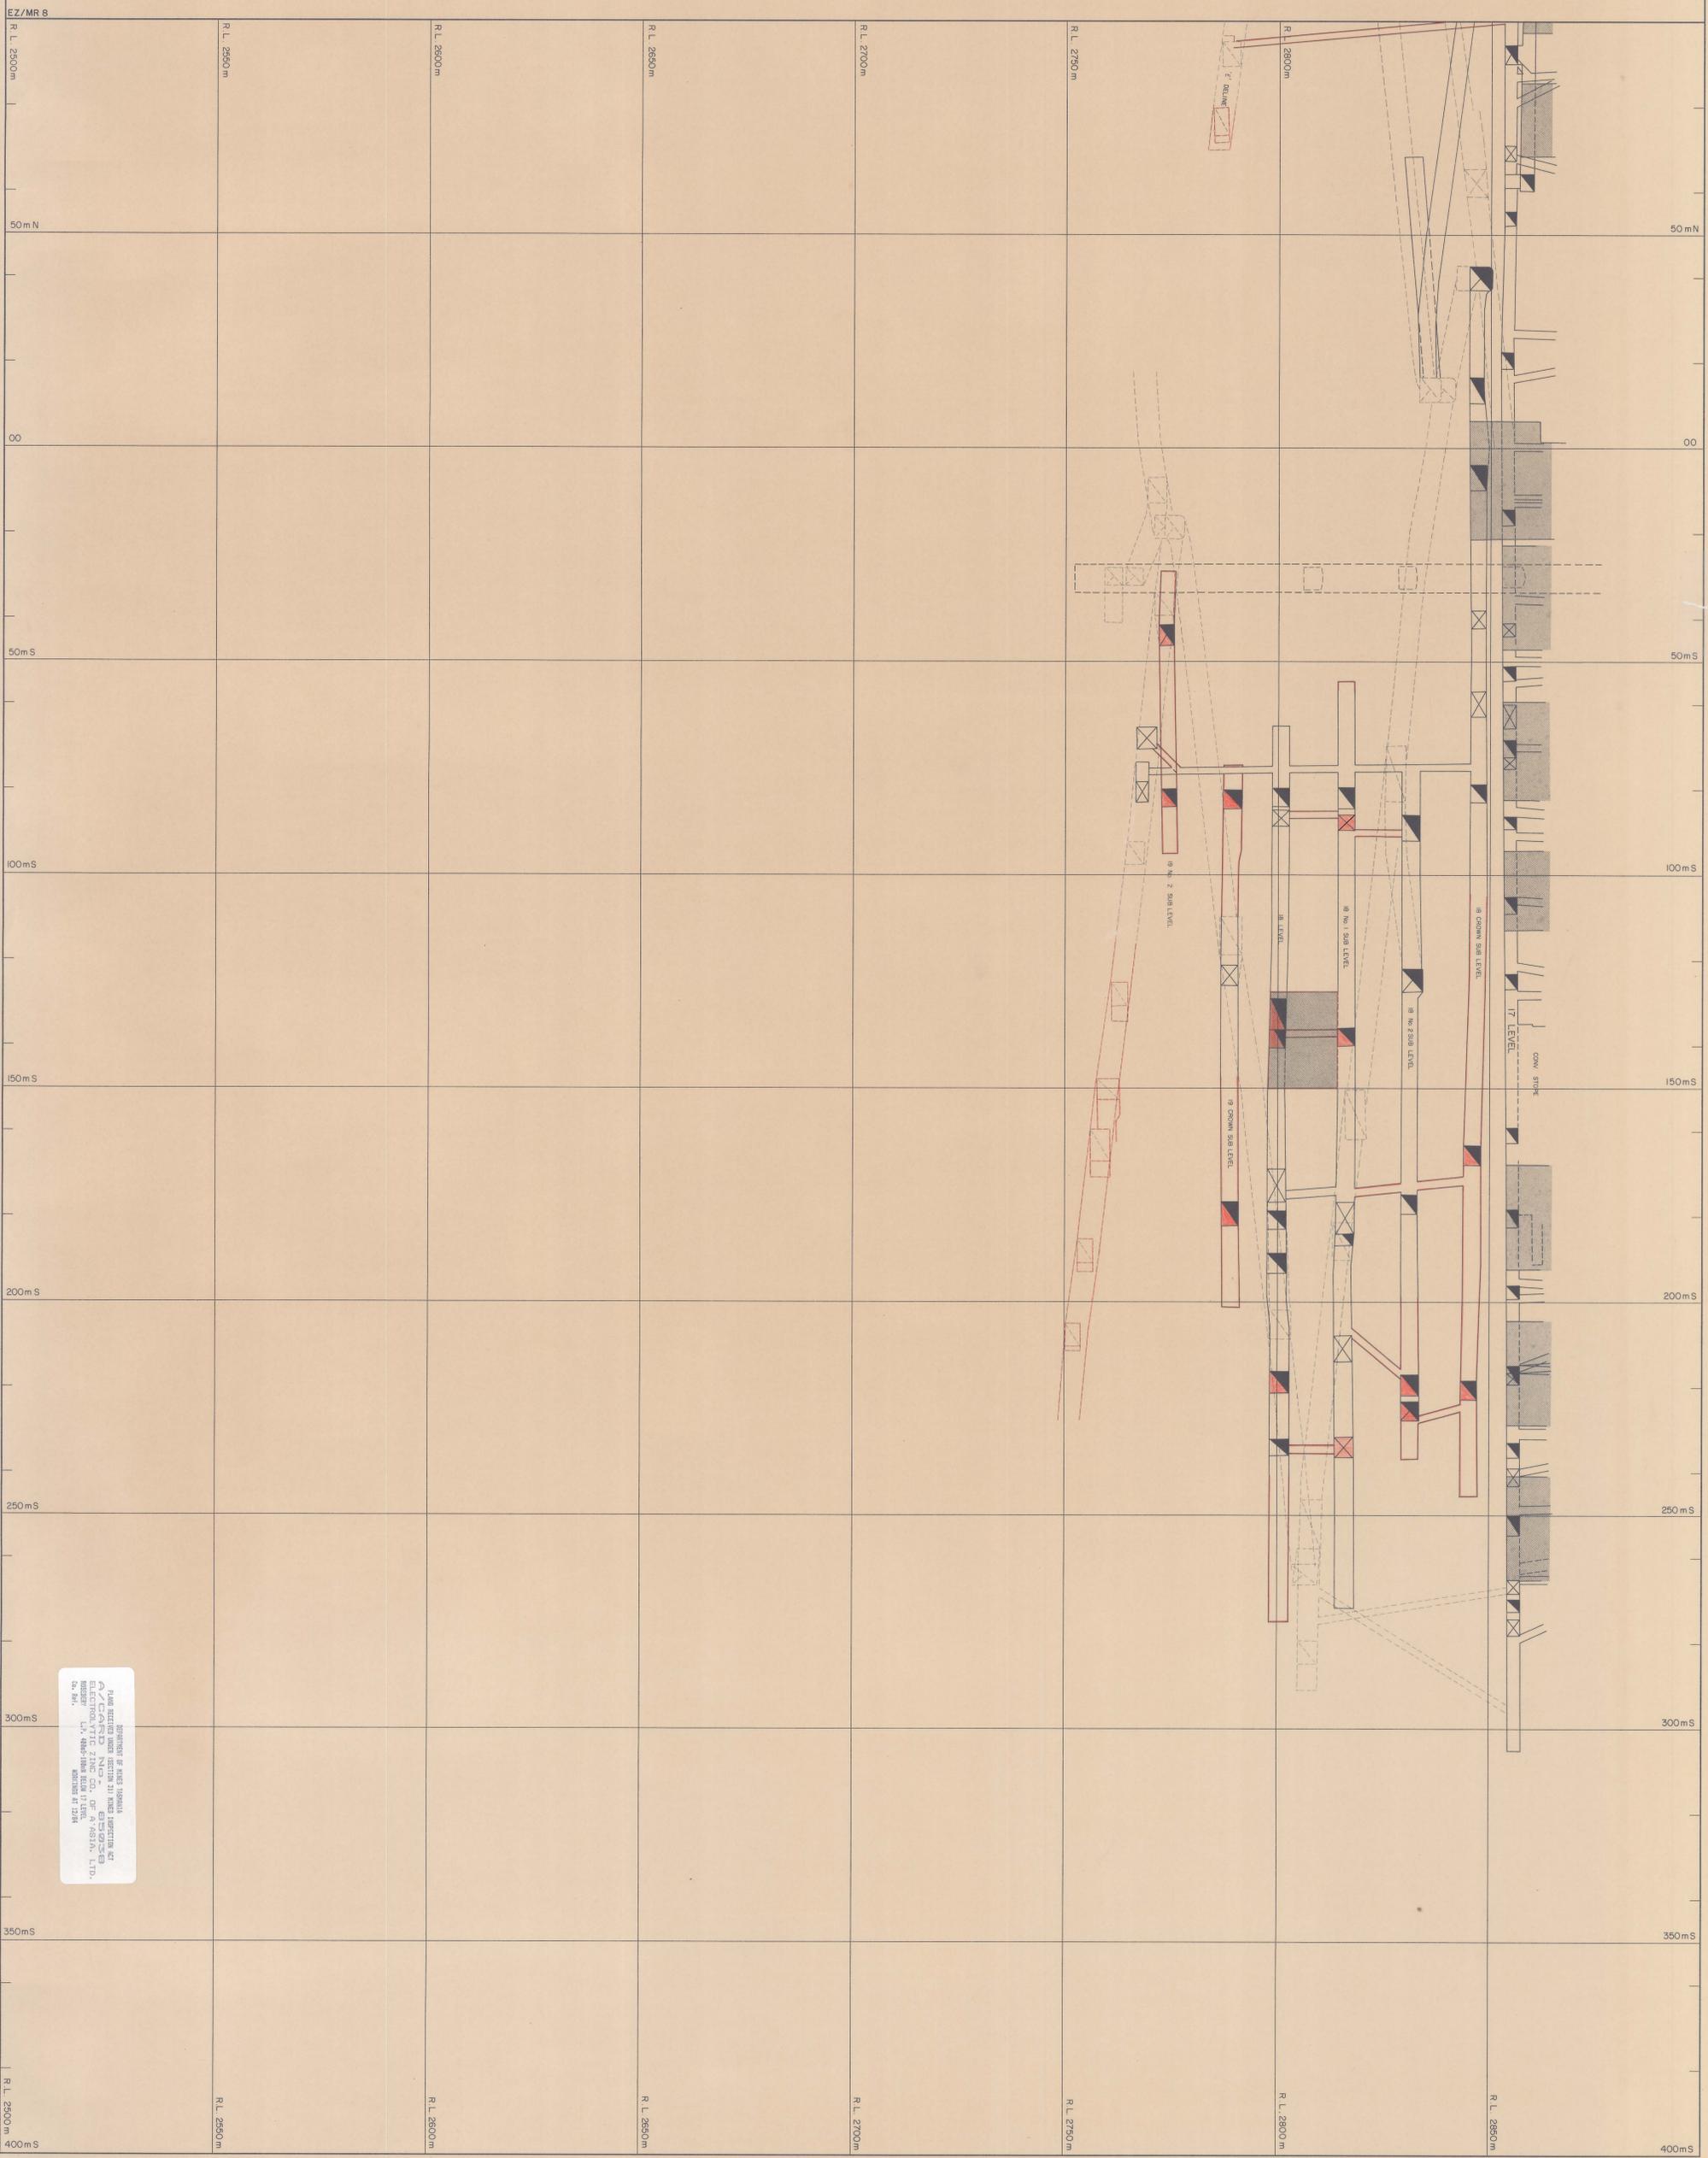

ROSEBERY MINE
LONGITUDINAL PROJECTION
ELECTROLYTIC ZINC CO. OF AUSTRALASIA LTD.
MINE SURVEYOR: *[Signature]*
DATE: 31 DEC 1984