



0055-145

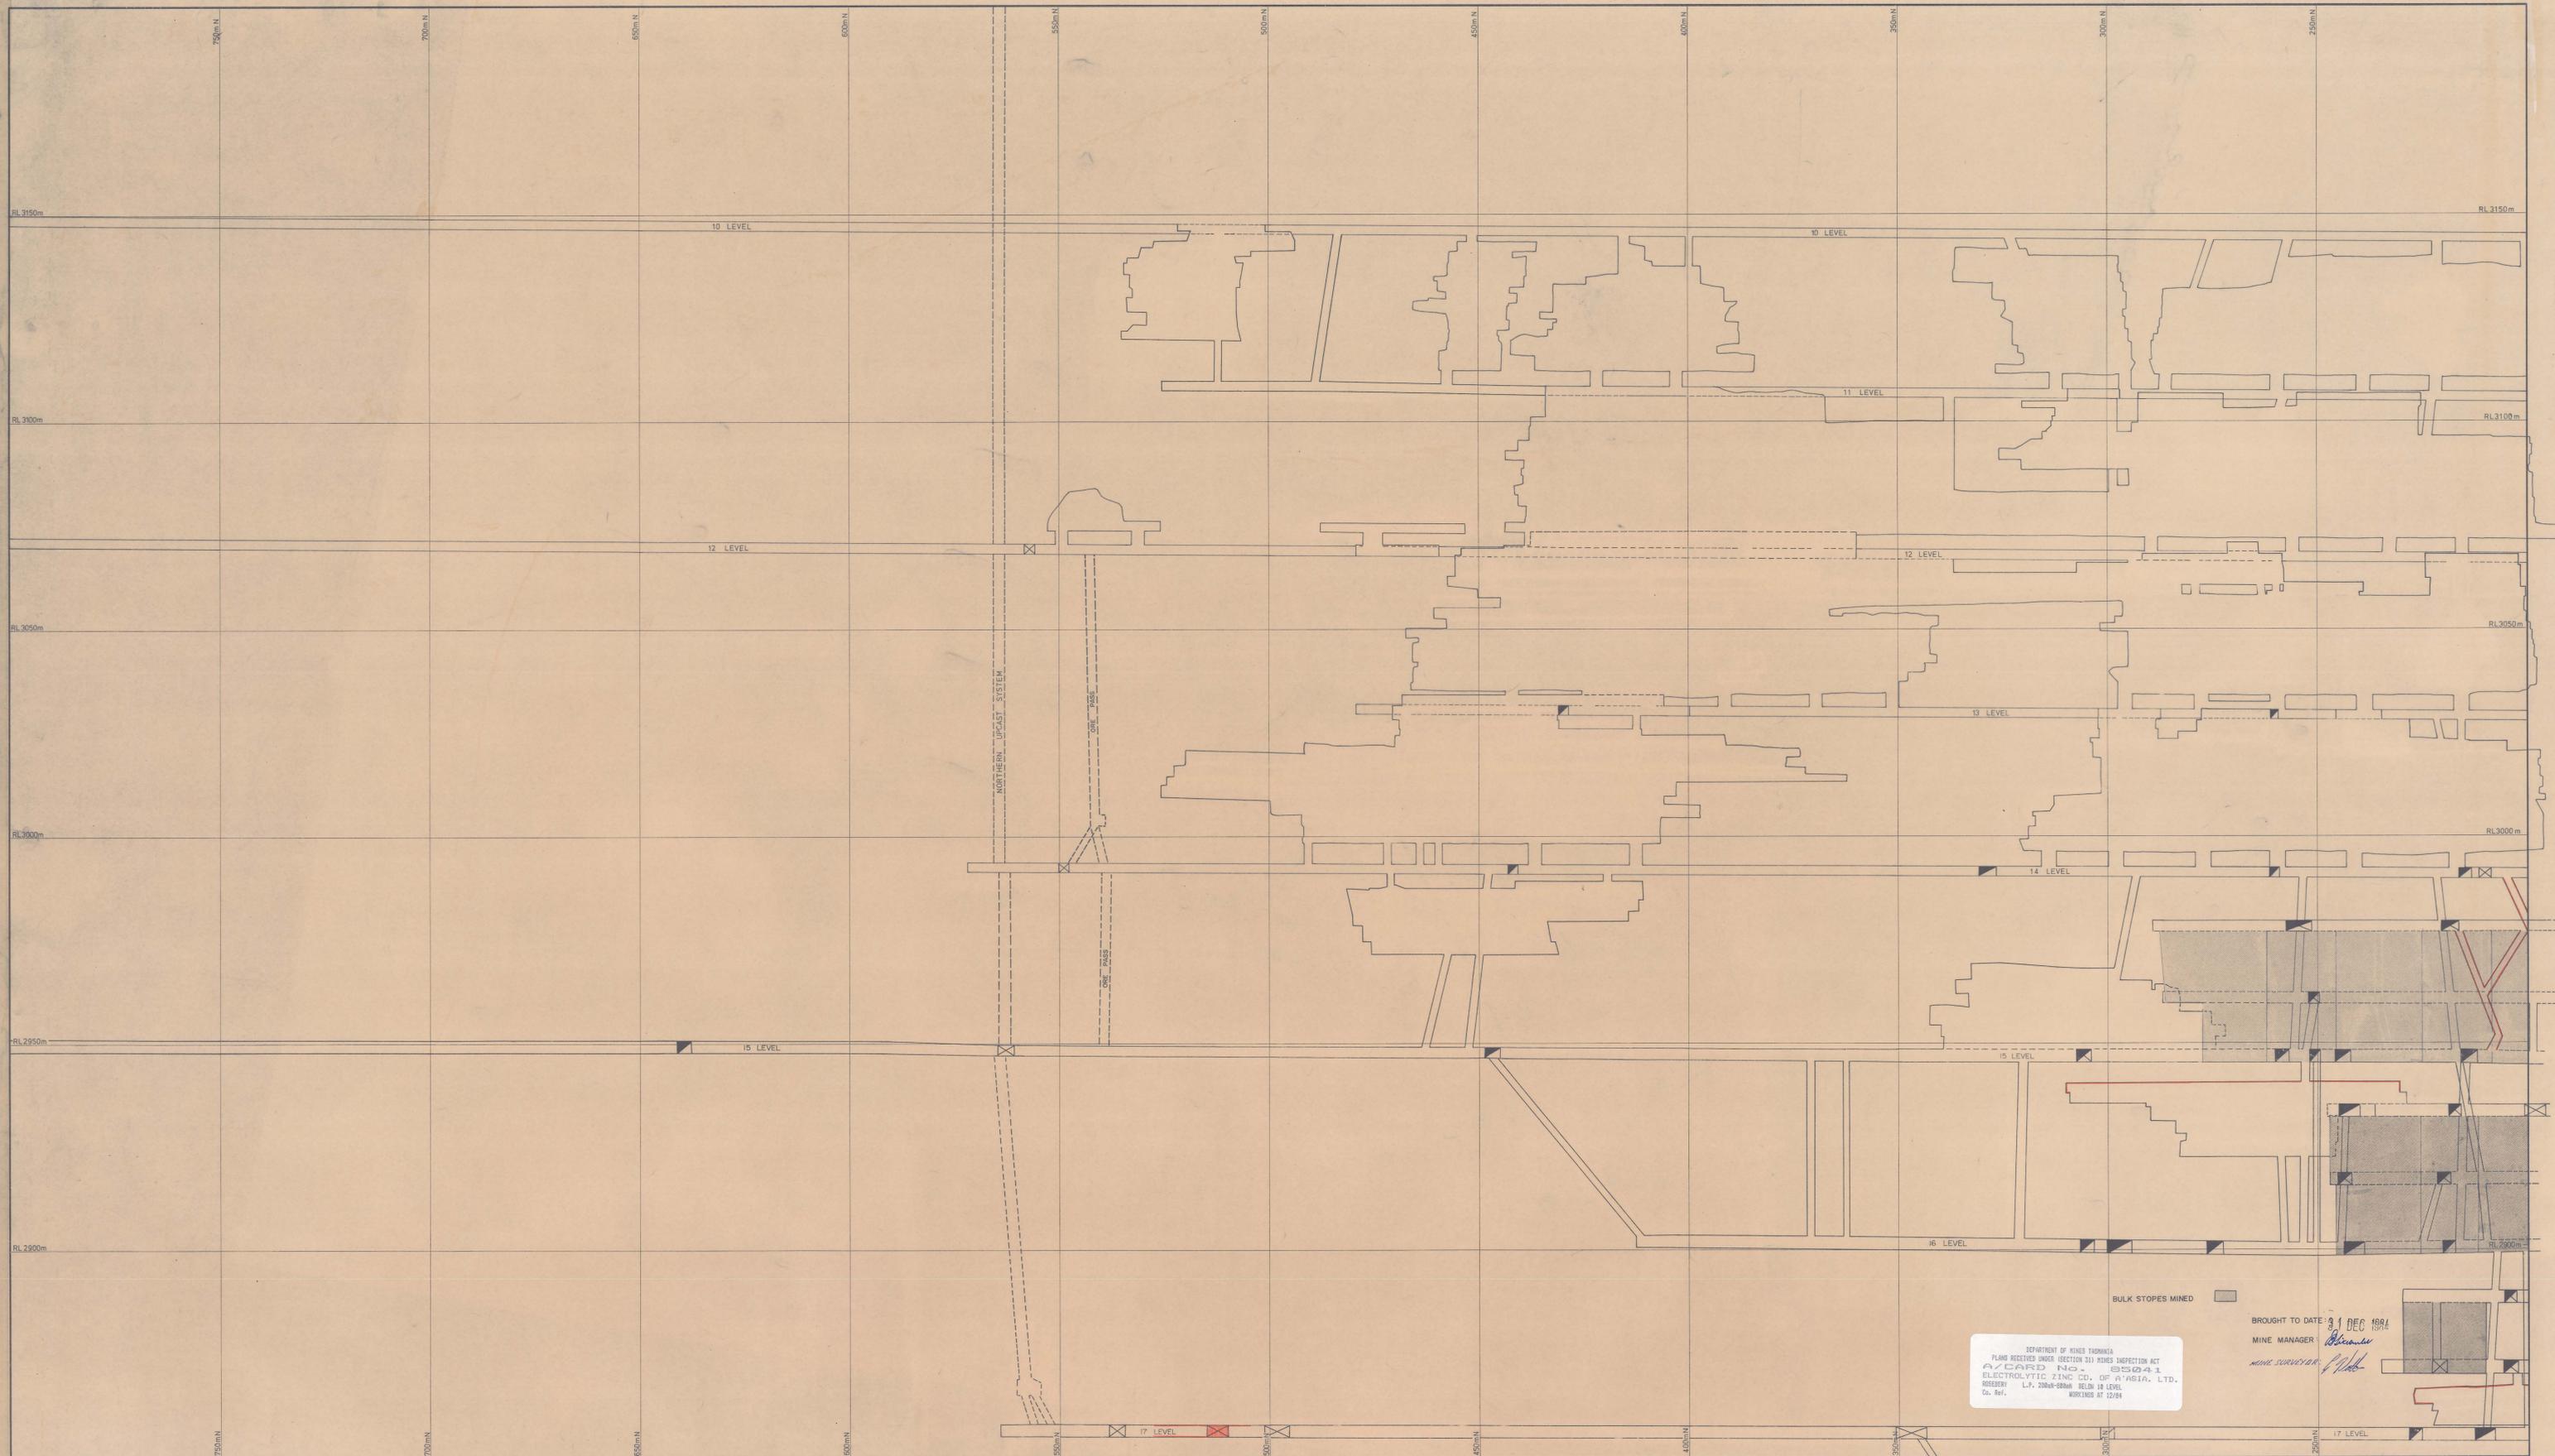

DEPARTMENT OF MINES TASMANIA  
 PLANS RECEIVED UNDER SECTION 31(1) MINES INSPECTION ACT  
 A/CARD No. 8524-1  
 ELECTROLYTIC ZINC CO. OF AUSTRALIA, LTD.  
 ROSEBERY L.P. 200m-800m BELOW 10 LEVEL  
 Co. Ref. WORKING AT 12/86

BROUGHT TO DATE: 31 DEC 1984  
 MINE MANAGER: *[Signature]*  
 MINE SURVEYOR: *[Signature]*

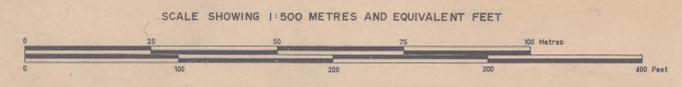

ELECTROLYTIC ZINC COMPANY OF AUSTRALASIA LIMITED  
 WEST COAST MINES, TAS.

SURVEY BY		SCALE	1 : 500
DRAWN BY		DATE	1973
TRACED BY	P.J. Lowe	REFERENCE	

ROSEBERY MINE  
 LONGITUDINAL PROJECTION  
 200mN - 800mN - BELOW 10/L.

DRAWING No: \_\_\_\_\_  
 DEPARTMENT OF MINES