


0055-146

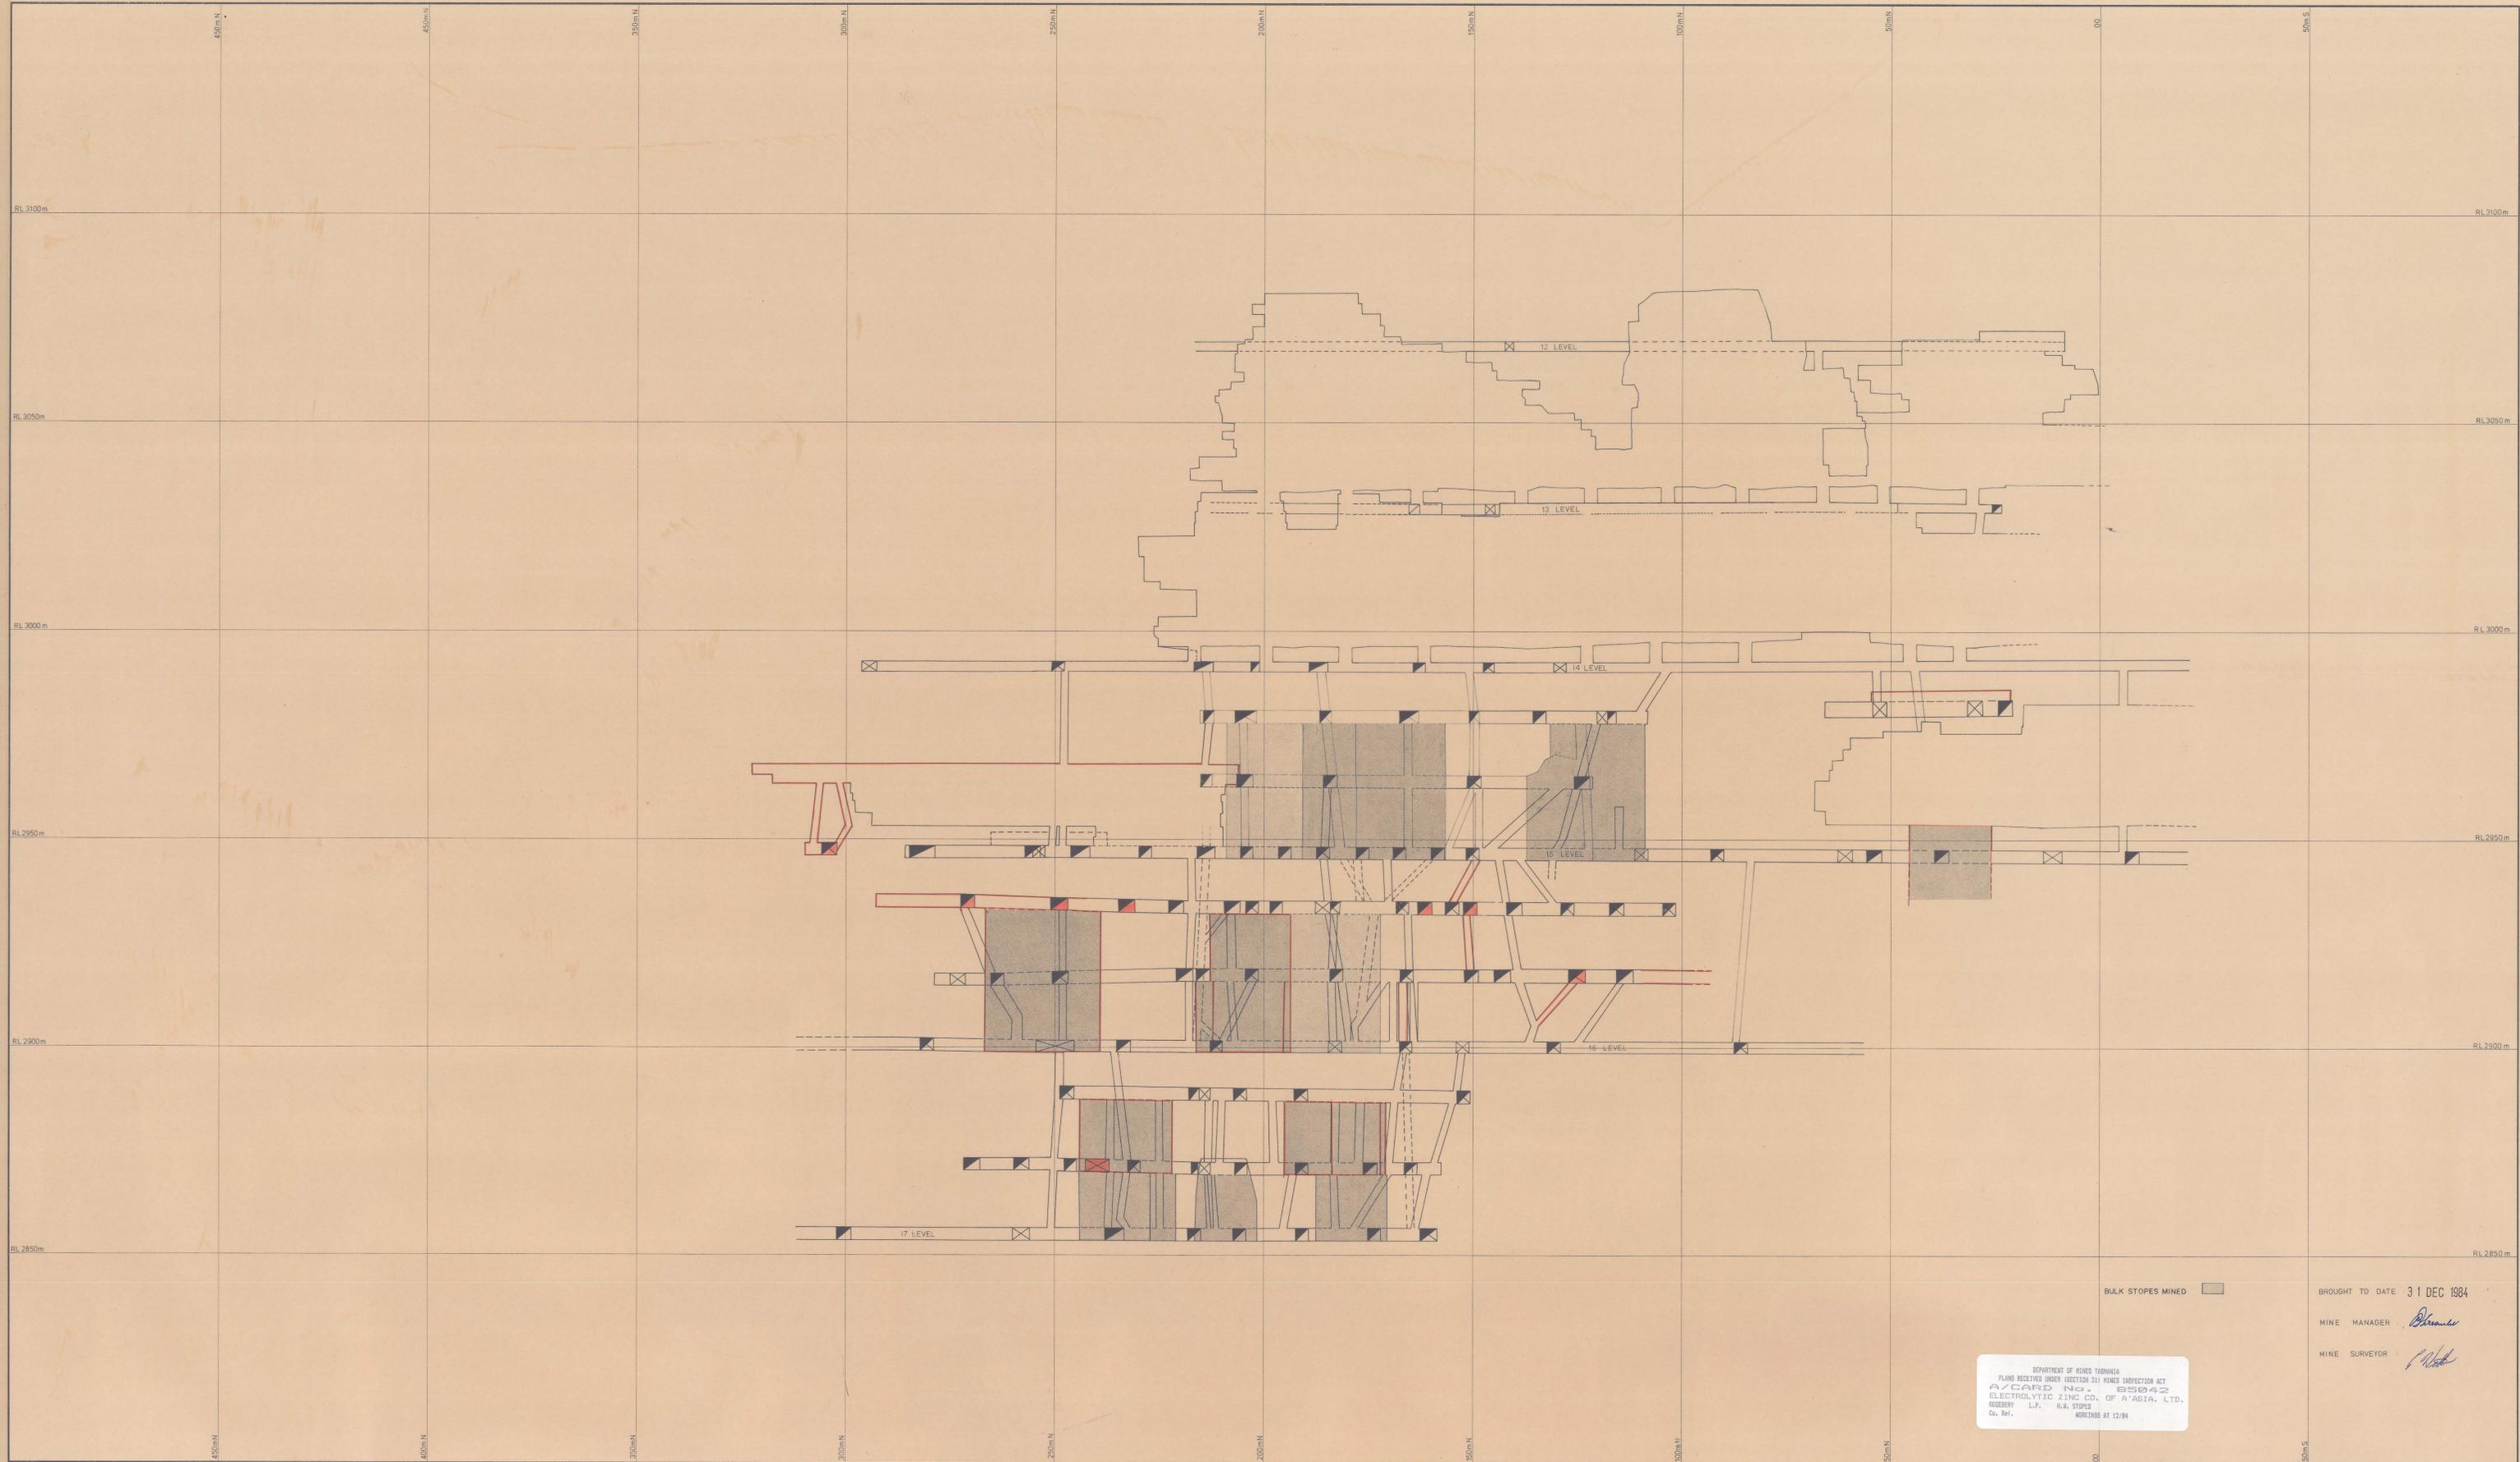


BULK STOPES MINED

BROUGHT TO DATE 31 DEC 1984

MINE MANAGER *[Signature]*

MINE SURVEYOR *[Signature]*

DEPARTMENT OF MINES TASMANIA  
 PLANS RECEIVED UNDER SECTION 21 MINES INSPECTION ACT  
 ELECTROLYTIC ZINC CO. OF AUSTRALASIA LTD.  
 ROSEBERY L.F. H.W. STOPES  
 Co. Ref. WORKINGS AT 12/84

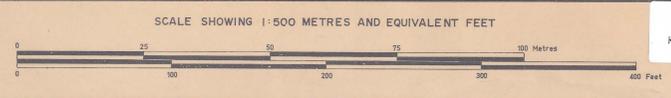

ELECTROLYTIC ZINC COMPANY OF AUSTRALASIA LIMITED  
 WEST COAST MINES, TAS.

SURVEY BY		SCALE	1 : 500
DRAWN BY		DATE	1973
TRACED BY	P.J. Lowe	REFERENCE	

ROSEBERY MINE  
 LONGITUDINAL PROJECTION  
 H.W. STOPES

DRAWING NO:   
 DEPARTMENT OF MINES