

0055-161

PASMINCO MINING - Rosebery

A.C.N. 004 074 962

By	Date
Drawn	05-DEC-91
Traced	
Checked	
Approved	

ROSEBERY MINE

20 LEVEL

J LENS



SCALE: 1:500

FILE:

DESIGN:

DRAWING No.

SURVEY:

No


Revisions	Details			App.			References		
	No	By	Date	No	By	Date	No	By	Date

DEPARTMENT OF MINES

BOUGHT TO DATE: 31 DEC 1993

MINE MANAGER: *Banning*

MINE SURVEYOR: *[Signature]*

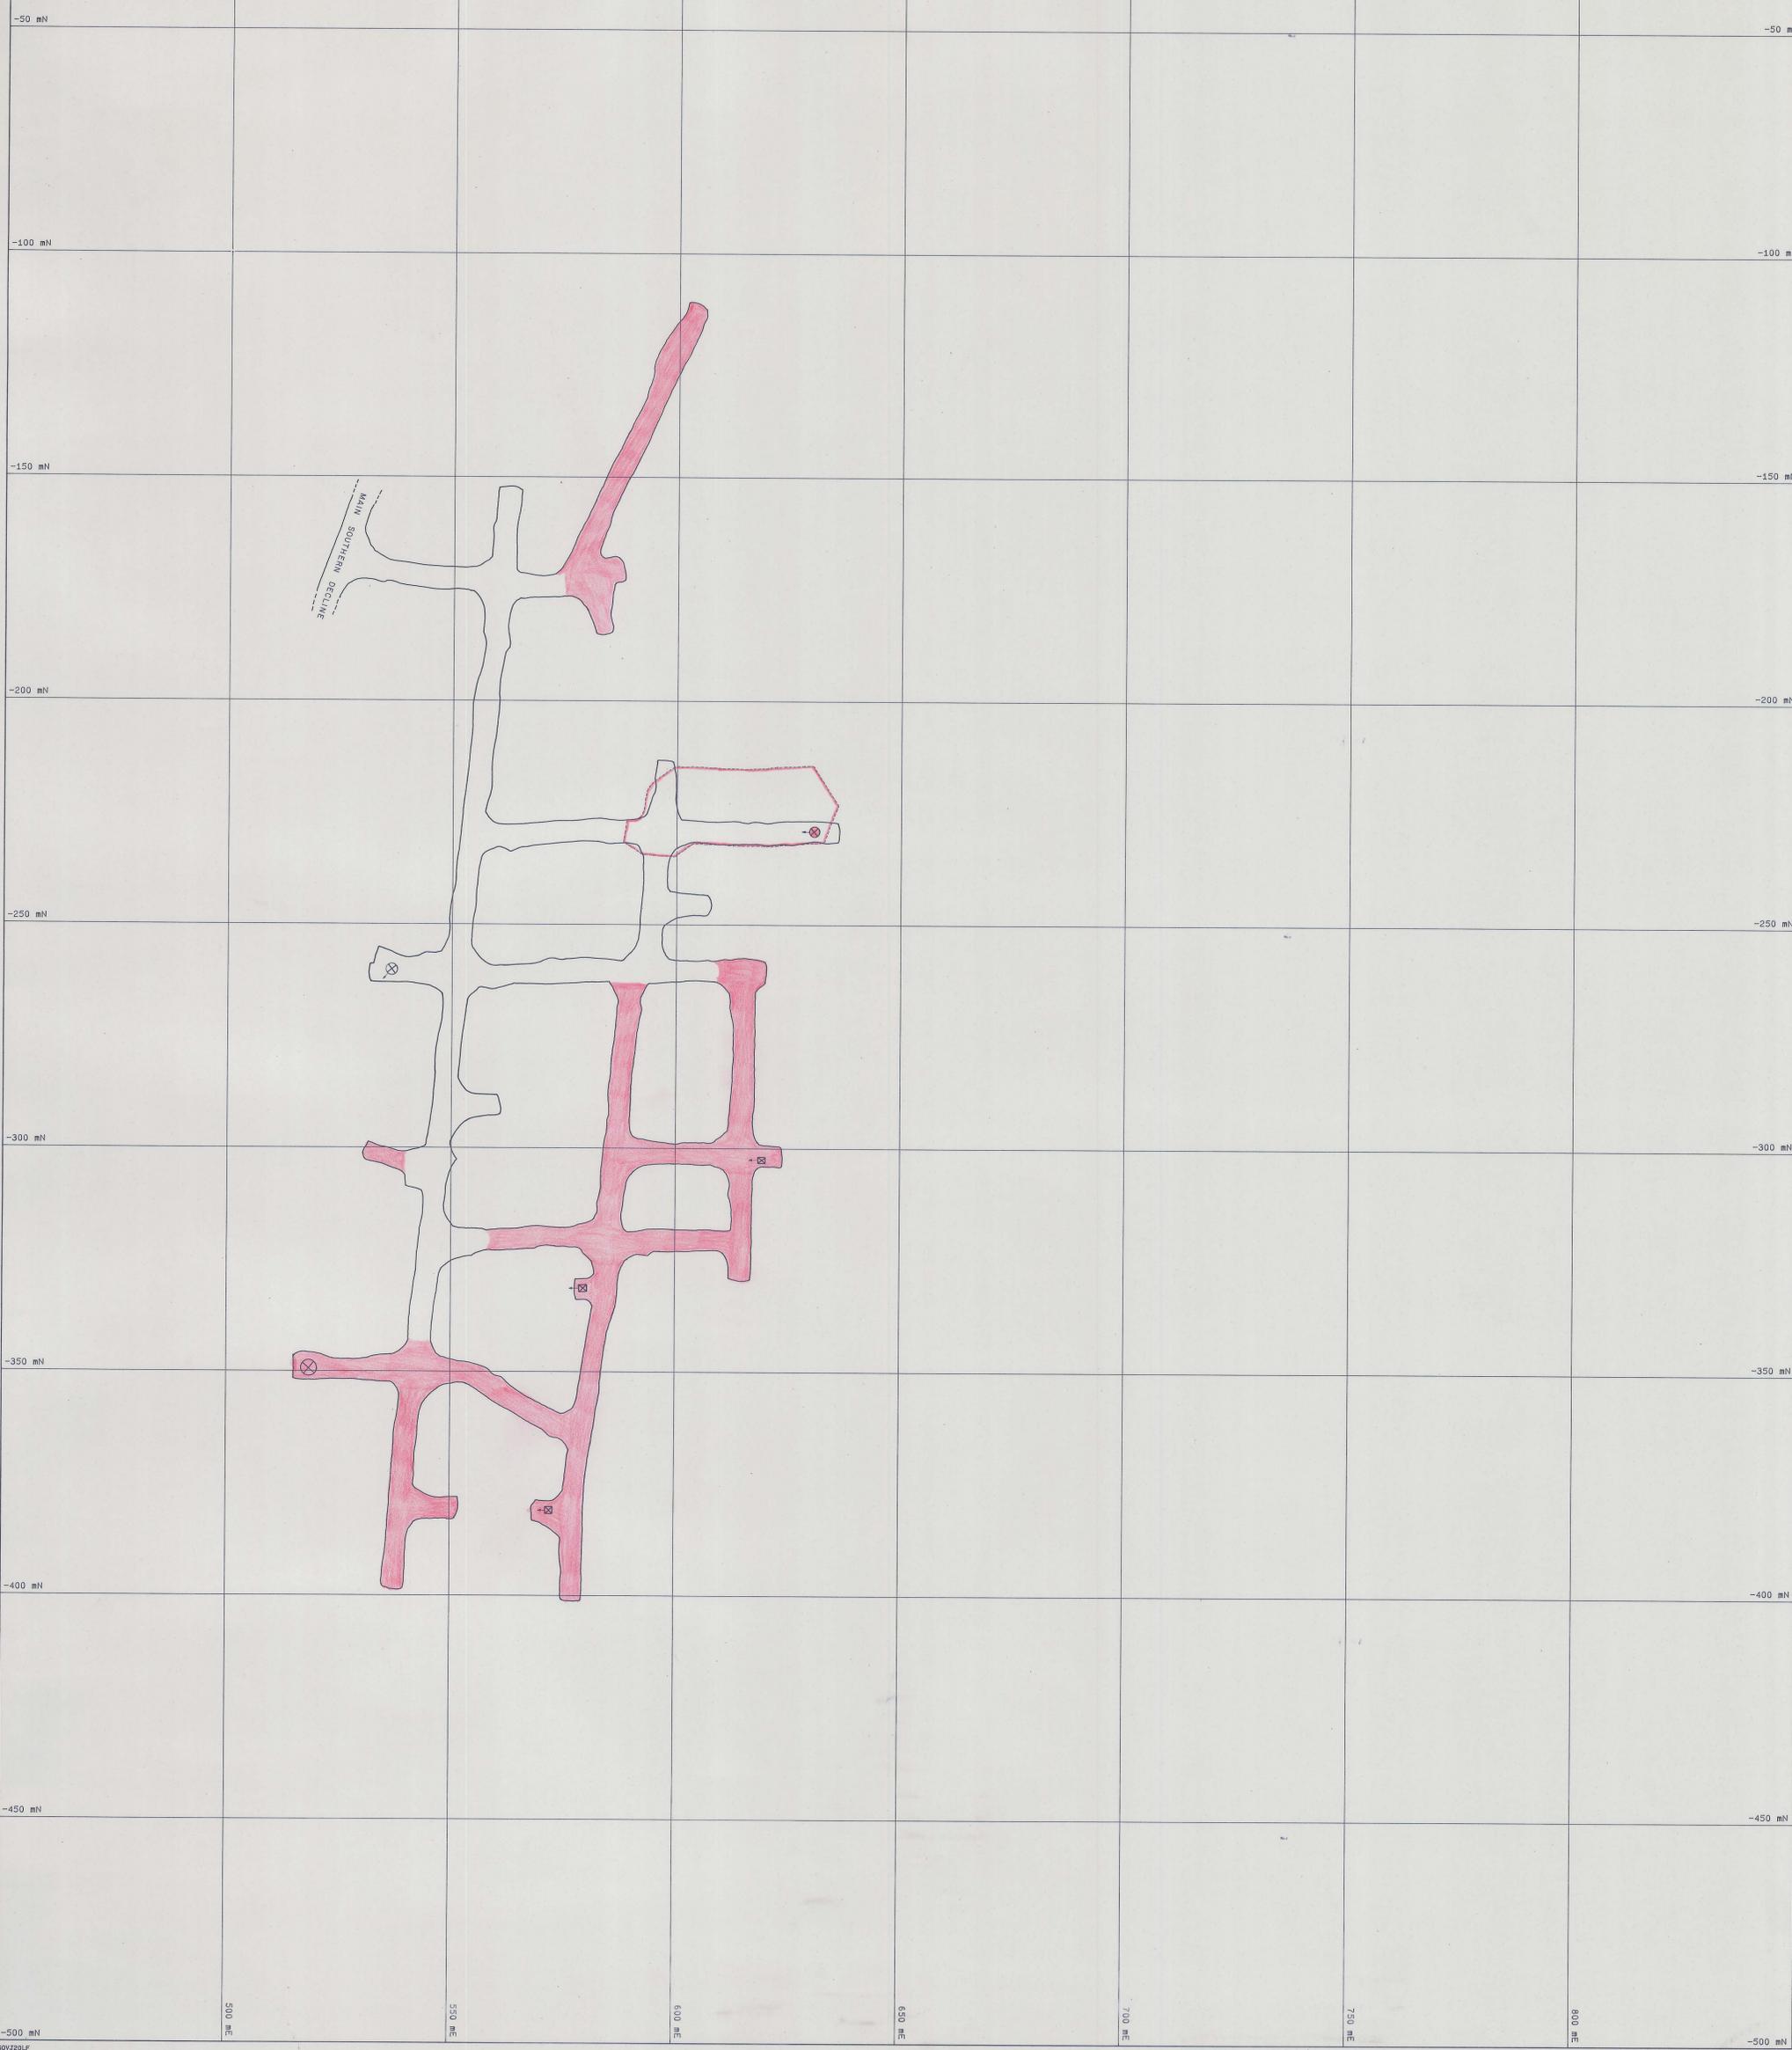

1:1142(10) M. HUBER RELEASE SOUTH DYKES - DYKES