


0055-162

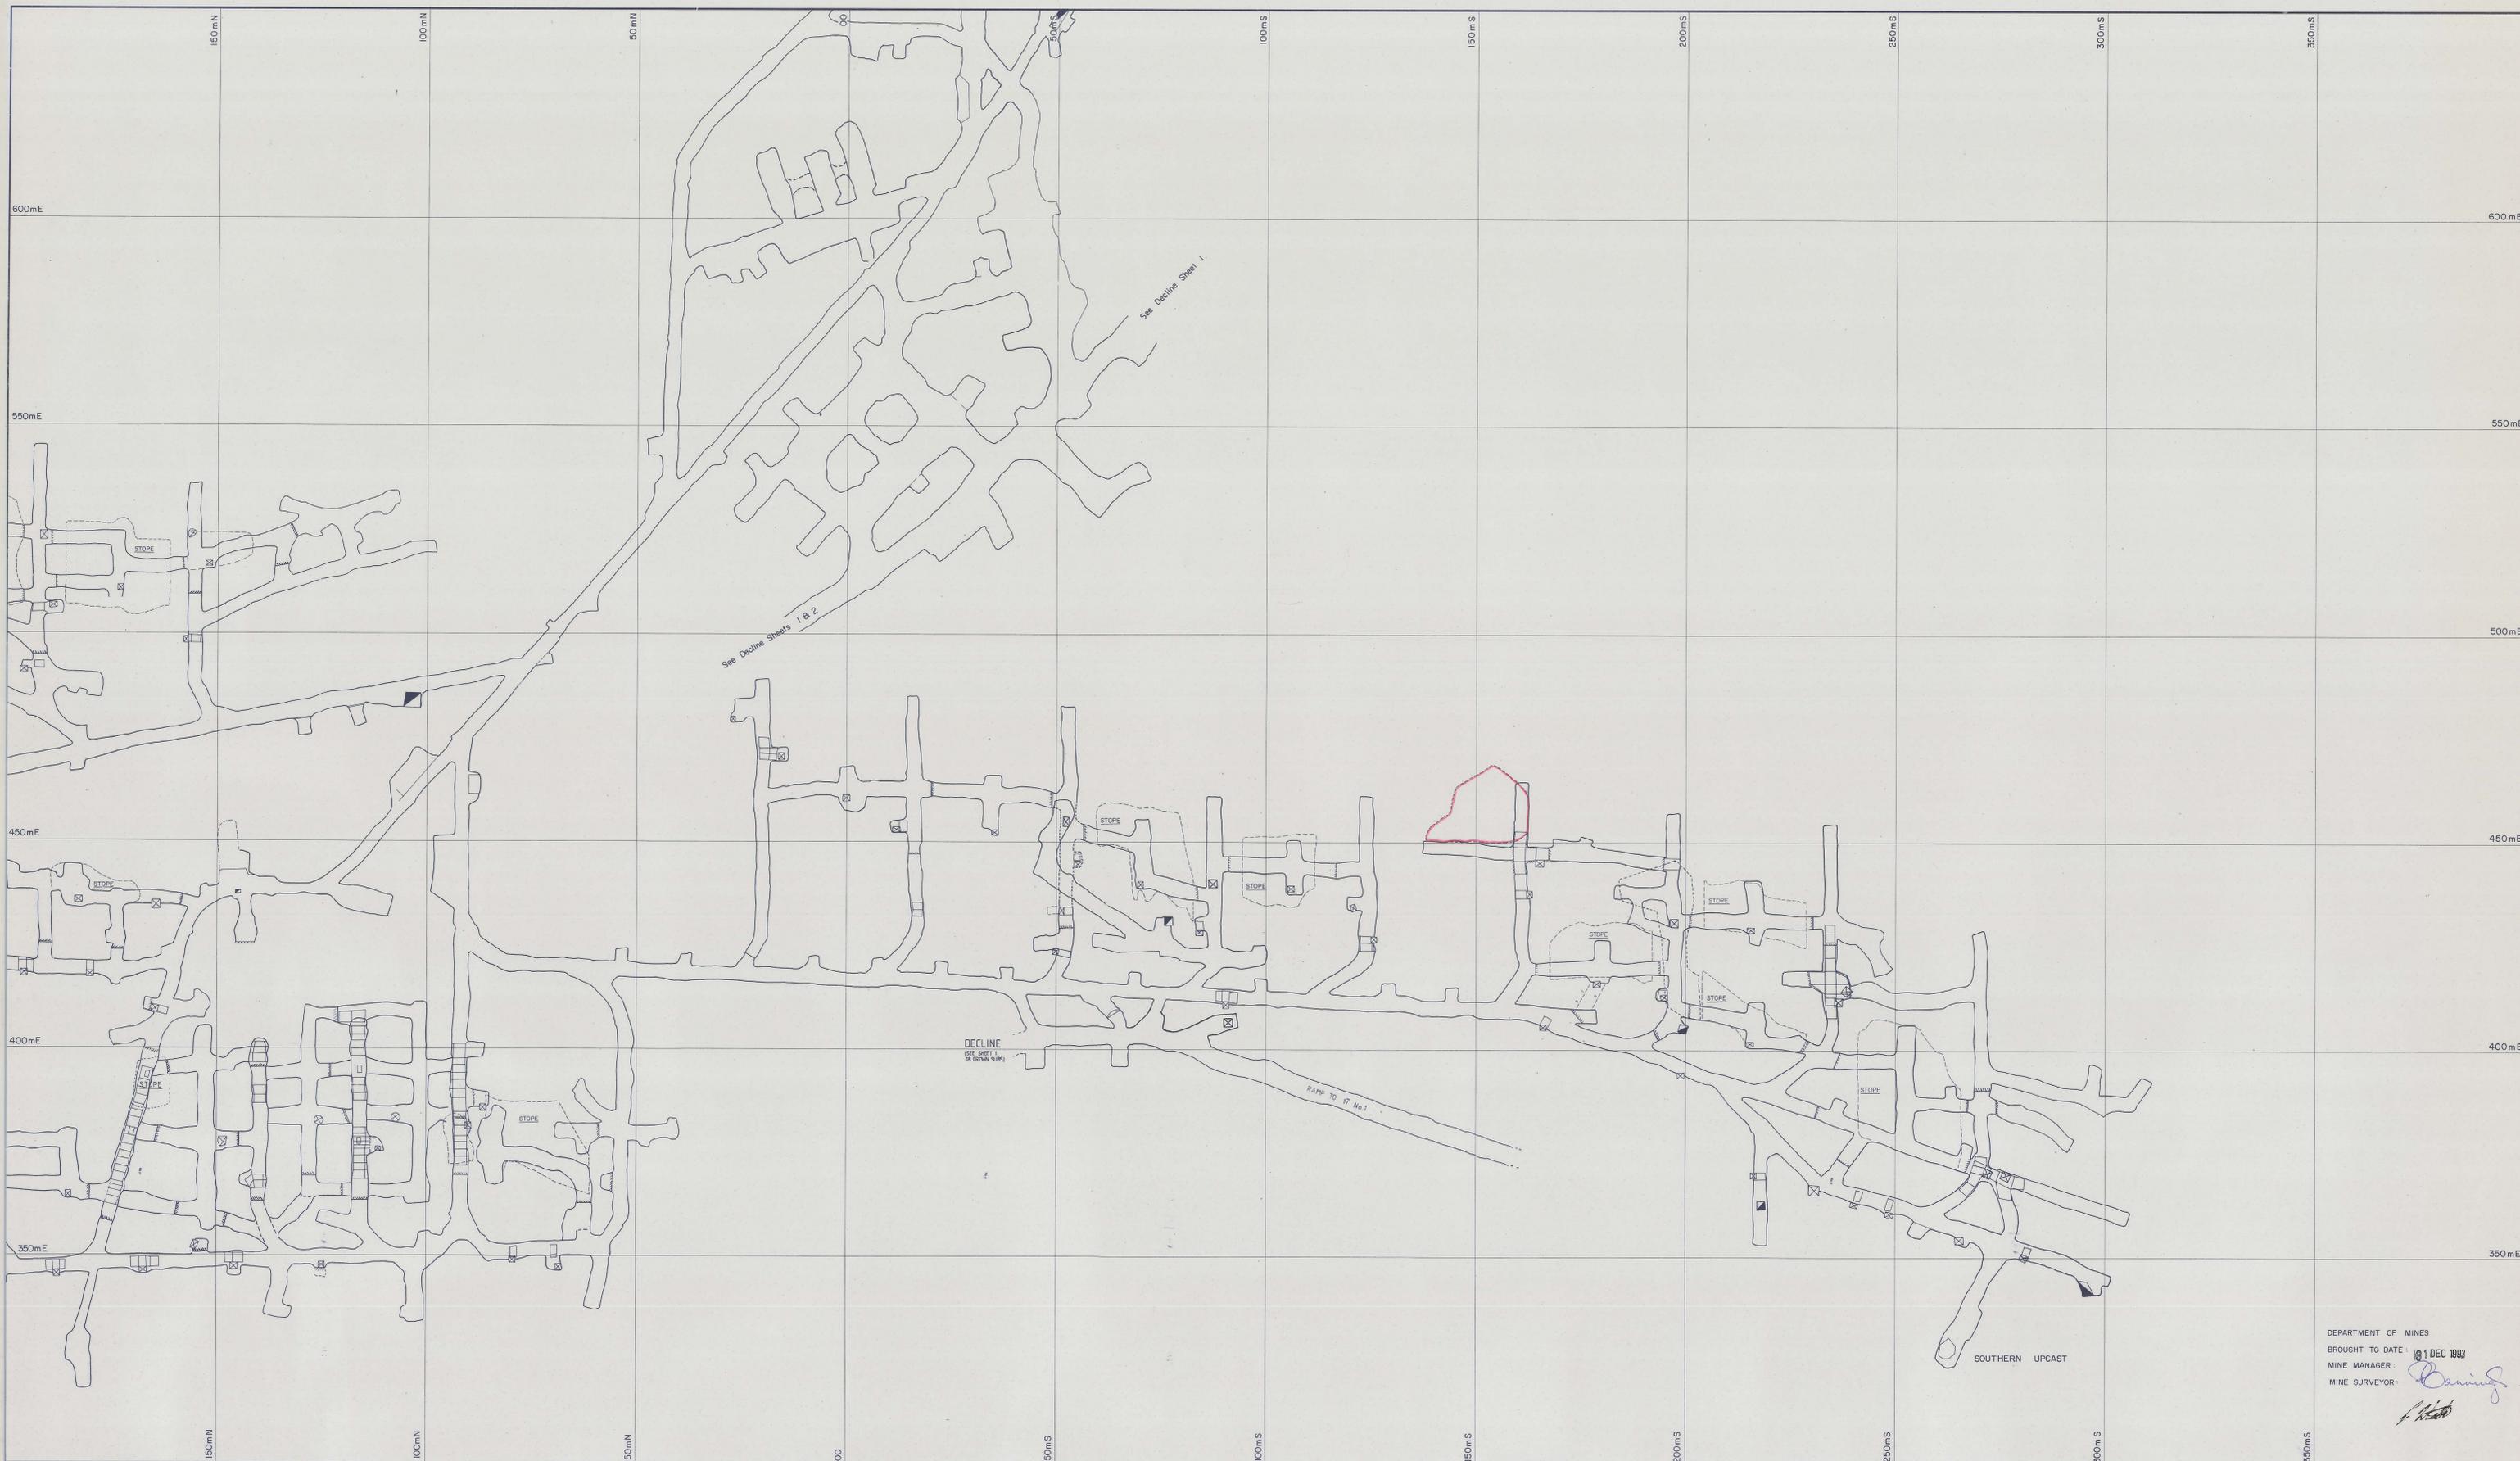

DEPARTMENT OF MINES
 BROUGHT TO DATE: 11 DEC 1993
 MINE MANAGER: *[Signature]*
 MINE SURVEYOR: *[Signature]*

SCALE SHOWING 1:500 METRES AND EQUIVALENT FEET



ELECTROLYTIC ZINC COMPANY OF AUSTRALASIA LIMITED

WEST COAST MINES, T.A.S.

A.C.N. 004 074 962

SURVEY BY		SCALE	1:500
DRAWN BY	G. M. BENNETT	DATE	10-03-83
TRACED BY		REFERENCE	

ROSEBERY MINE

17 LEVEL (1)

DRAWING N°:

