


0055 - 168

DEPARTMENT OF MINES
 BROUGHT TO DATE: 31 DEC 1980
 MINE MANAGER: *[Signature]*
 MINE SURVEYOR: *[Signature]*

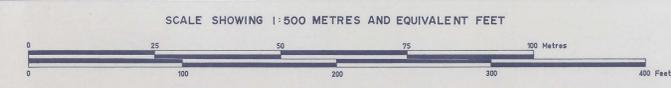

ELECTROLYTIC ZINC COMPANY OF AUSTRALASIA LIMITED
 WEST COAST MINES, T.A.S.
 A.C.N. 004 074 962

SURVEY BY		SCALE	1:500
DRAWN BY	K. CAREY	DATE	19-05-80
TRACED BY	A. G. MORRISON	REFERENCE	

ROSEBERY MINE
 LONGITUDINAL PROJECTION
 DECLINE SPECIAL

DRAWING N°:
 DEPARTMENT OF MINES