


0055 - 171



DEPARTMENT OF MINES
 BROUGHT TO DATE : 31 DEC 1963
 MINE MANAGER : *Banning*
 MINE SURVEYOR : *[Signature]*

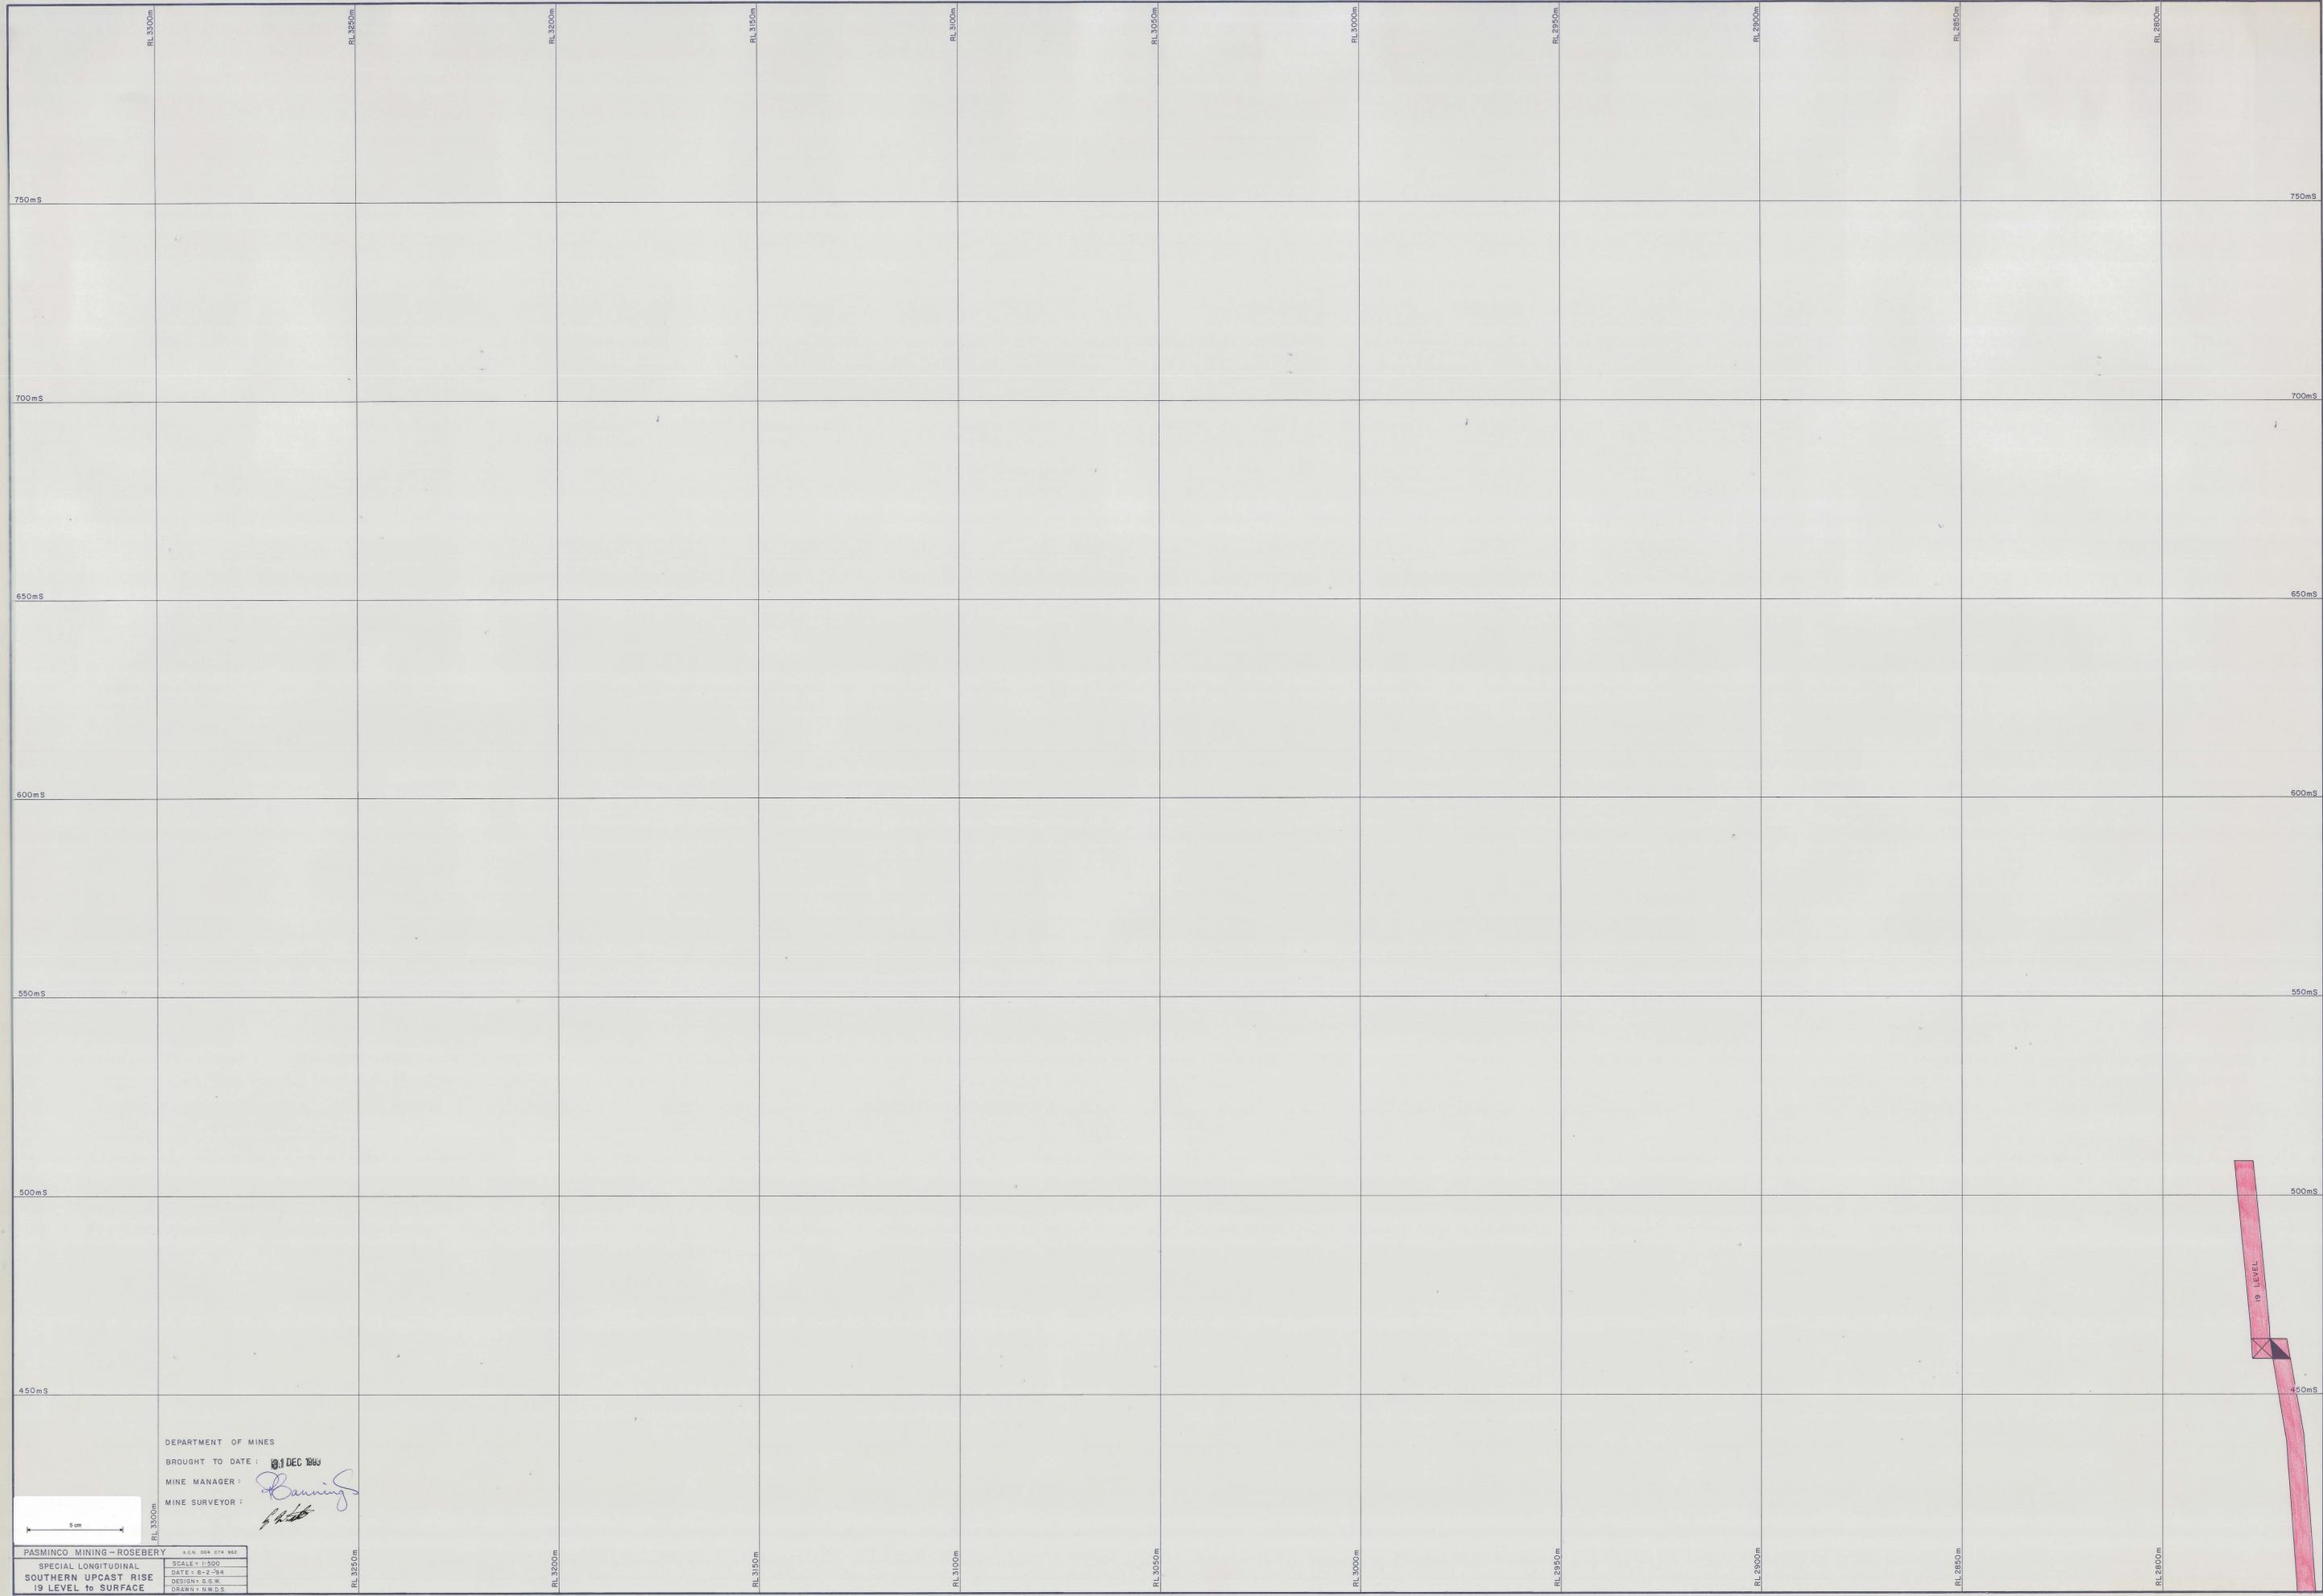

PASMINCO MINING - ROSEBERY
 SPECIAL LONGITUDINAL
 SOUTHERN UPCAST RISE
 19 LEVEL to SURFACE

SCALE: 1:500
 DATE: 8-2-54
 DESIGN: G.S.W.
 DRAWN: N.W.S.

