


0055-174

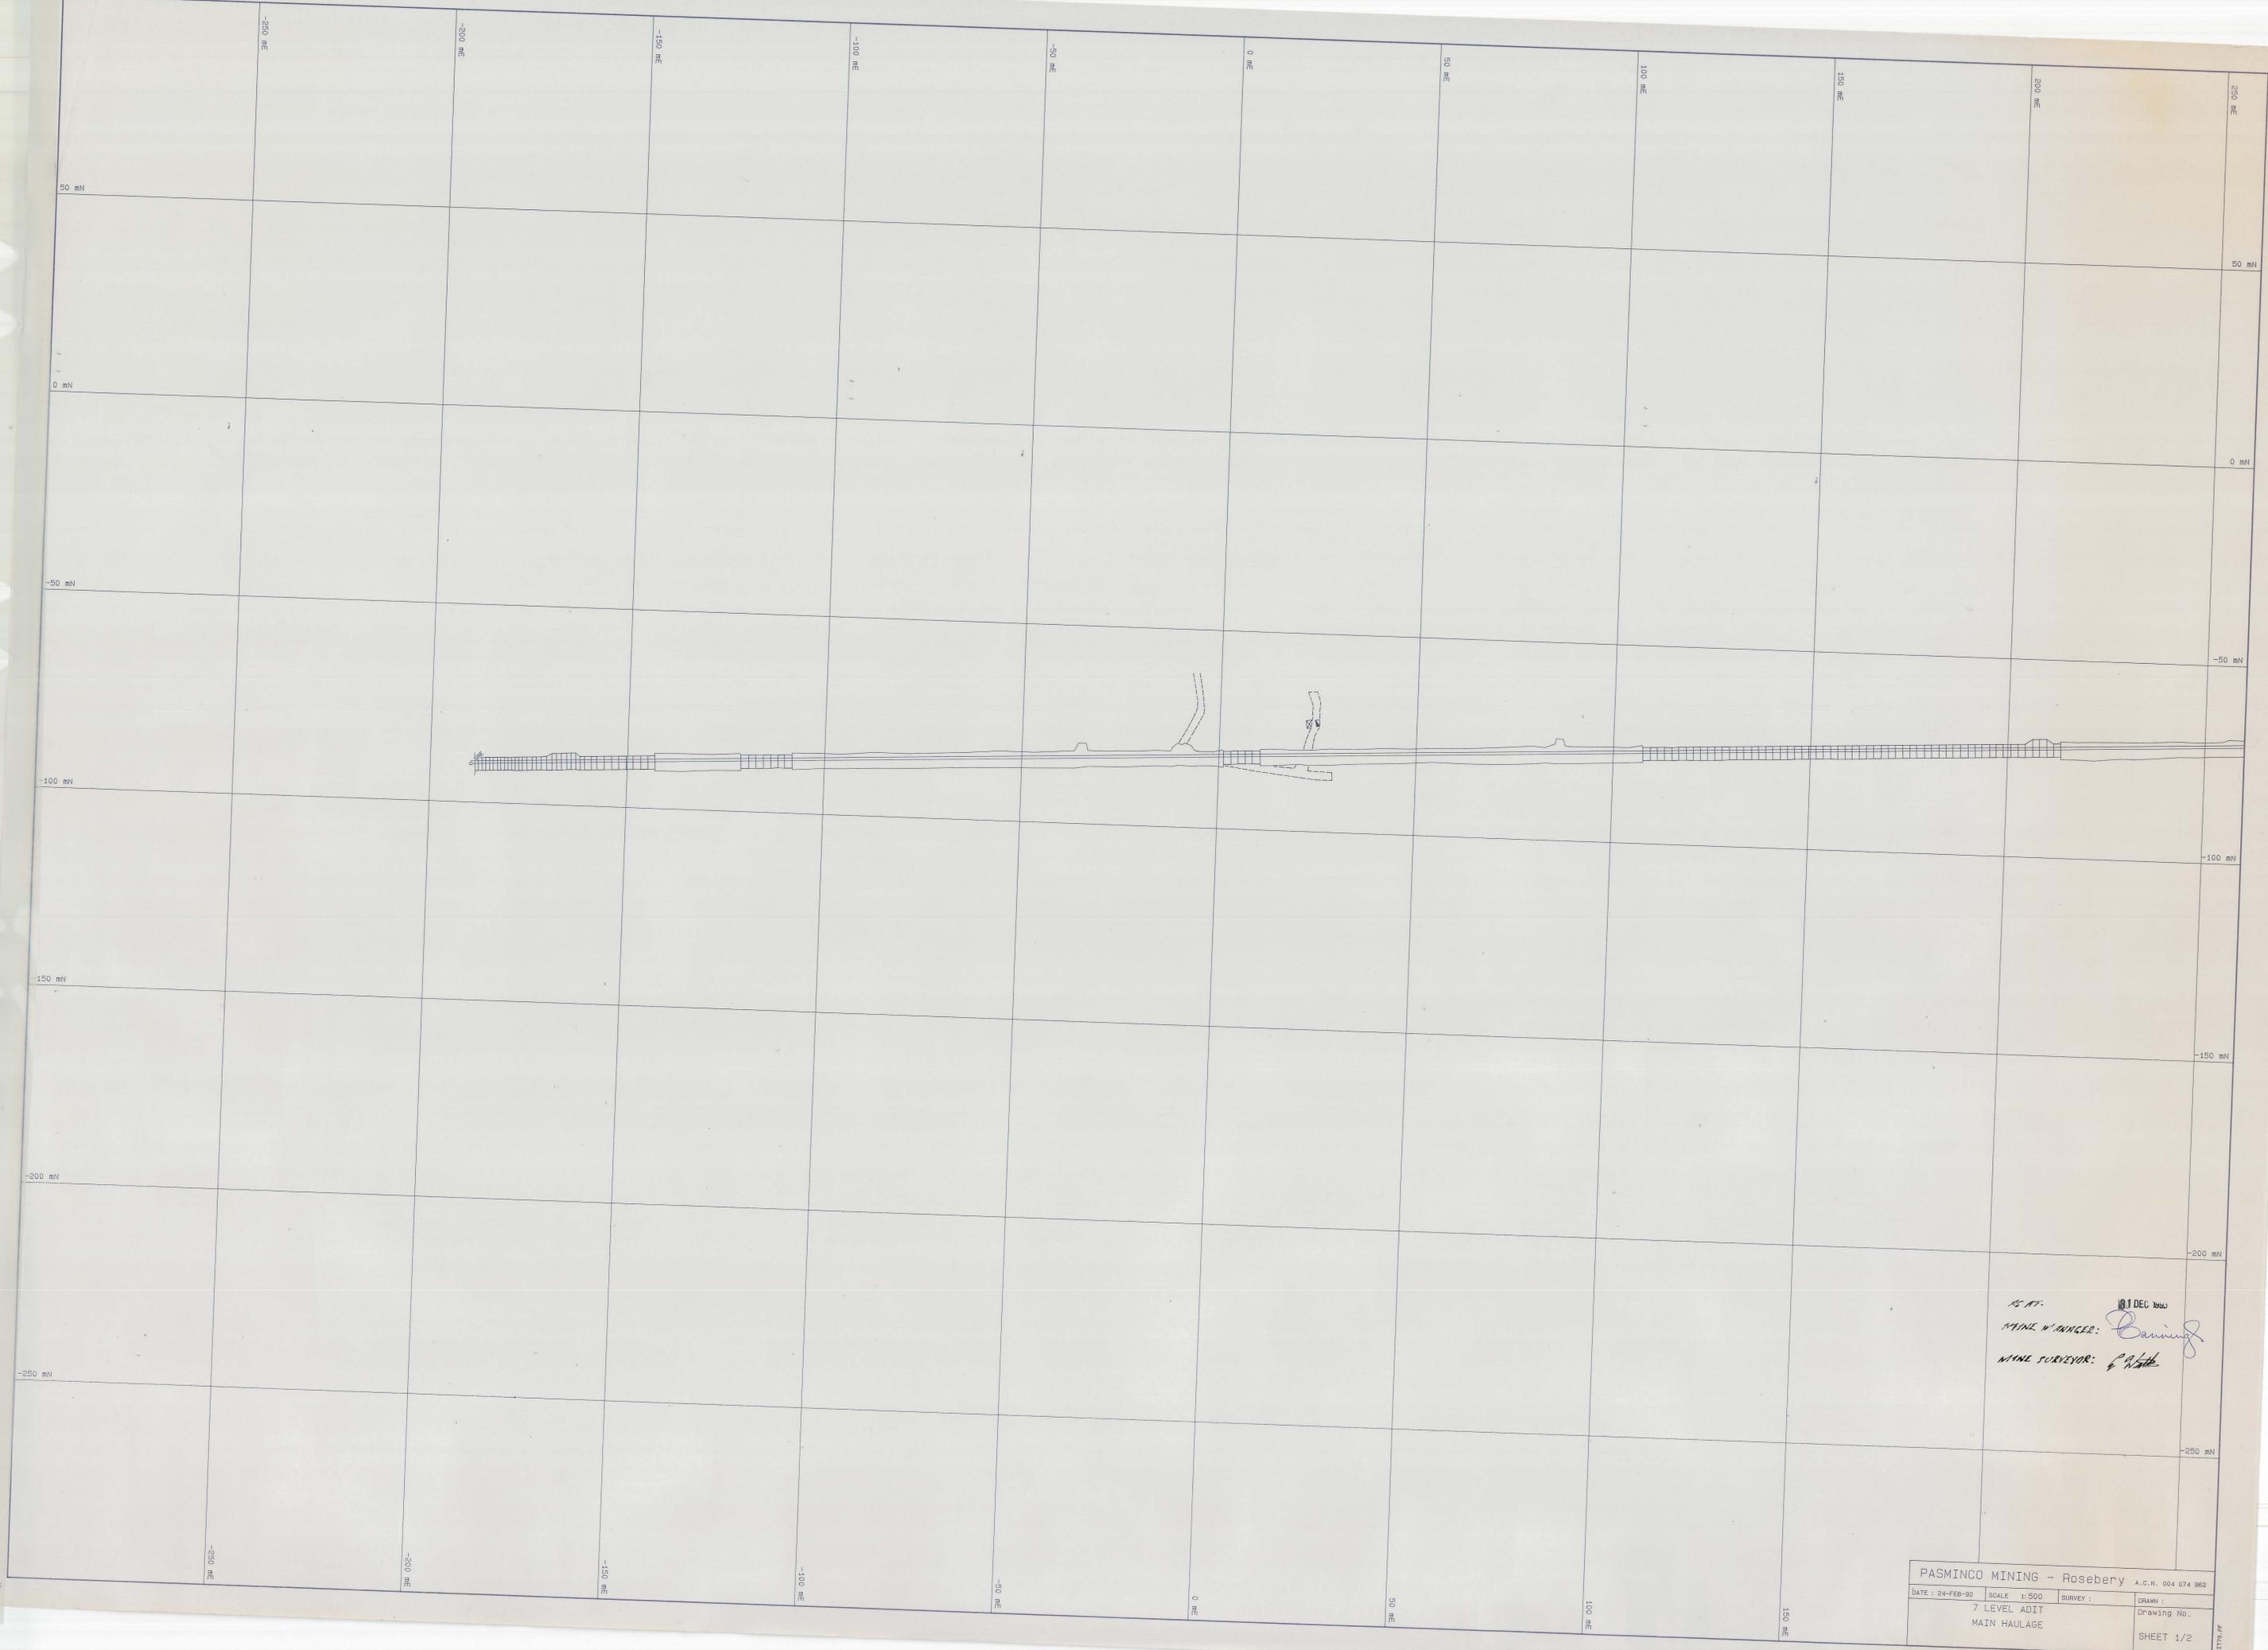

AS AT: 10 DEC 1990  
 ADIT W/ INHAGER: *Banning*  
 ADIT SURVEYOR: *[Signature]*

PASMINGO MINING - Rosebery		A.C.N. 004 074 968	
DATE: 24-FEB-92	SCALE: 1:500	SURVEY:	DRAWN:
7 LEVEL ADIT		DRAWING No.	
MAIN HAULAGE		SHEET 1/2	