


0055-175



AS AT 31 DEC 1990
 MINE MANAGER: *[Signature]*
 MINE SURVEYOR: *[Signature]*

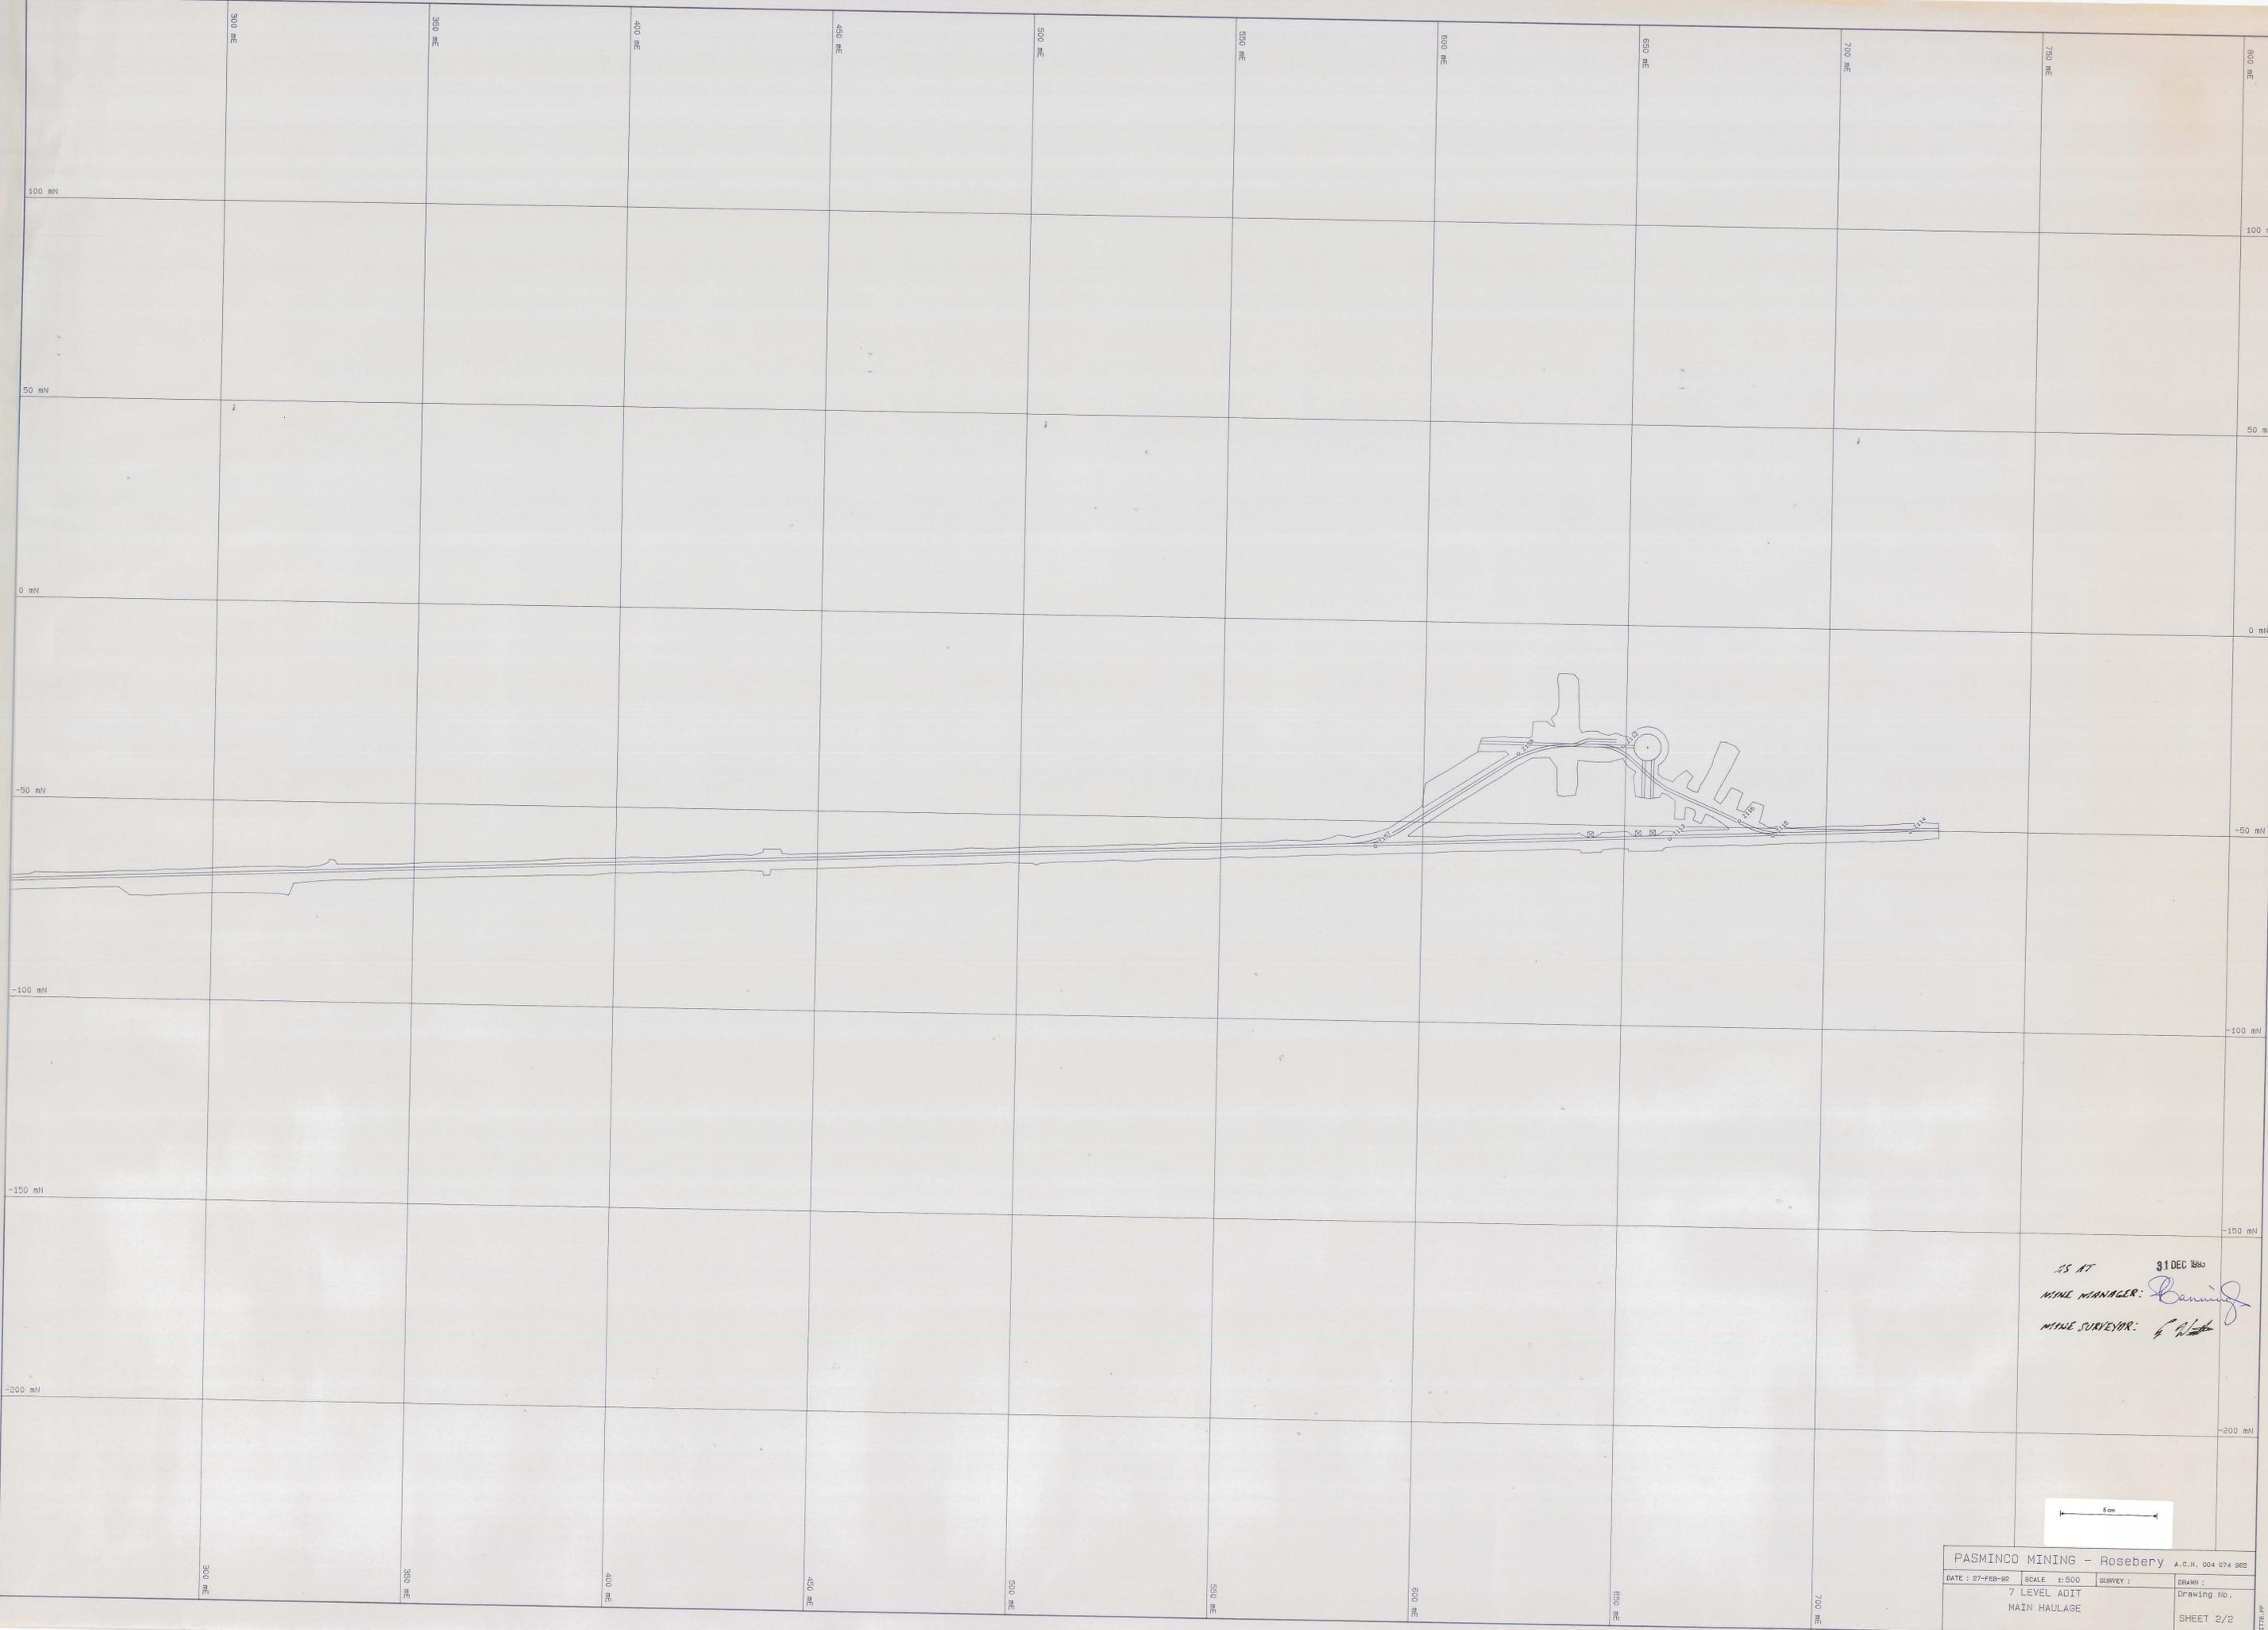

PASMINGO MINING - Rosebery		A.C.N. 004 074 982
DATE : 27-FEB-92	SCALE : 1:500	SURVEY :
7 LEVEL ADIT		DRAWING No.
MAIN HAULAGE		SHEET 2/2