


0055 - 176



AS AT 11 DEC 1983
 MINE MANAGER: *Danning*
 MINE SURVEYOR: *W. West*

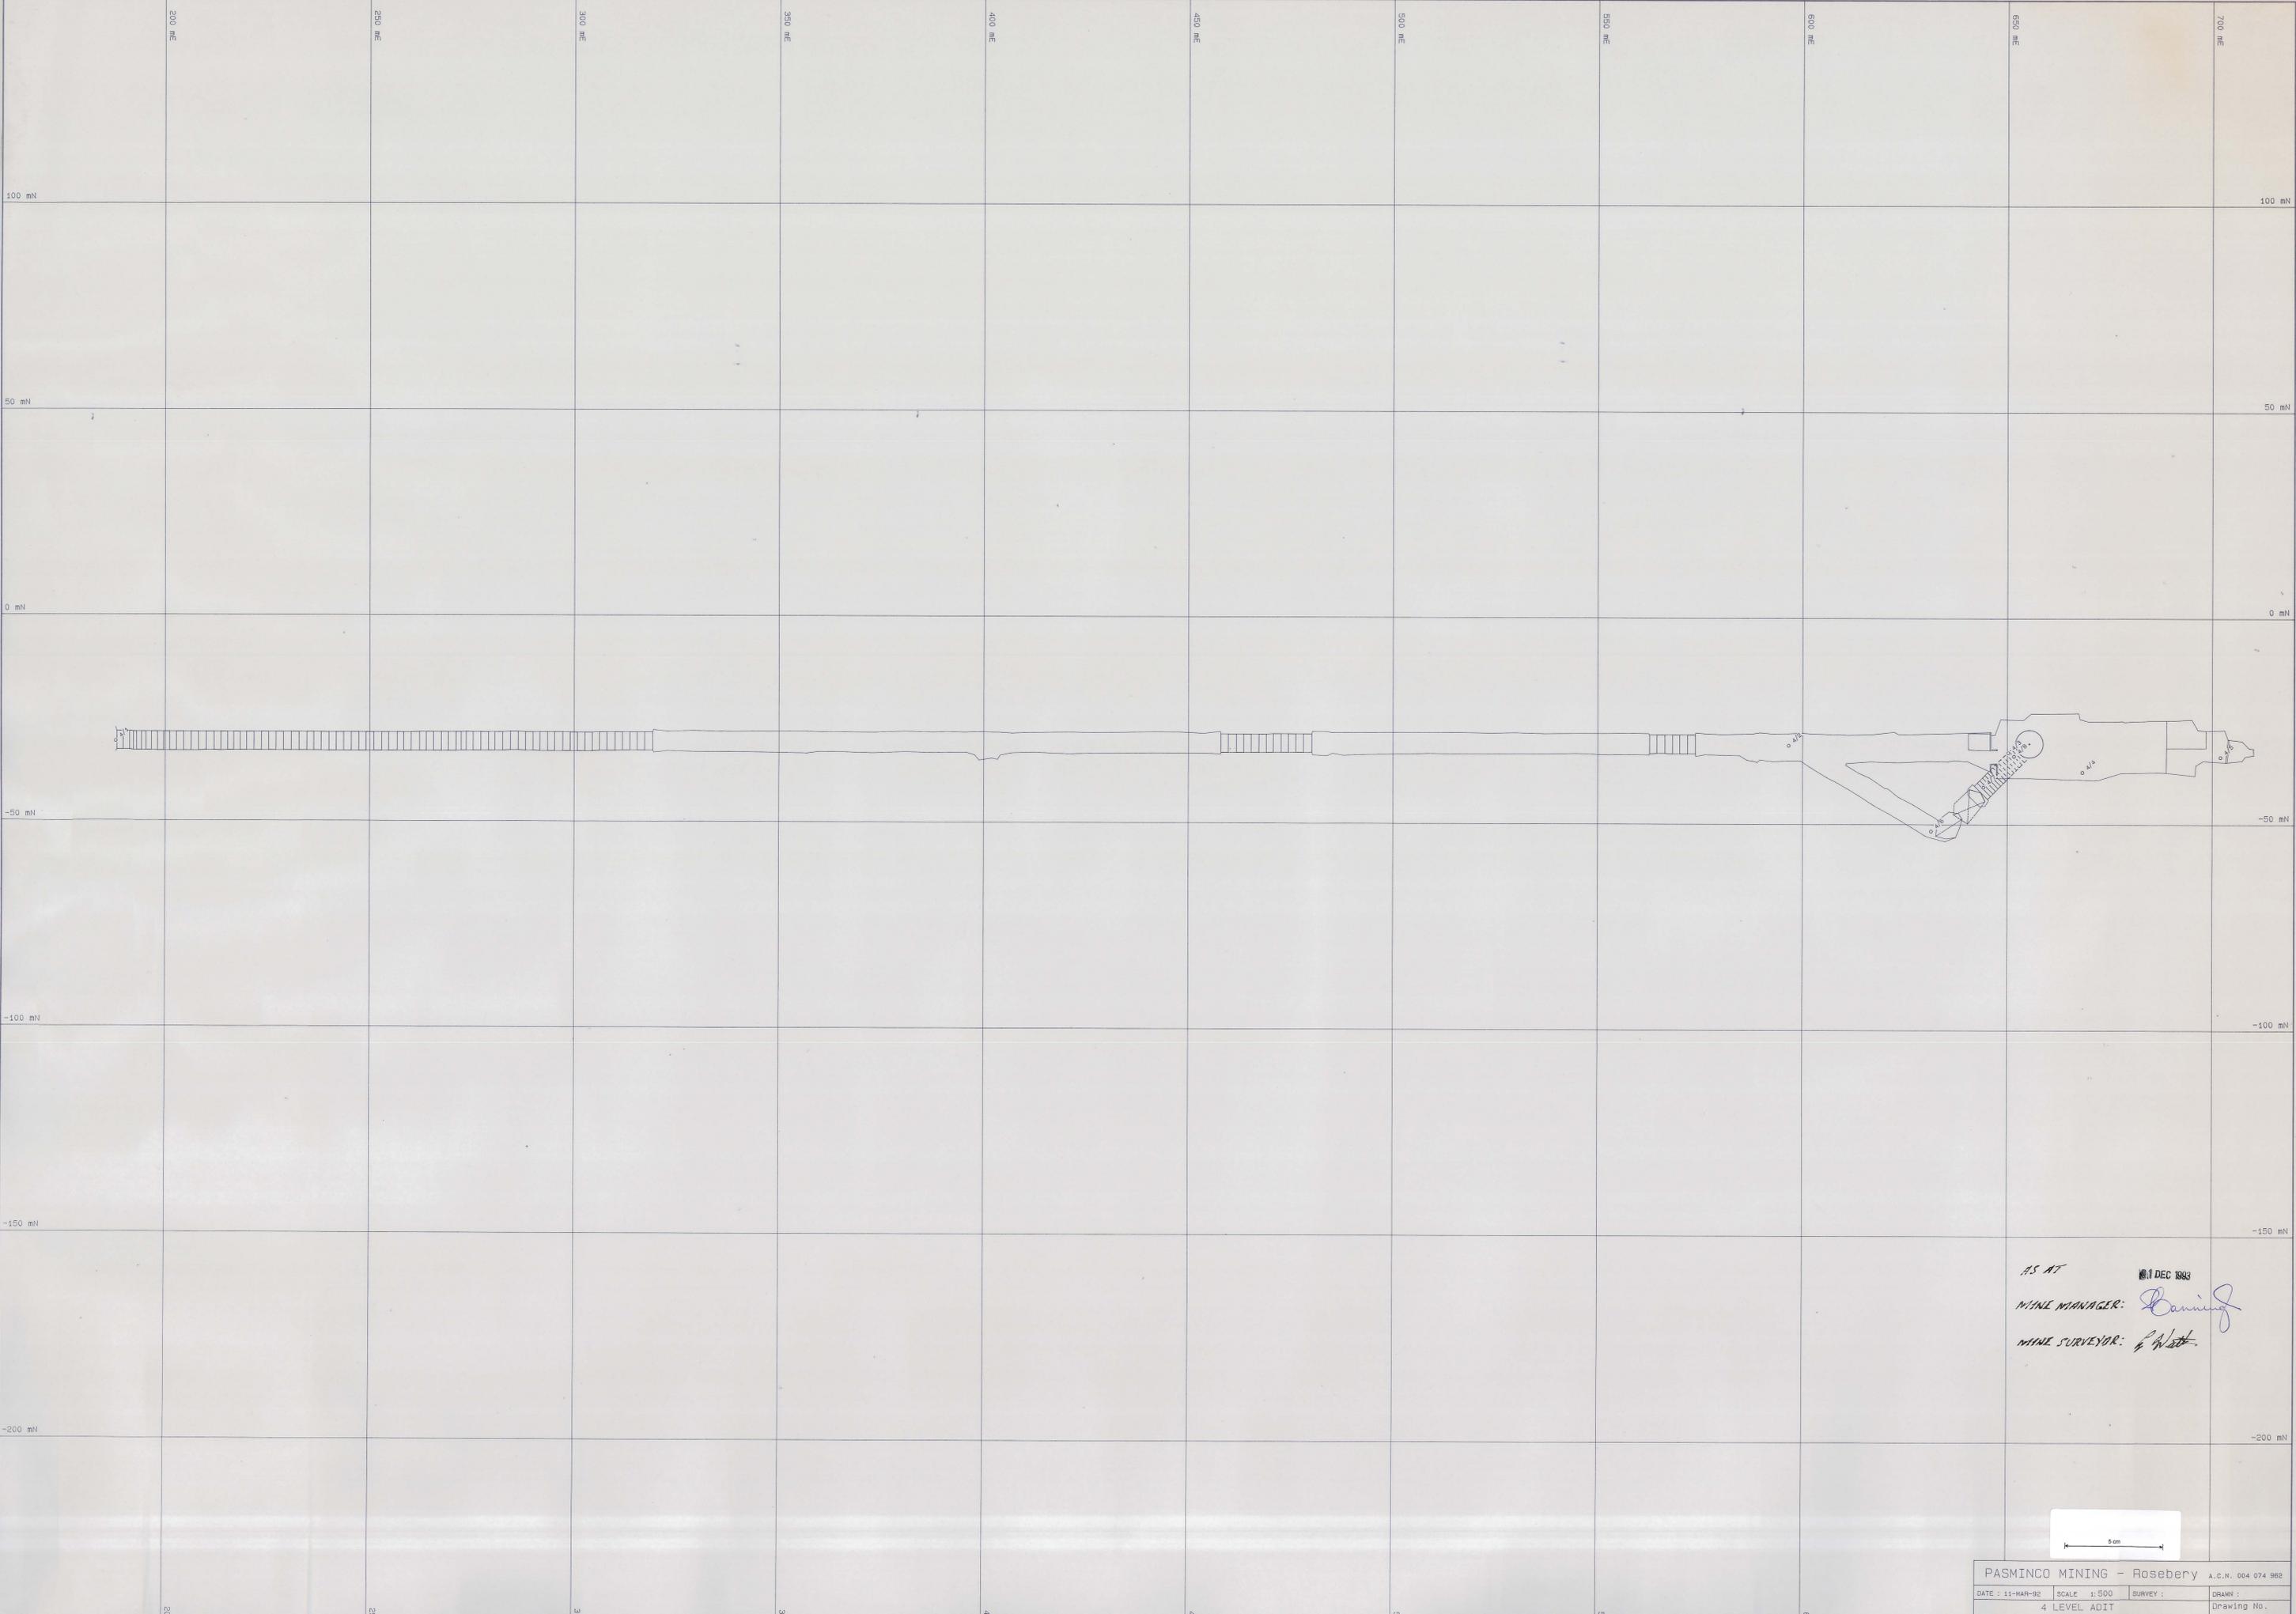

PASMINGO MINING - Rosebery A.C.N. 004 074 982			
DATE : 11-MAR-92	SCALE : 1:500	SURVEY :	DRAWN :
4 LEVEL ADIT			Drawing No.
STAVING BANK CROSS CUT			