



0055 - 177

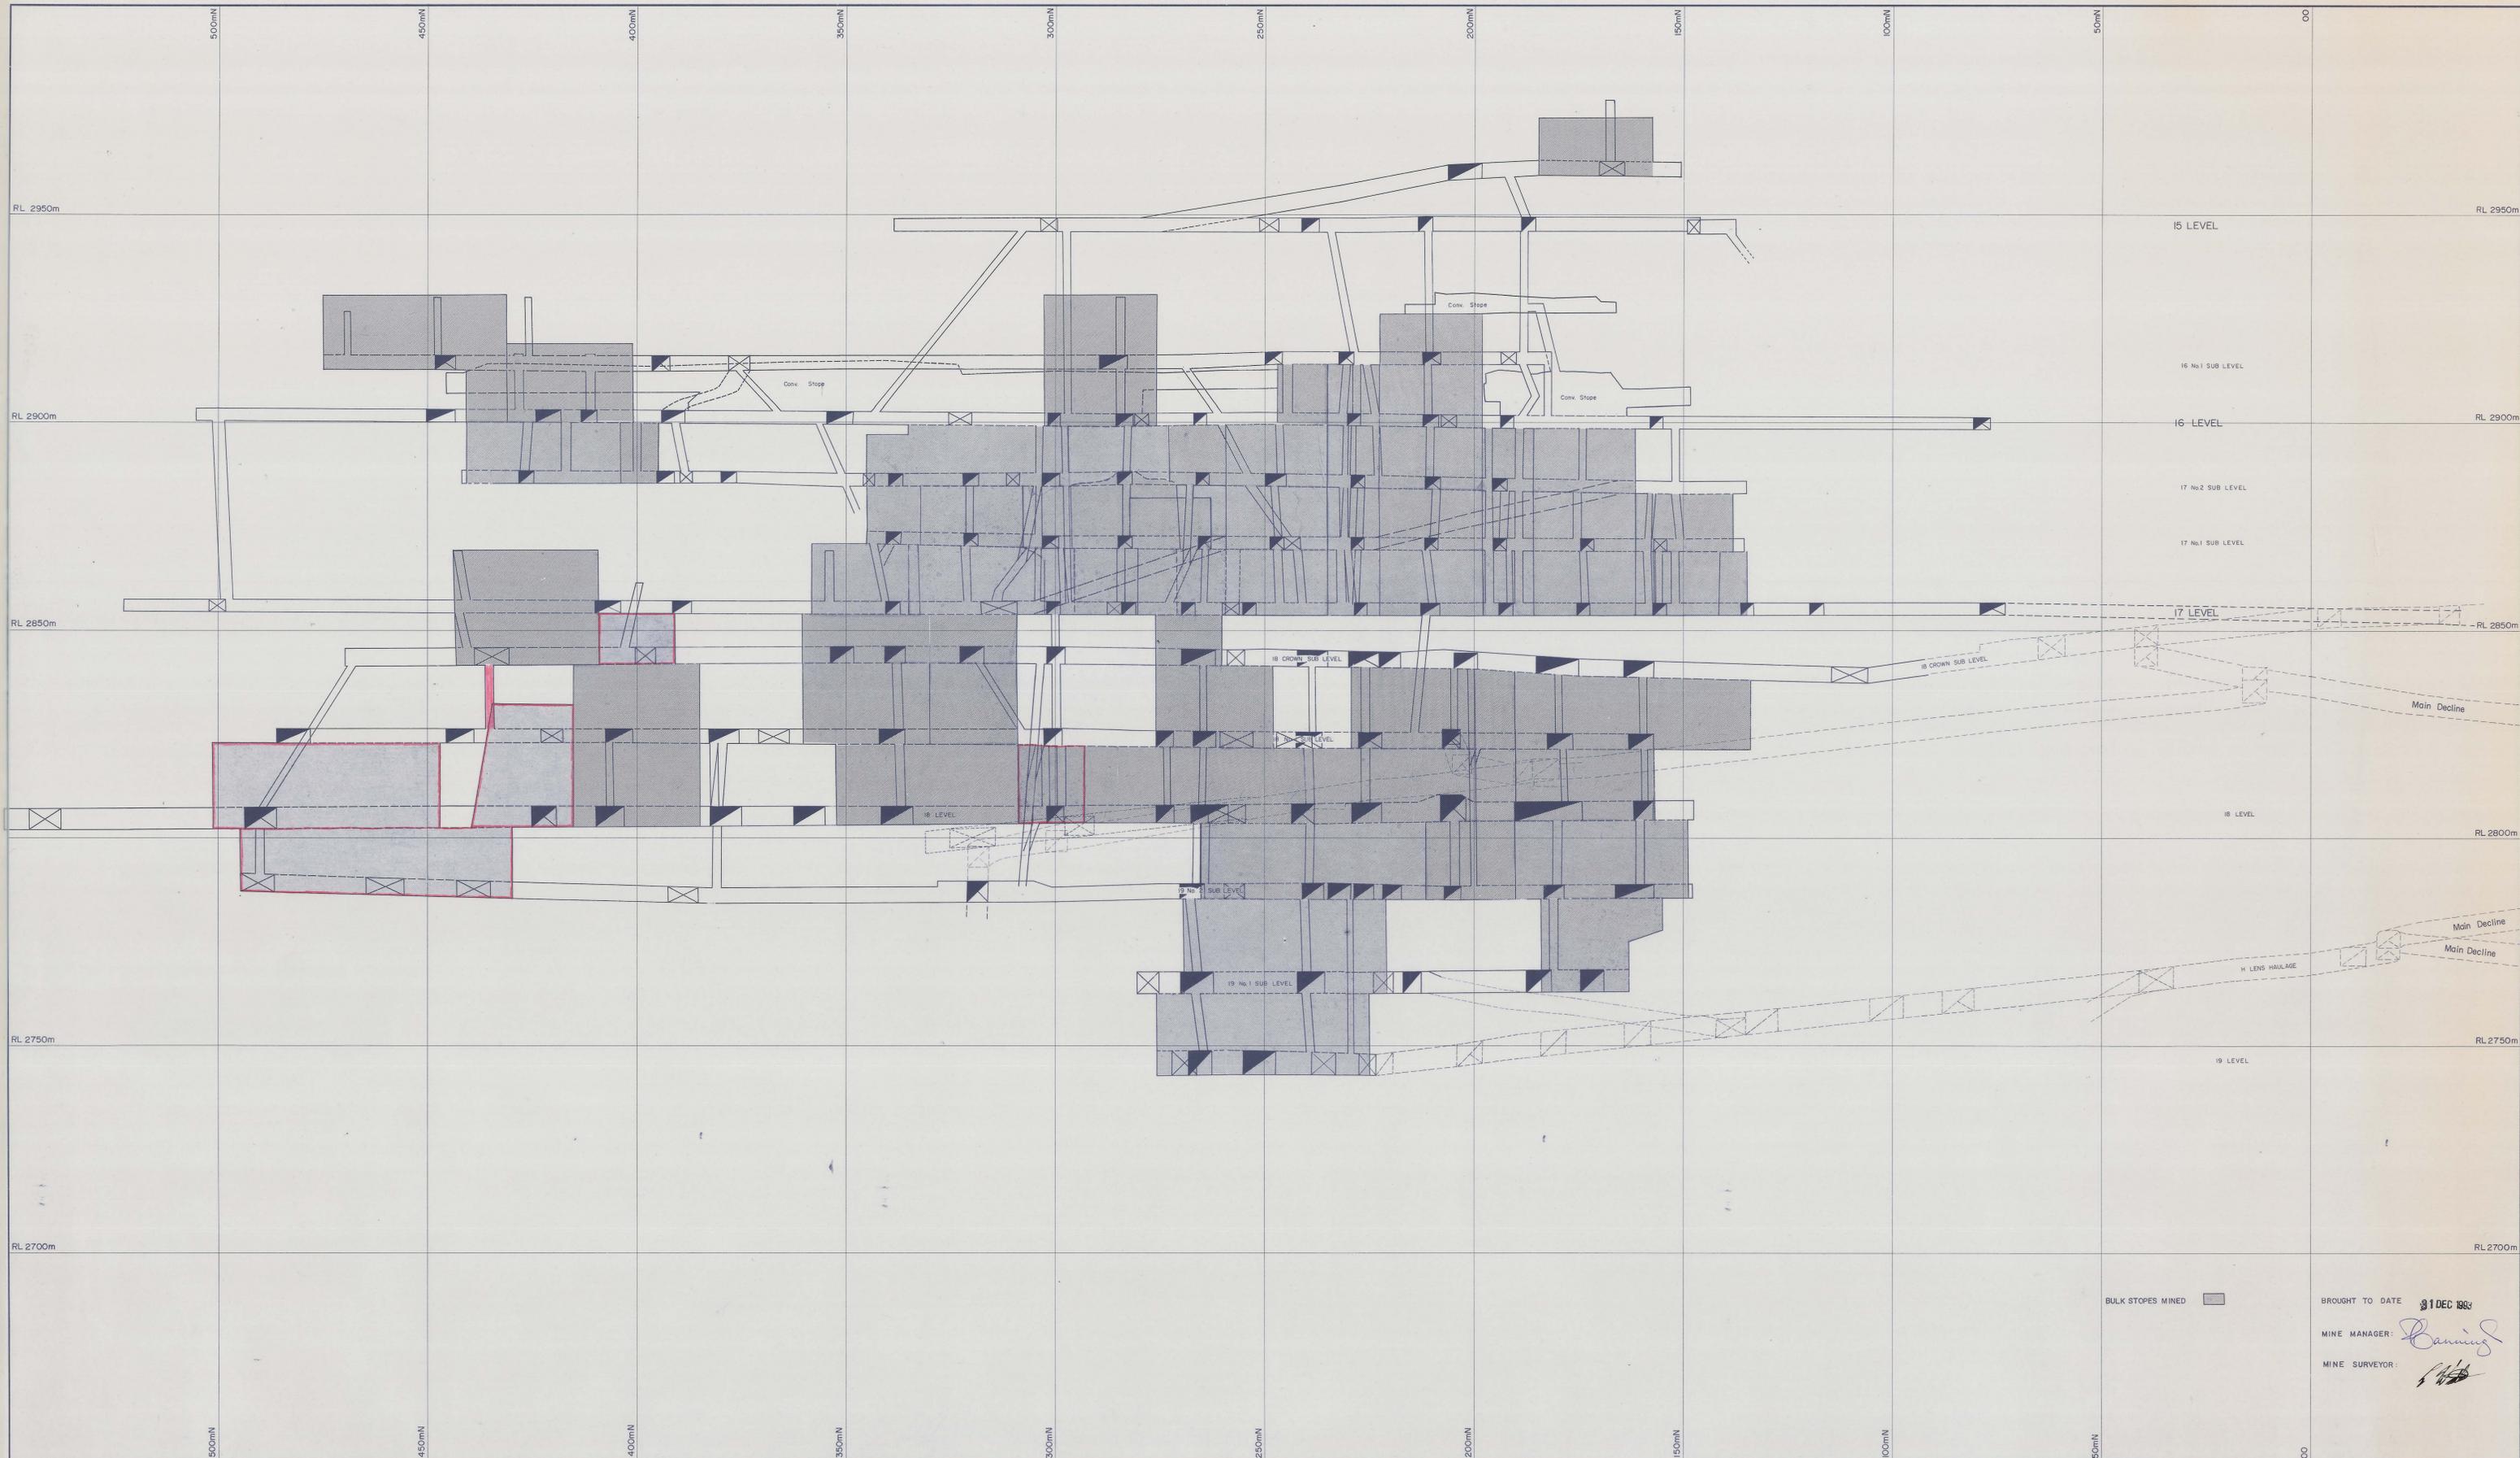

BULK STOPES MINED

BROUGHT TO DATE 31 DEC 1983
 MINE MANAGER: *Banning*
 MINE SURVEYOR: *[Signature]*

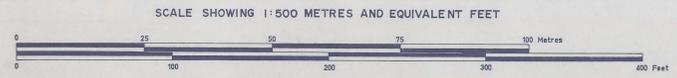

ELECTROLYTIC ZINC COMPANY OF AUSTRALASIA LIMITED

WEST COAST MINES, T.A.S.
A.C.N. 004 074 962

SURVEY BY		SCALE	1:500
DRAWN BY	A.G. MORRISON	DATE	19-01-79
TRACED BY	A.G.M.	REFERENCE	

ROSEBERY MINE
 LONGITUDINAL PROJECTION
 'H' LENS, H/W STOPE
 50m S-550m N BELOW 15 LEVEL

DRAWING NO.:
 DEPARTMENT OF MINES