

0055-178

ELECTROLYTIC ZINC COMPANY OF AUSTRALASIA LIMITED

WEST COAST MINES

A.C.N. 004 074 962

DEPT.

By	Date
G.M. Bennett	29 05 84
Traced	
Checked	
Approved	

ROSEBERY MINE
18 N° 1 SUB LEVEL



SCALE:	FILE:
DESIGN:	DRAWING No.
SURVEY:	1


Revisions	No.			By			Date			Details			App.			References			
	No.	By	Date	No.	By	Date	No.	By	Date	No.	By	Date	No.	By	Date	No.	By	Date	

DEPARTMENT OF MINES

BROUGHT TO DATE : 31 DEC 1983

MINE MANAGER : *Banning*

MINE SURVEYOR : *White*

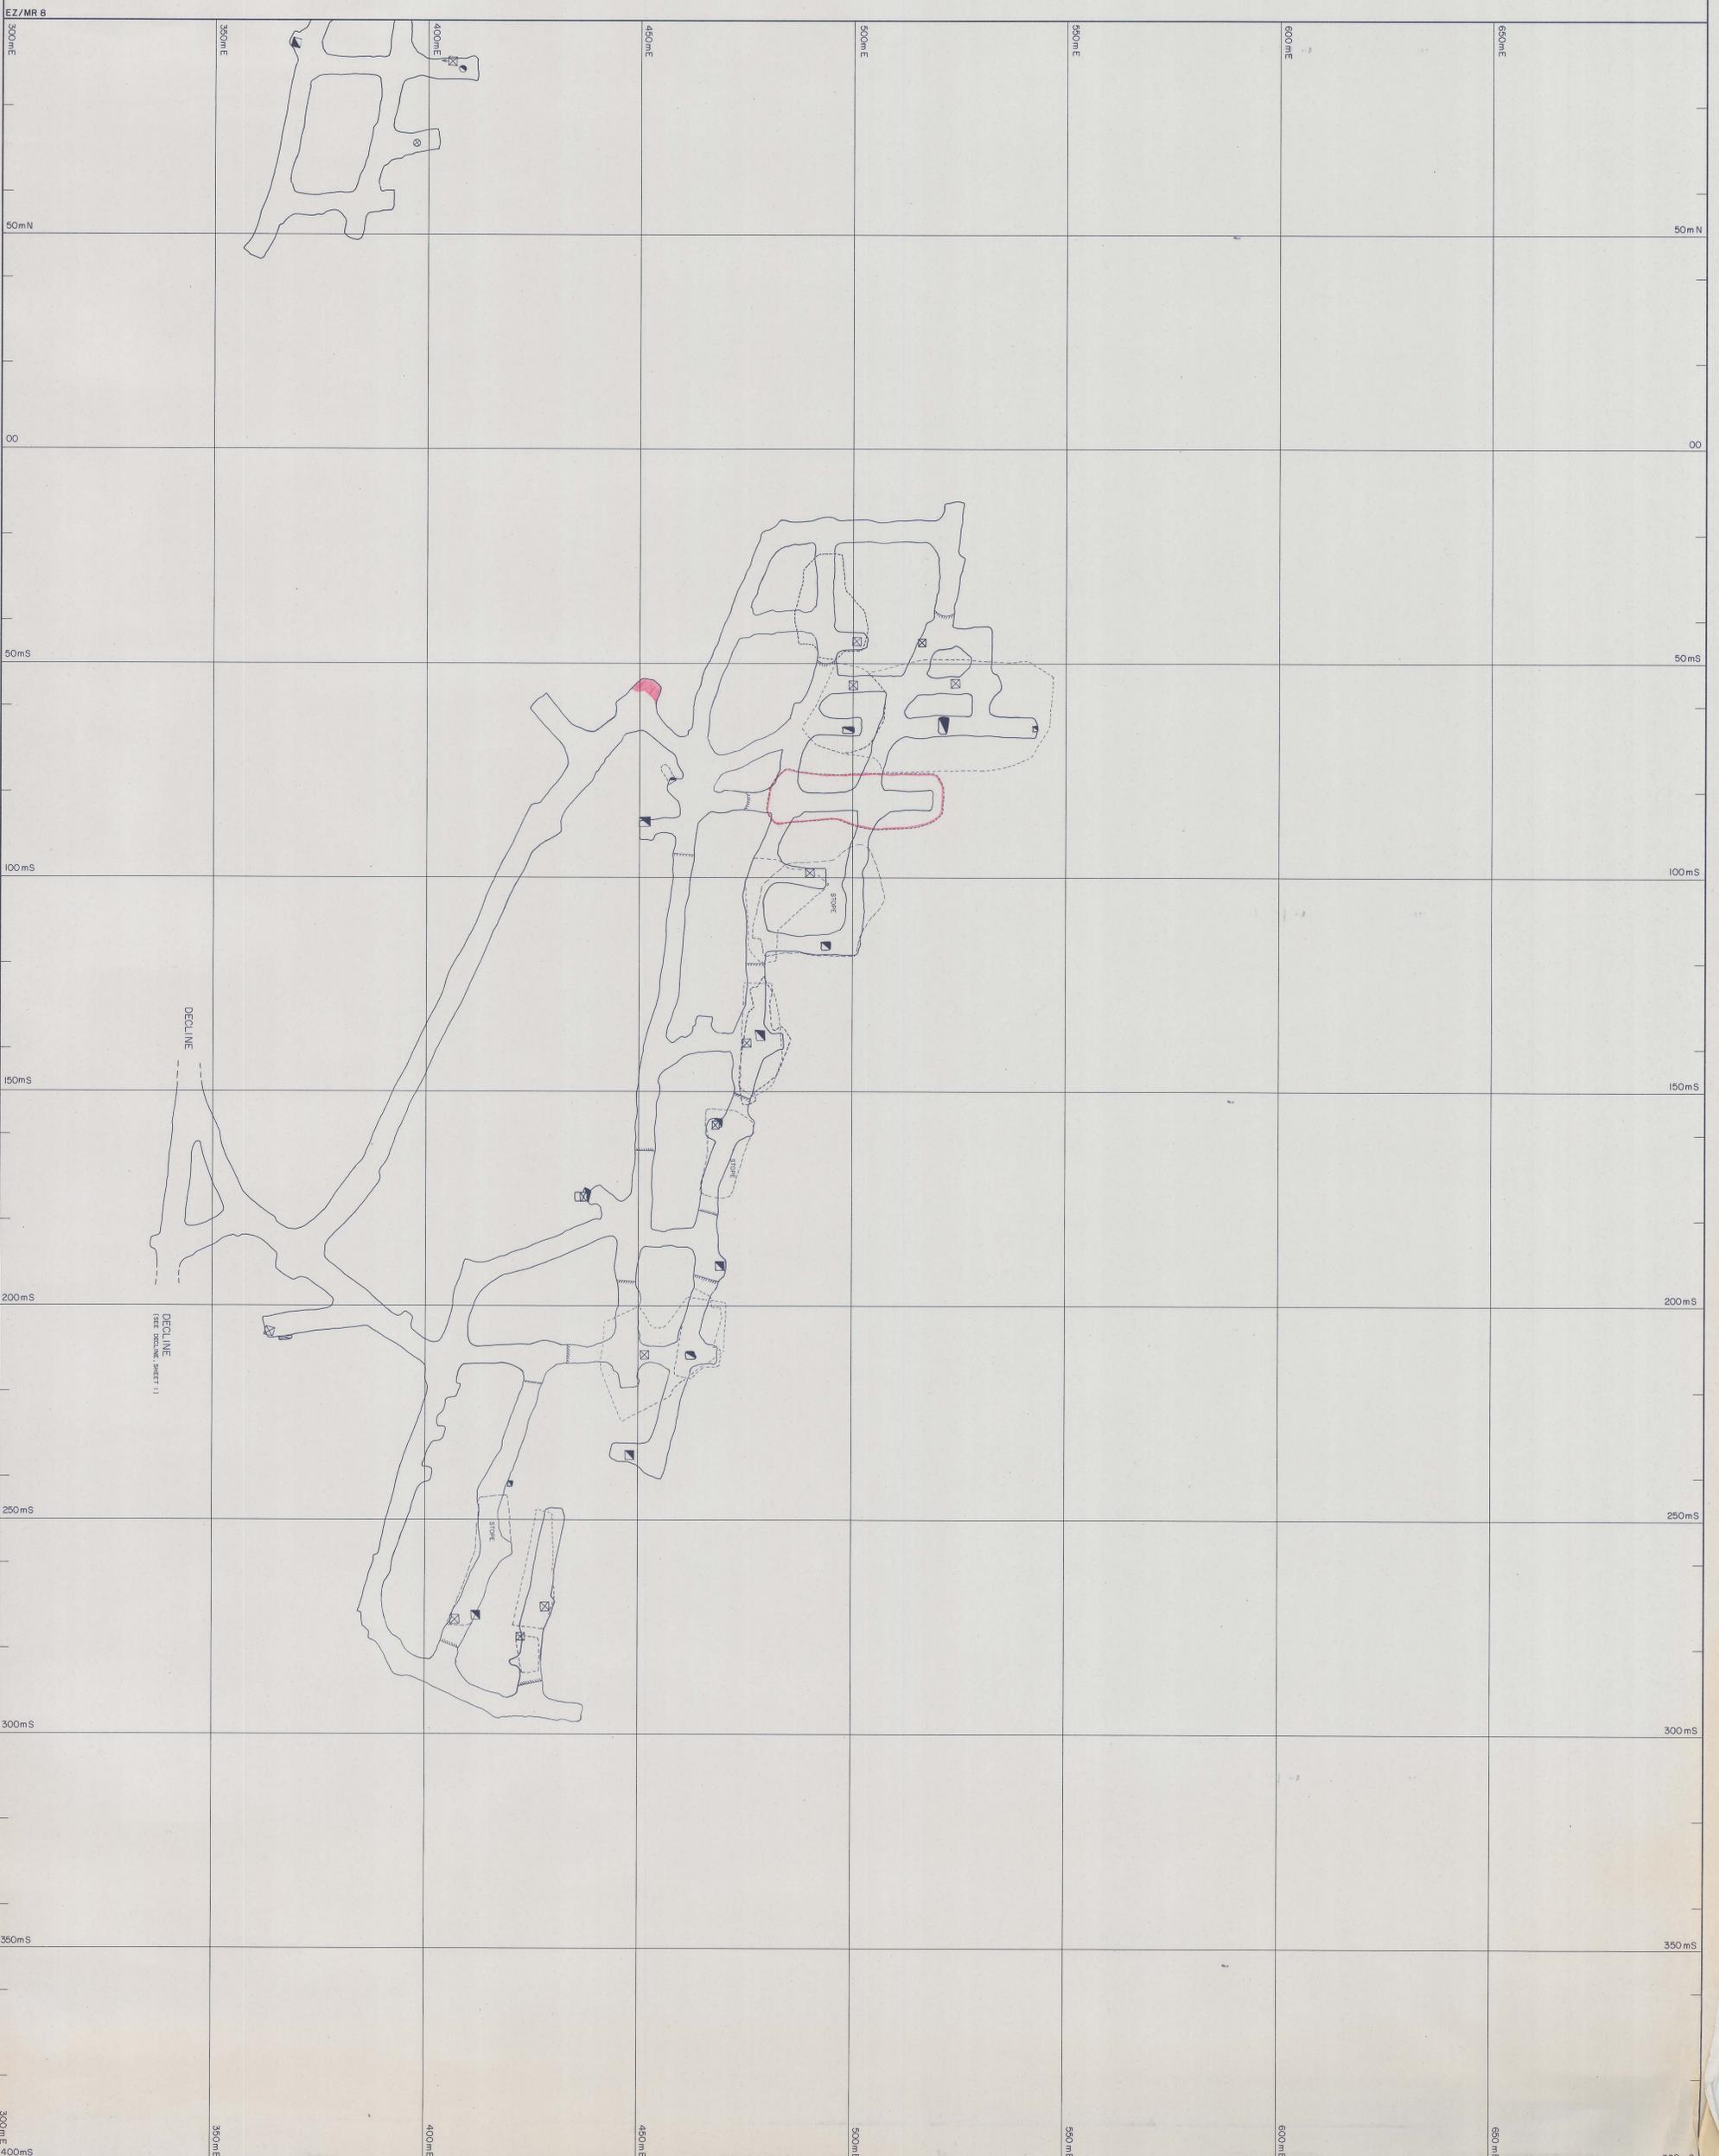

EZ/MR 6
400mE
350mE
300mE
250mE
200mE
150mE
100mE
50mE
00

50mN
100mS
150mS
200mS
250mS
300mS
350mS
400mS

400mE
350mE
300mE
250mE
200mE
150mE
100mE
50mE
00

50mN
100mS
150mS
200mS
250mS
300mS
350mS
400mS