
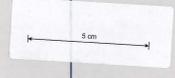
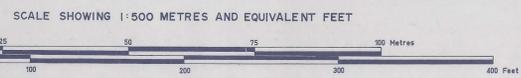


00 S S - 129

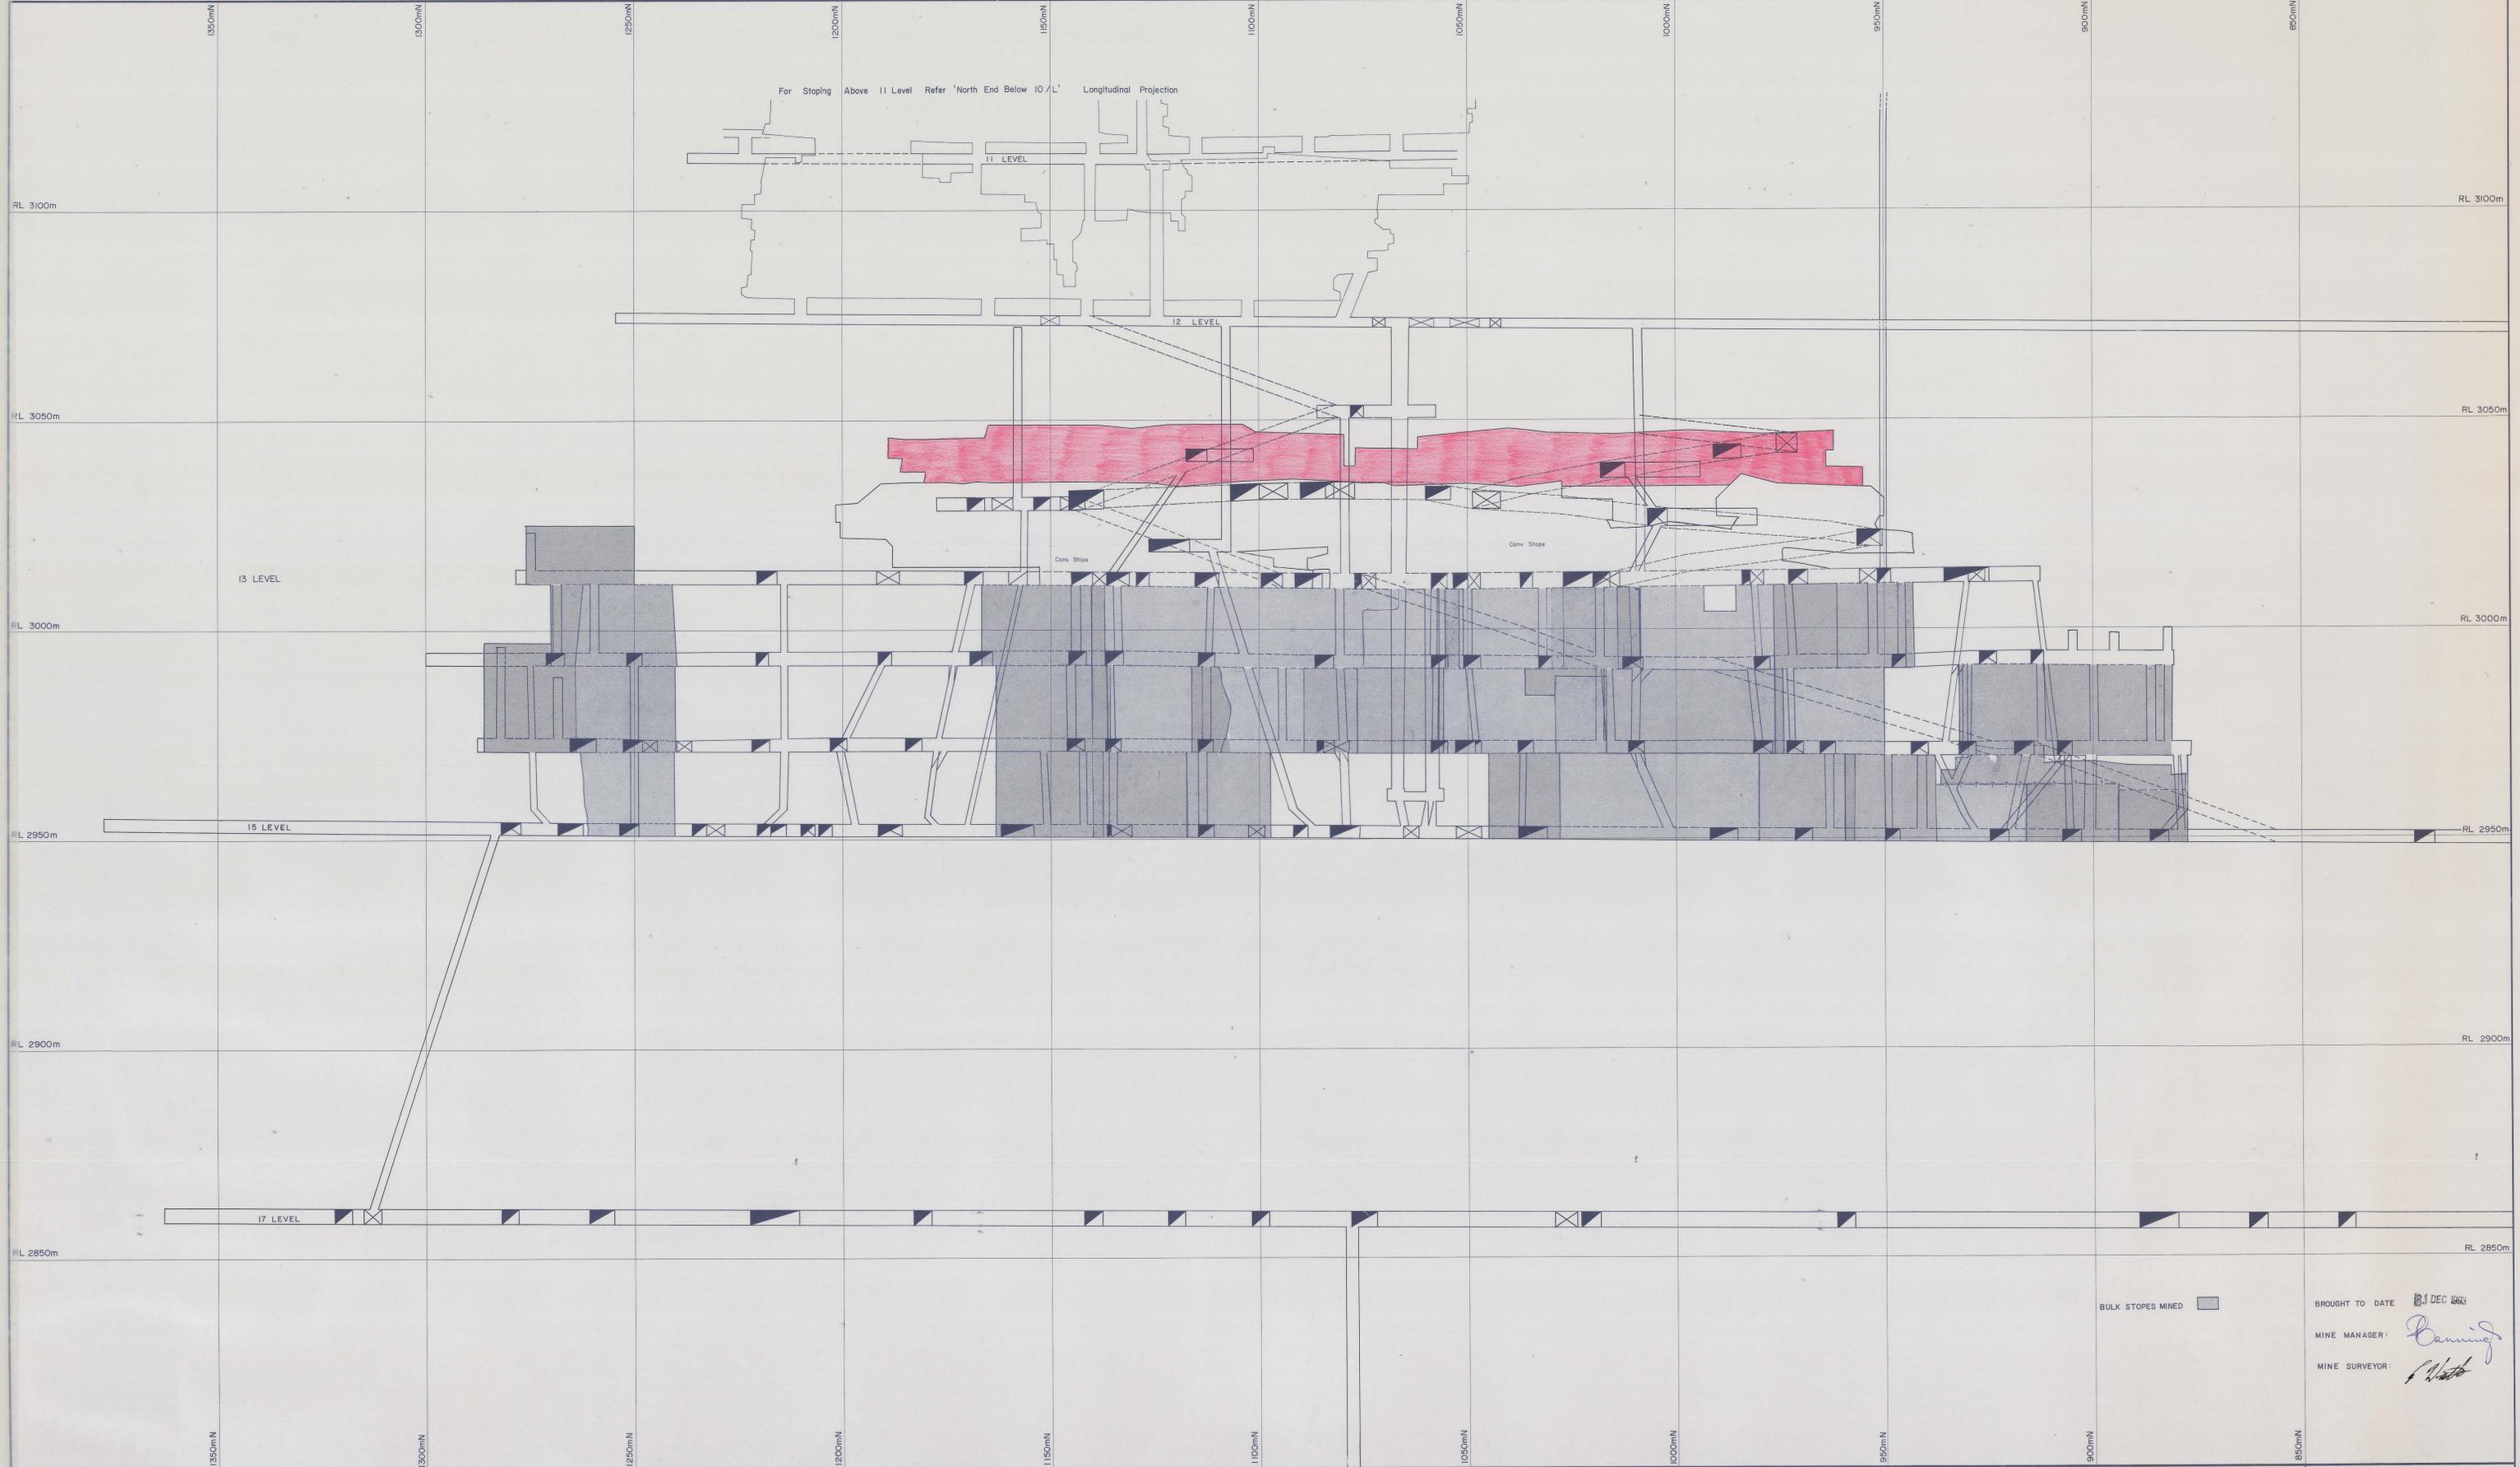

ELECTROLYTIC ZINC COMPANY OF AUSTRALASIA LIMITED
 WEST COAST MINES, T.A.S.
 A.C.N. 004 074 962

SURVEY BY		SCALE	1 : 500
DRAWN BY	A. G. MORRISON	DATE	19 01 79
TRACED BY	A. G. M.	REFERENCE	

ROSEBERY MINE
 LONGITUDINAL PROJECTION
 800mN-1400mN - BELOW 10/L

BULK STOPES MINED

BROUGHT TO DATE 03 DEC 1983
 MINE MANAGER: *Canning*
 MINE SURVEYOR: *Wade*

DRAWING N°:
 DEPARTMENT OF MINES