


0055-181

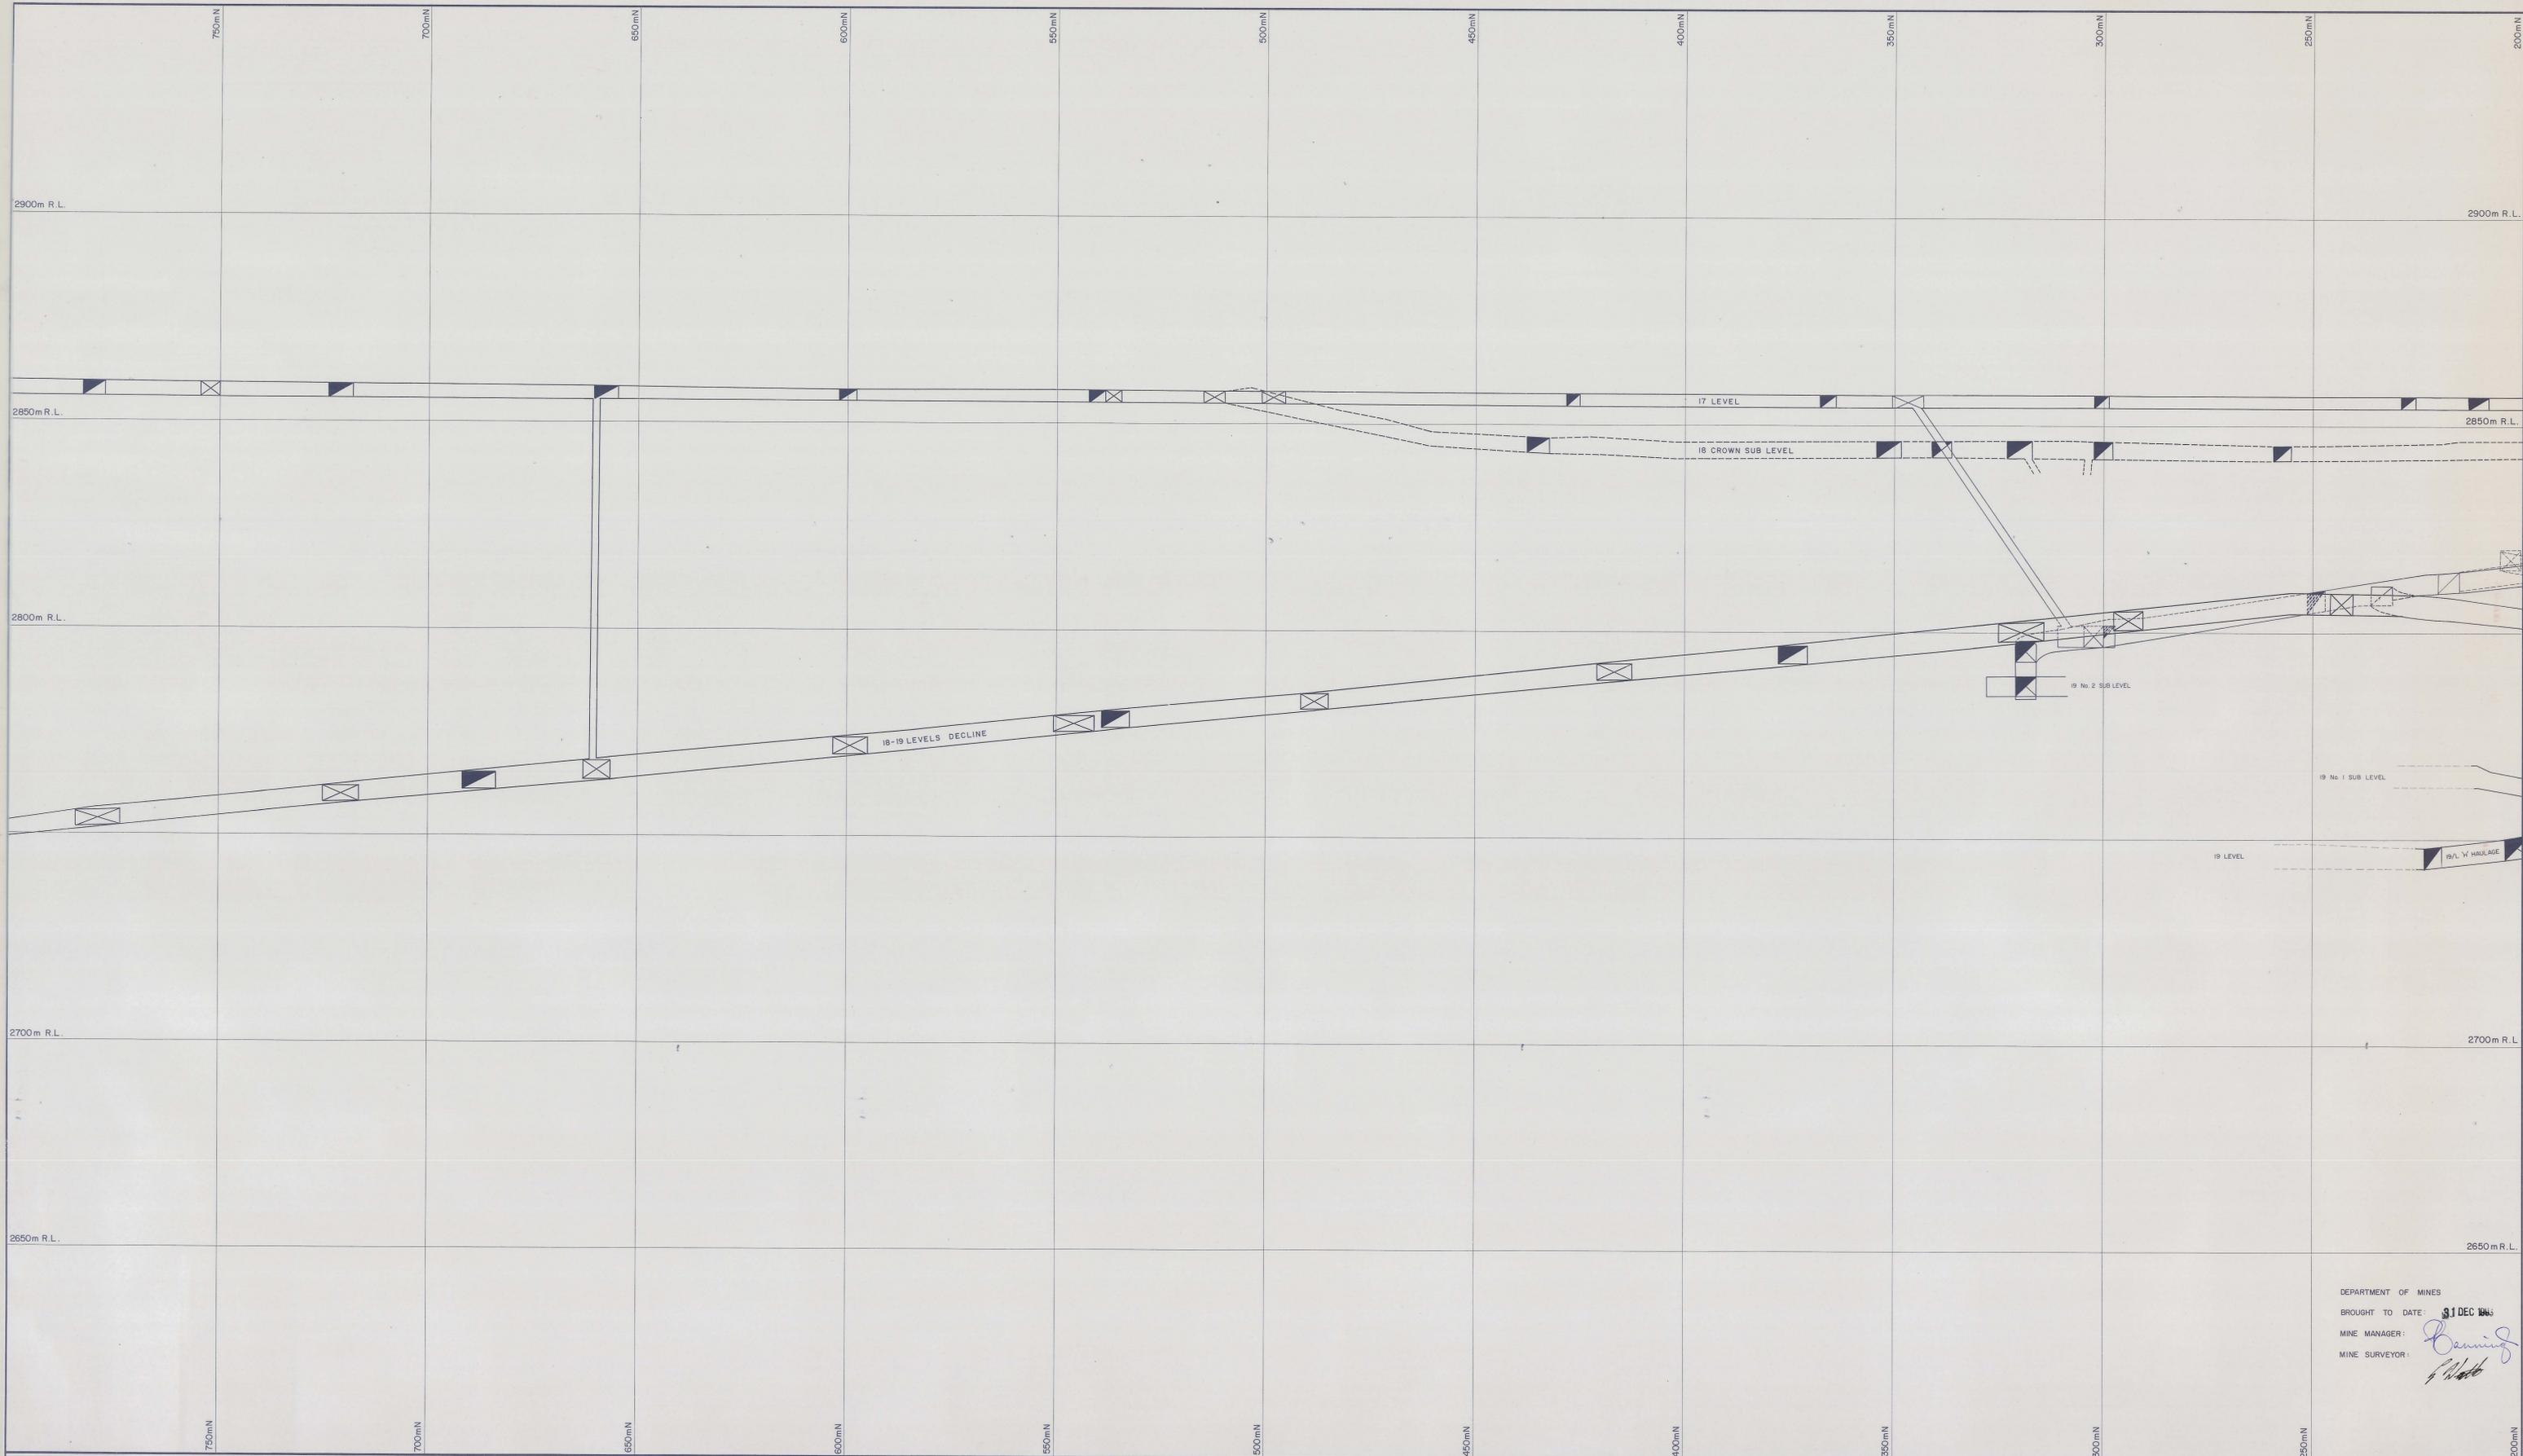

DEPARTMENT OF MINES
 BROUGHT TO DATE: 31 DEC 82
 MINE MANAGER: *[Signature]*
 MINE SURVEYOR: *[Signature]*

ELECTROLYTIC ZINC COMPANY OF AUSTRALASIA LIMITED
 WEST COAST MINES, T.A.S.
 A.C.N. 004 074 962

SURVEY BY		SCALE	1:500
DRAWN BY		DATE	24-09-82
TRACED BY		REFERENCE	

ROSEBERY MINE
 LONGITUDINAL PROJECTION
 DECLINE SPECIAL

DRAWING N°:
 DEPARTMENT OF MINES

