


0055-182

DEPARTMENT OF MINES TASMANIA
 PLANS RECEIVED UNDER SECTION 311 MINES INSPECTION ACT
 AS ORDERED IN D.O. 63569 & 62
 ELECTROLYTIC ZINC CO. OF AUSTRALIA LTD.
 HERCULES No. 6 LEVEL
 Co. Ref. WORKINGS AT 12/84

BROUGHT TO DATE : 31 DEC 1984
 MINE MANAGER : *R. ...*
 MINE SURVEYOR : *P. ...*

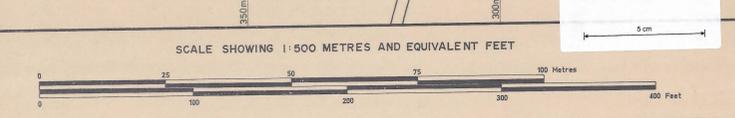

ELECTROLYTIC ZINC COMPANY OF AUSTRALASIA LIMITED
 WEST COAST MINES, TAS.

SURVEY BY		SCALE	1 : 500 METRES
DRAWN BY		DATE	1973
TRACED BY	P. J. Lowe	REFERENCE	

HERCULES MINE
 No 6 LEVEL

DRAWING No :
 DEPARTMENT OF MINES
 PLAN