


0050-5500

DEPARTMENT OF MINES TASMANIA
 PLANS RECEIVED UNDER SECTION 31 MINES INSPECTION ACT
 ELECTROLYTIC ZINC CO. OF AUSTRALASIA LTD.
 HERCULES No. 7 LEVEL
 Co. Ref. WORKINGS AT 12/84

BROUGHT TO DATE : 31 DEC 1984
 MINE MANAGER : *B. ...*
 MINE SURVEYOR : *G.M.B.*

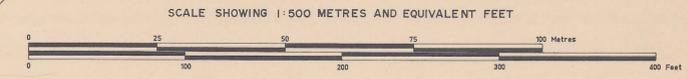

ELECTROLYTIC ZINC COMPANY OF AUSTRALASIA LIMITED
 WEST COAST MINES, T.A.S.

SURVEY BY	SCALE	1:500
DRAWN BY	DATE	20.3.80
TRACED BY G. M. BENNETT	REFERENCE	

HERCULES MINE
 No. 7 LEVEL (2)

DRAWING No. :