

0055-188

# ELECTROLYTIC ZINC COMPANY OF AUSTRALASIA LIMITED

WEST COAST MINES

A.C.N. 004 074 962

DEPT.



By	Date
N.W.D.S.	27-11-90
Drawn	
Traced	
Checked	
Approved	

ROSEBURY MINE  
**DECLINE**

SCALE: 1:500	FILE:
DESIGN:	DRAWING No.
SURVEY:	No.

Revisions			Details			App.			References		
No.	By	Date									

DEPARTMENT OF MINES  
 BROUGHT TO DATE 31 DEC 1991  
 MINE MANAGER *[Signature]*  
 MINE SURVEYOR *[Signature]*

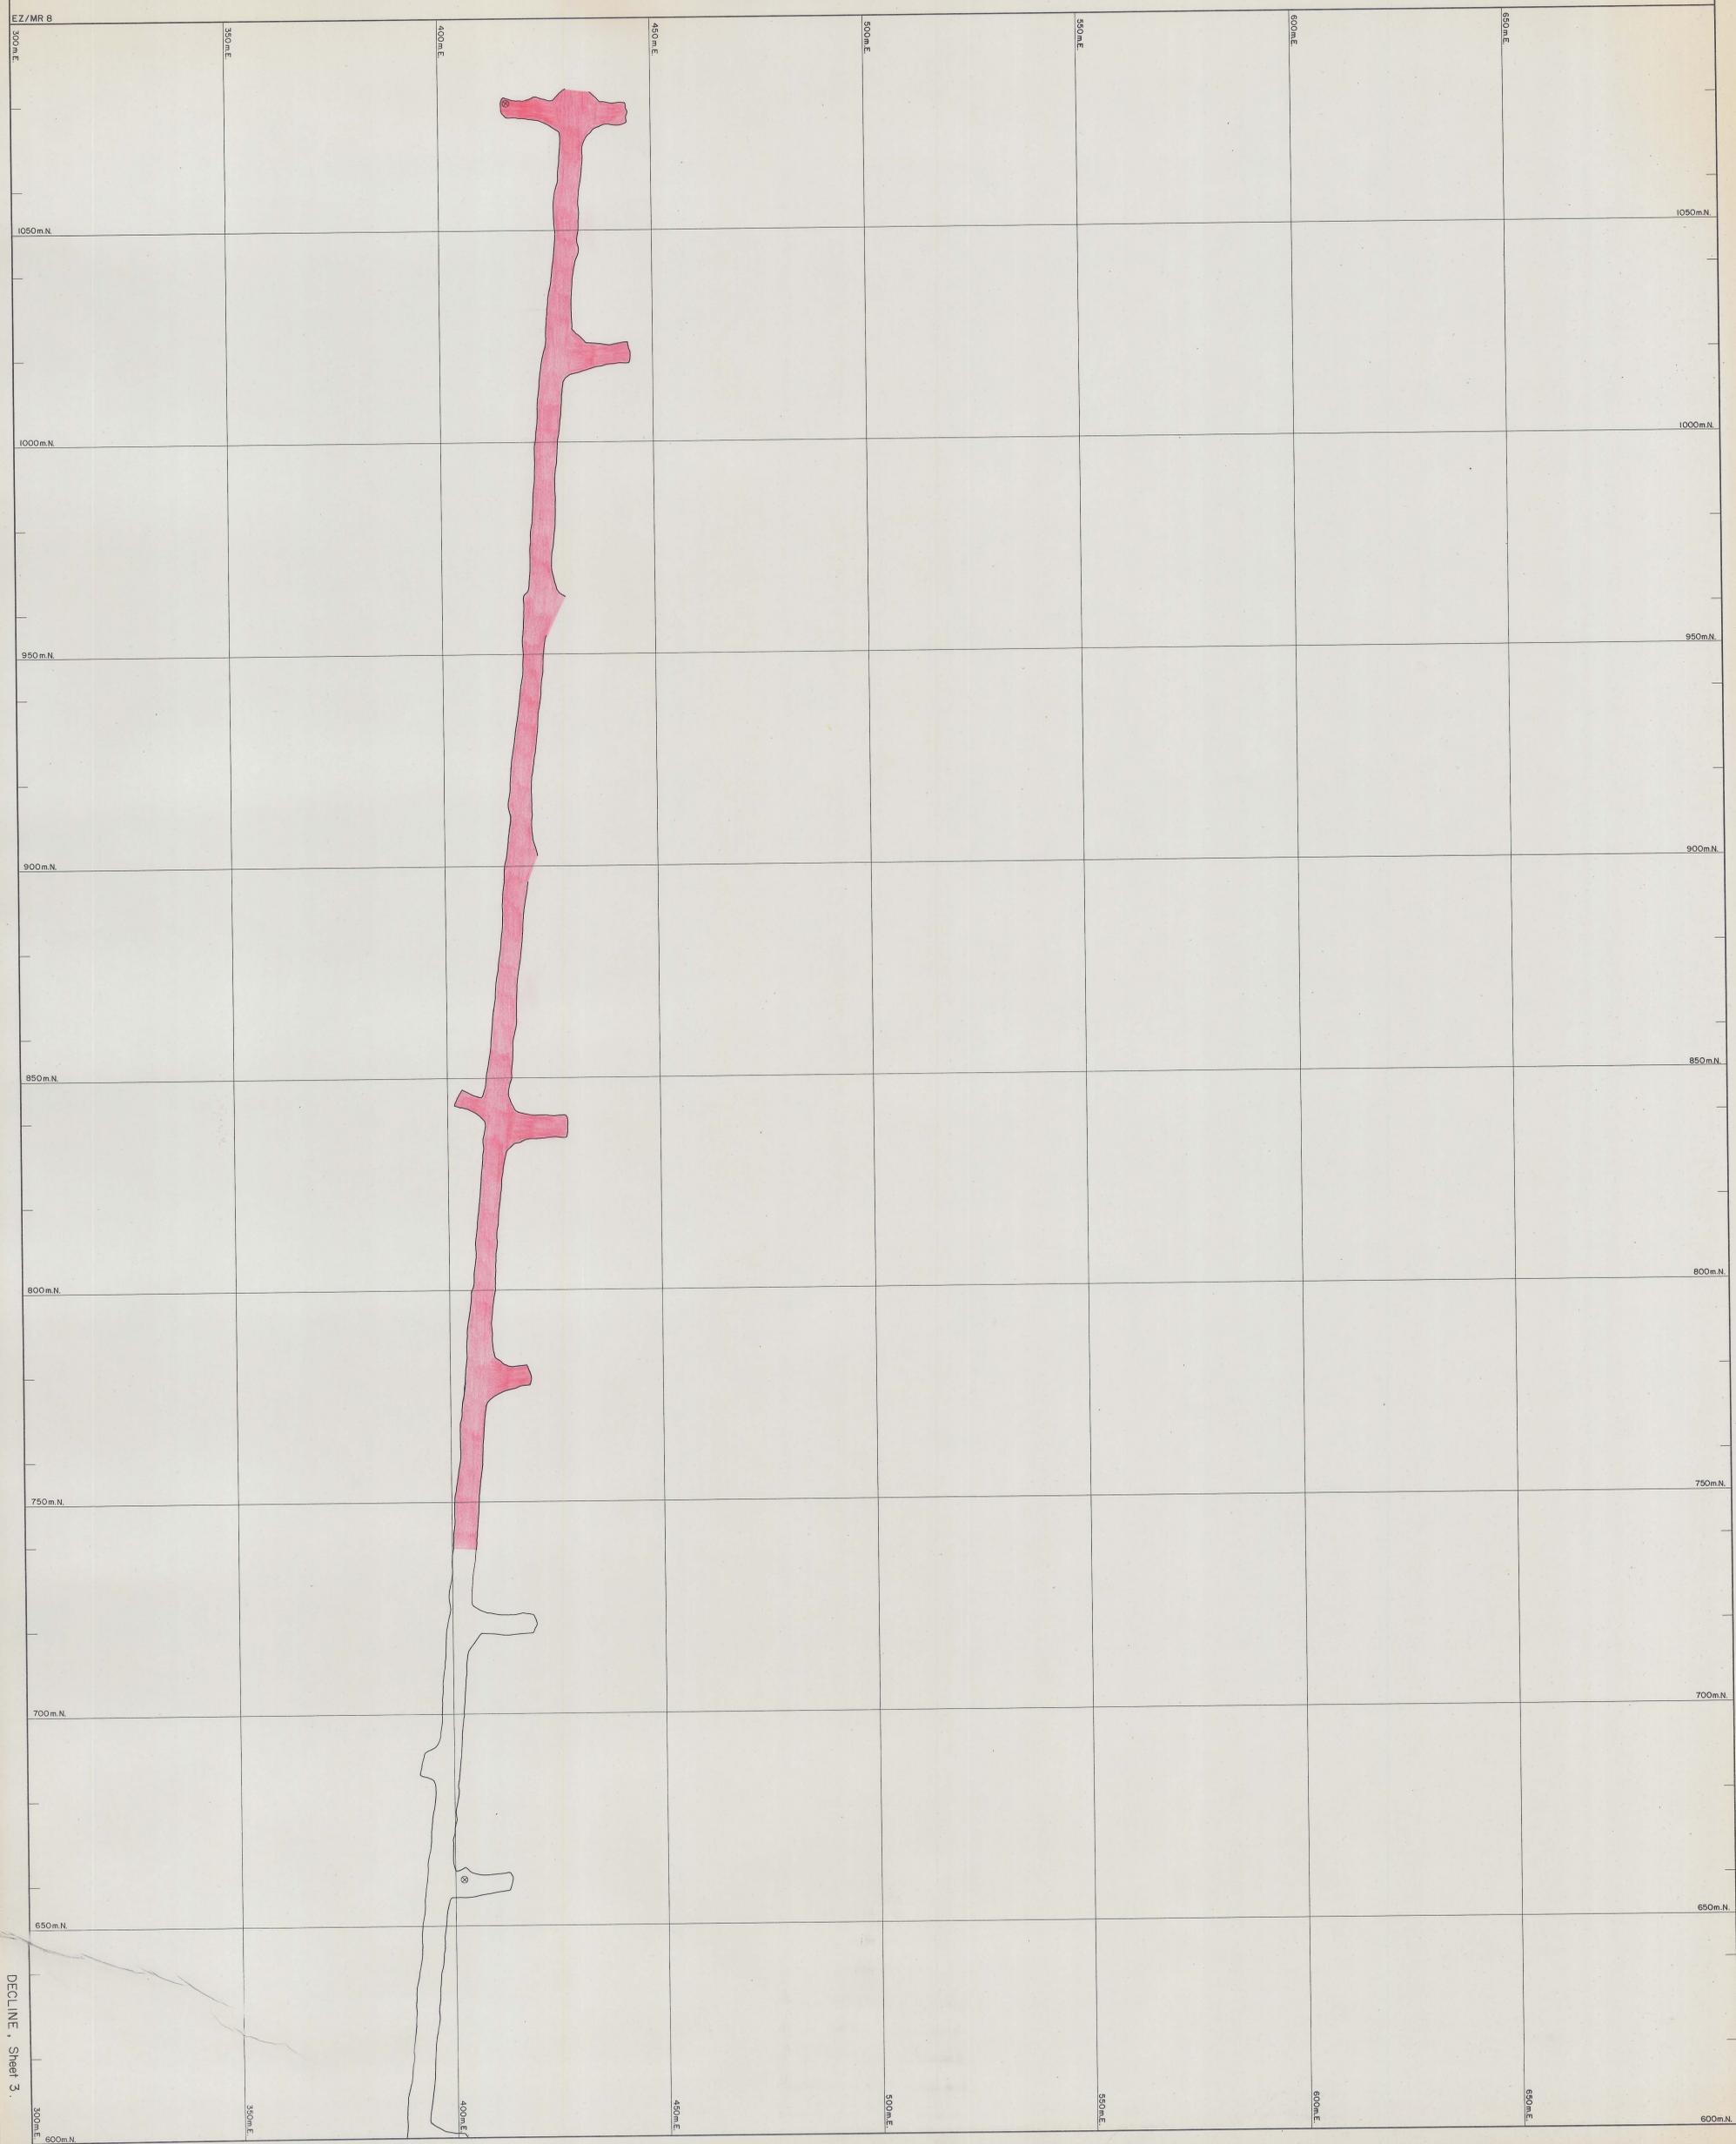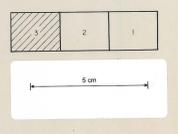

DECLINE, Sheet 3.