

0055-190

ELECTROLYTIC ZINC COMPANY

OF AUSTRALASIA LIMITED

ROSEBERY

A.C.N. 004 074 962

MINE TECHNICAL SERVICES



By	Date
Drawn	08-FEB-90
Traced	
Checked	
Approved	

ROSEBERY MINE
19 LEVEL
SHEET 2

SCALE: 1:500	FILE:
DESIGN:	DRAWING No.
SURVEY:	No

Revisions	Details			App.			References		
	No	By	Date	No	By	Date	No	By	Date

DEPARTMENT OF MINES
BROUGHT TO DATE 31 DEC 1991
MINE MANAGER: *[Signature]*
MINE SURVEYOR: *[Signature]*

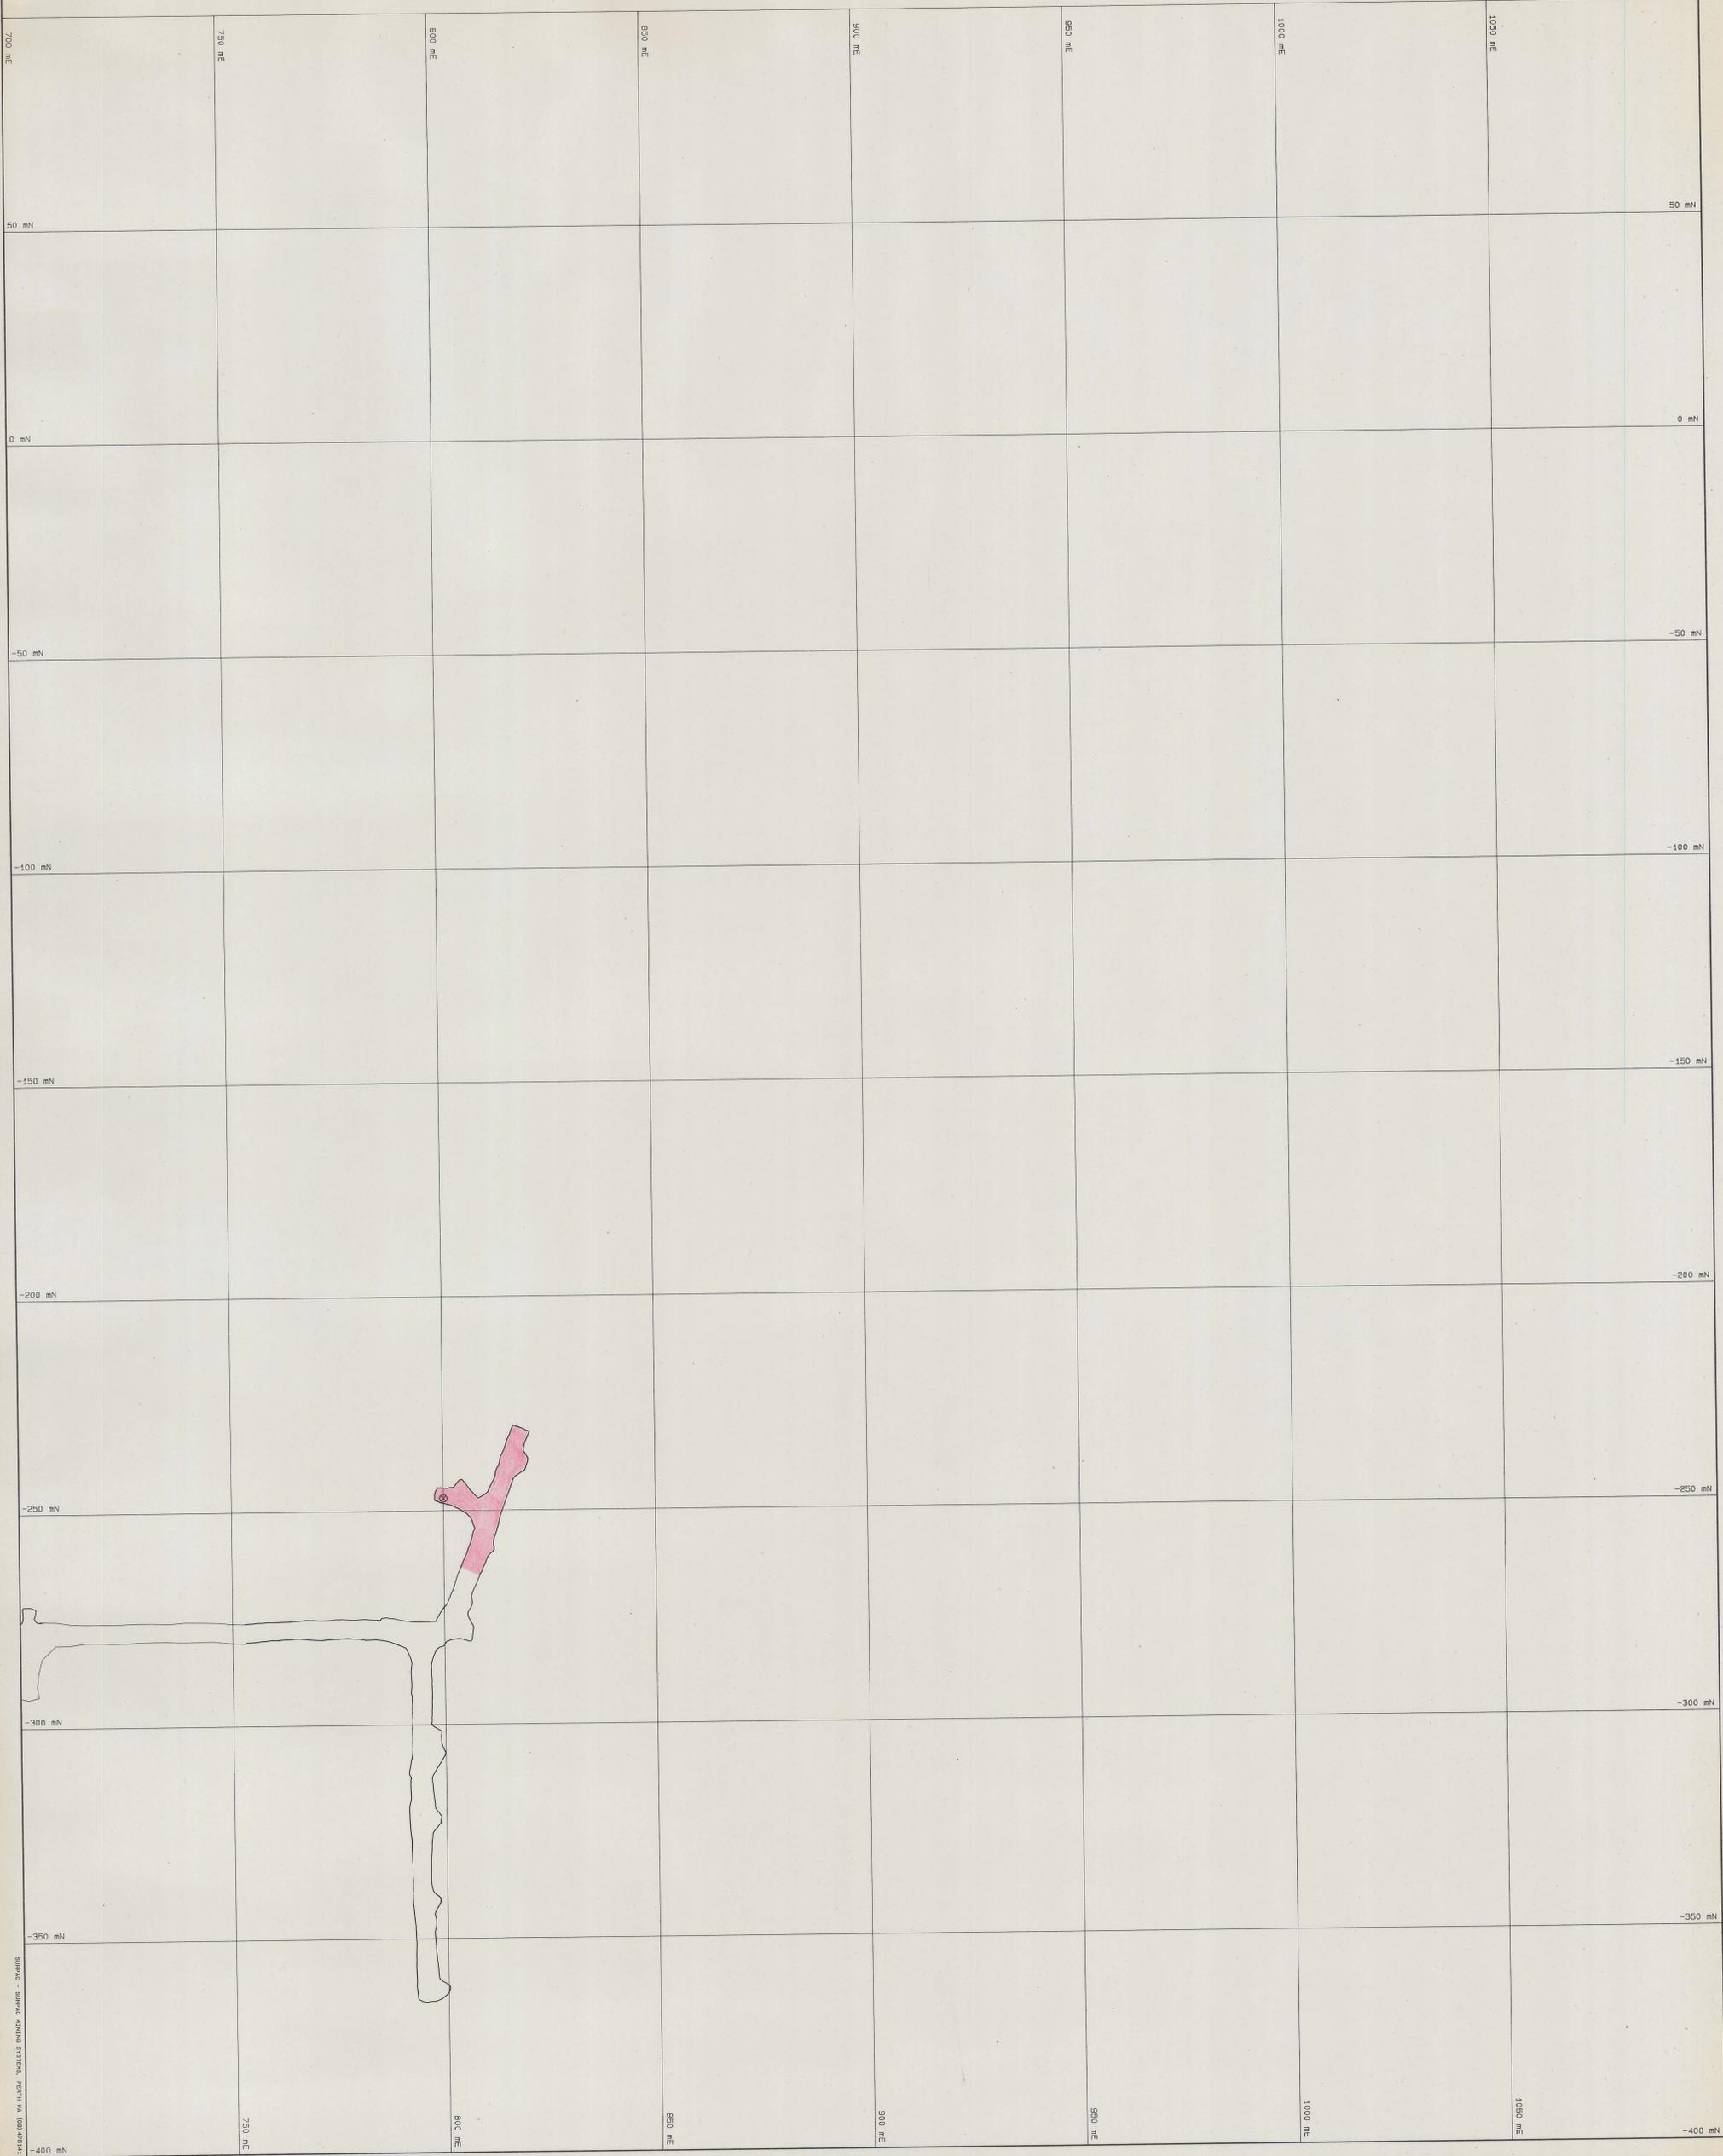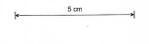

Scale: 1:500