

0055-182

# PASMINCO MINING - Rosebery

A.C.N. 004 074 962

	By	Date
Drawn		05-DEC-91
Traced		
Checked		
Approved		

ROSEBERY MINE

20 LEVEL

J LENS

SCALE: 1:500	FILE:
DESIGN:	DRAWING No.
SURVEY:	


Revisions	No			By			Date			Details			App			References		
	No	By	Date	No	By	Date	No	By	Date	No	By	Date	No	By	Date	No	By	Date

DEPARTMENT OF MINES

BOUGHT TO DATE: 31 DEC 1991

MINE MANAGER *[Signature]*

MINE SURVEYOR *[Signature]*

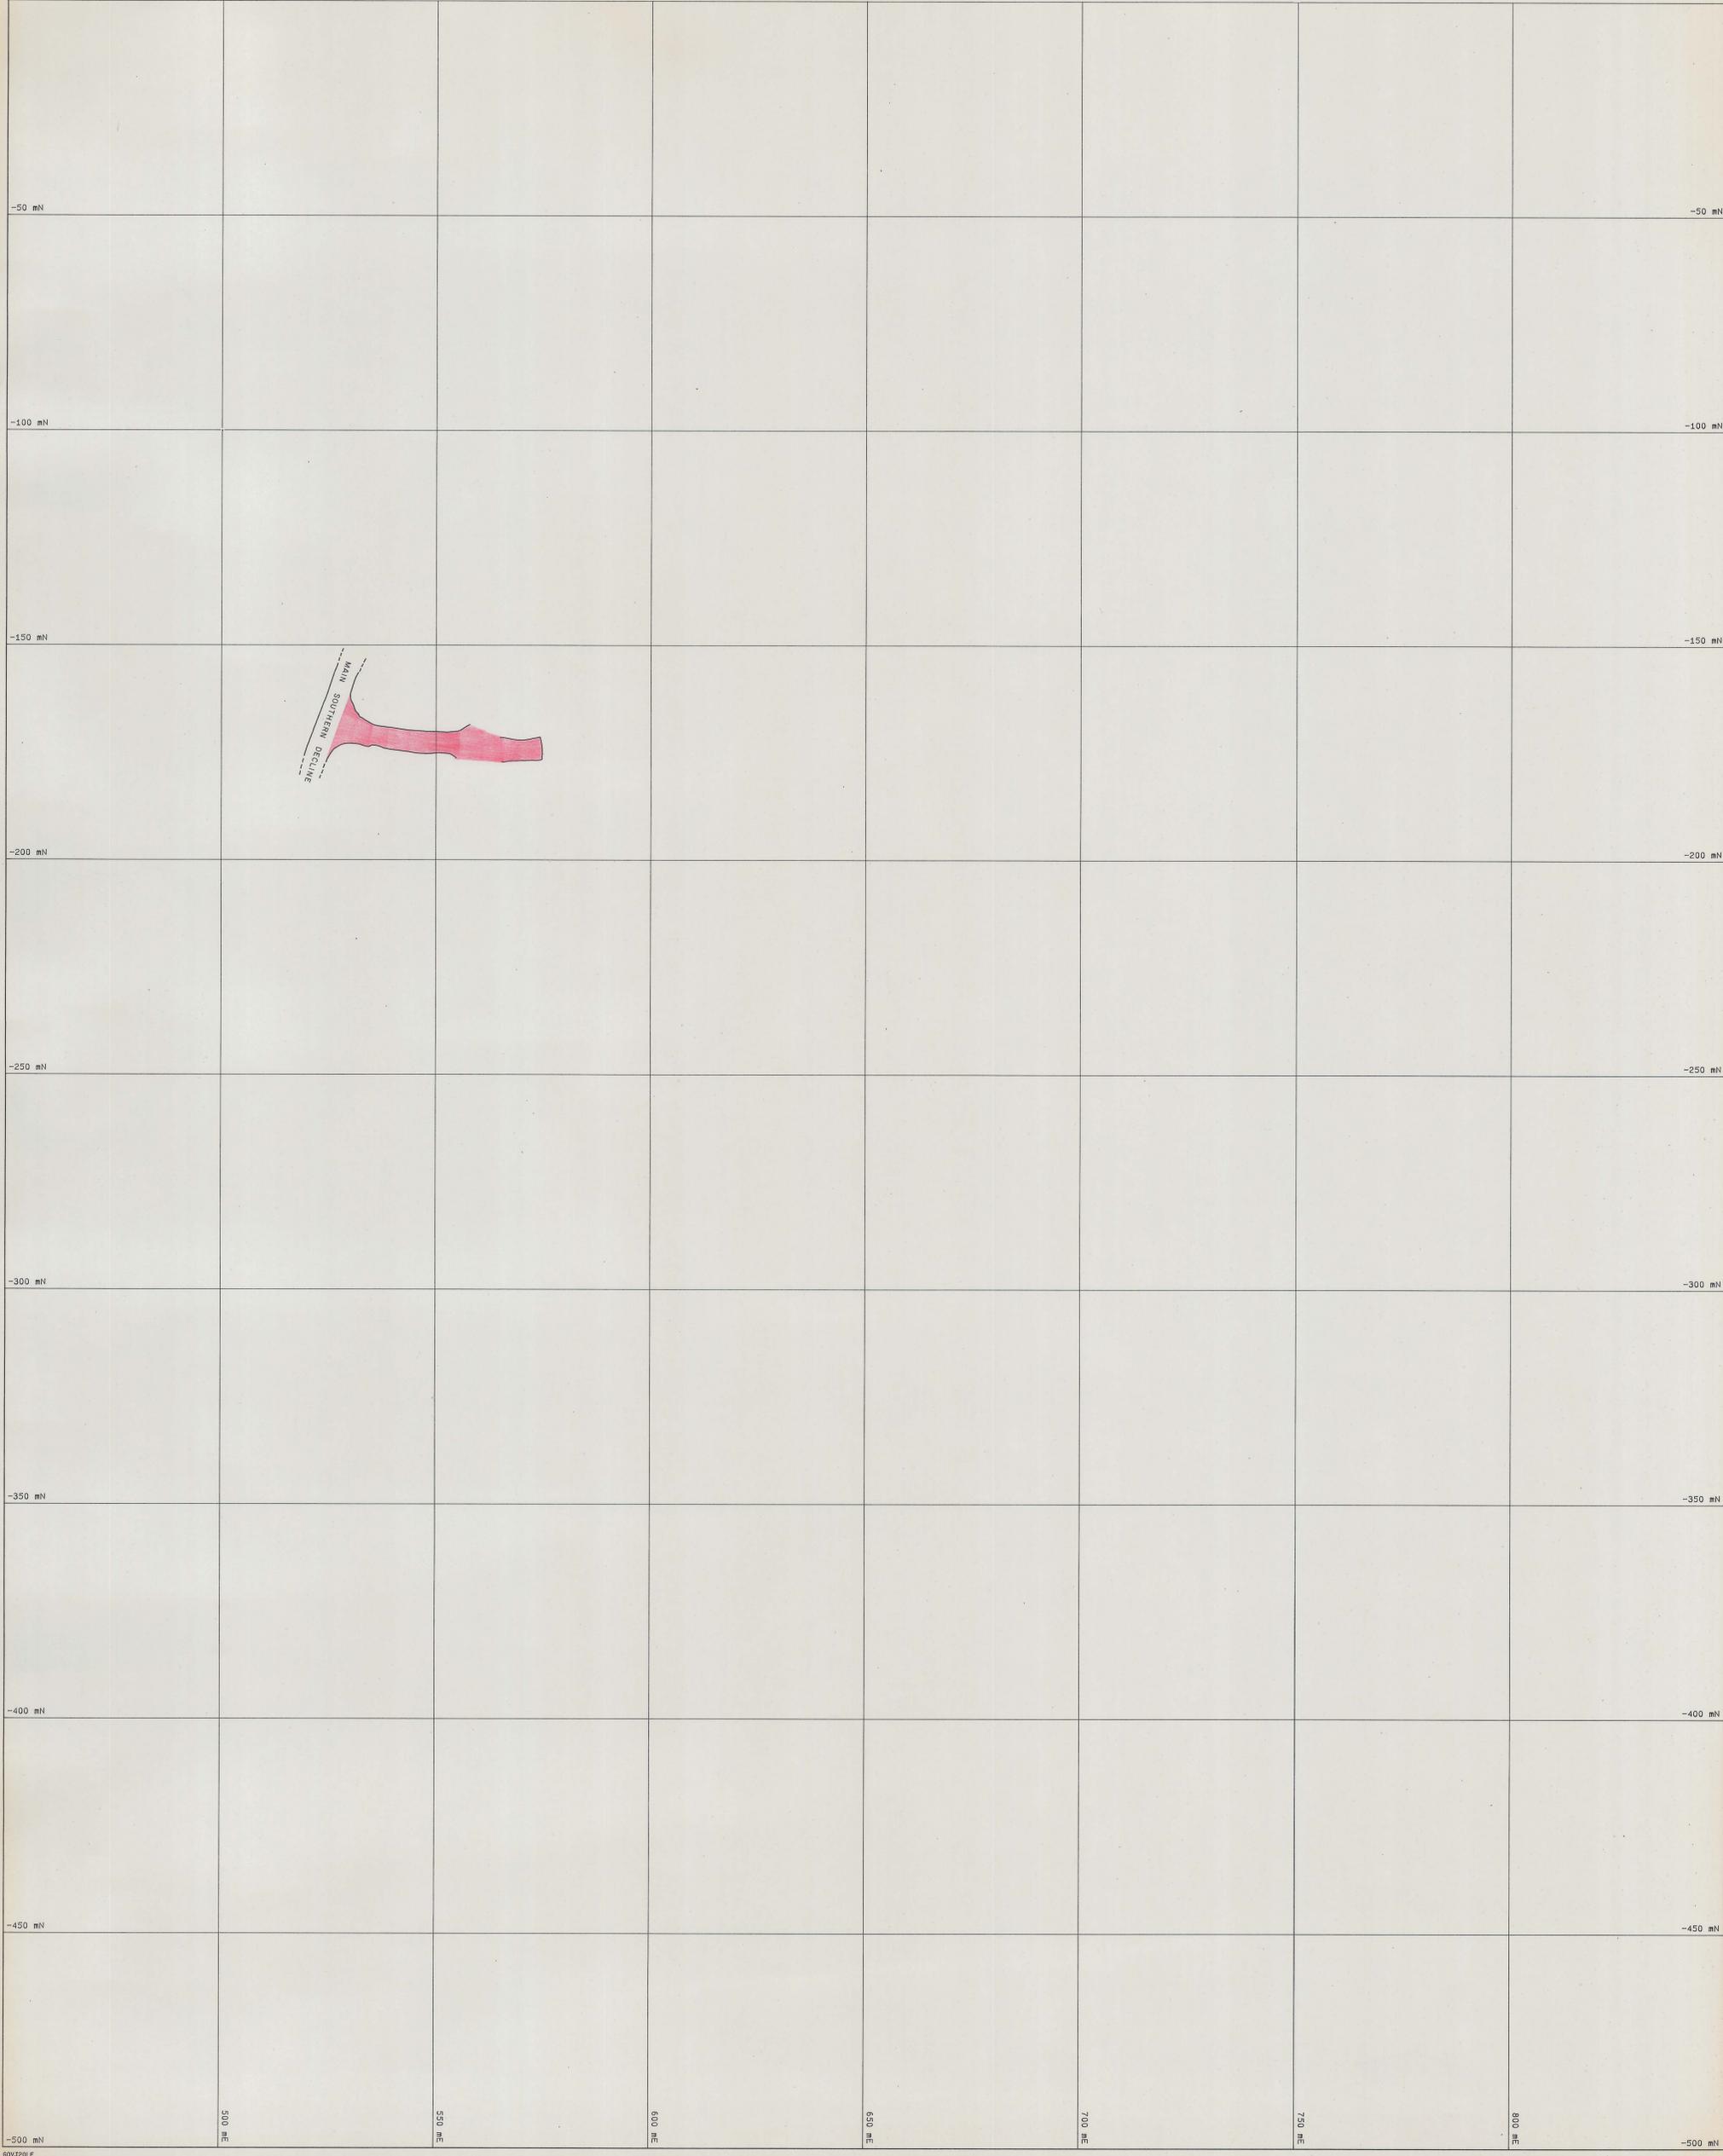

001204P  
500 ME  
550 ME  
600 ME  
650 ME  
700 ME  
750 ME  
800 ME  
-500 mN