


00 S.S. - 184

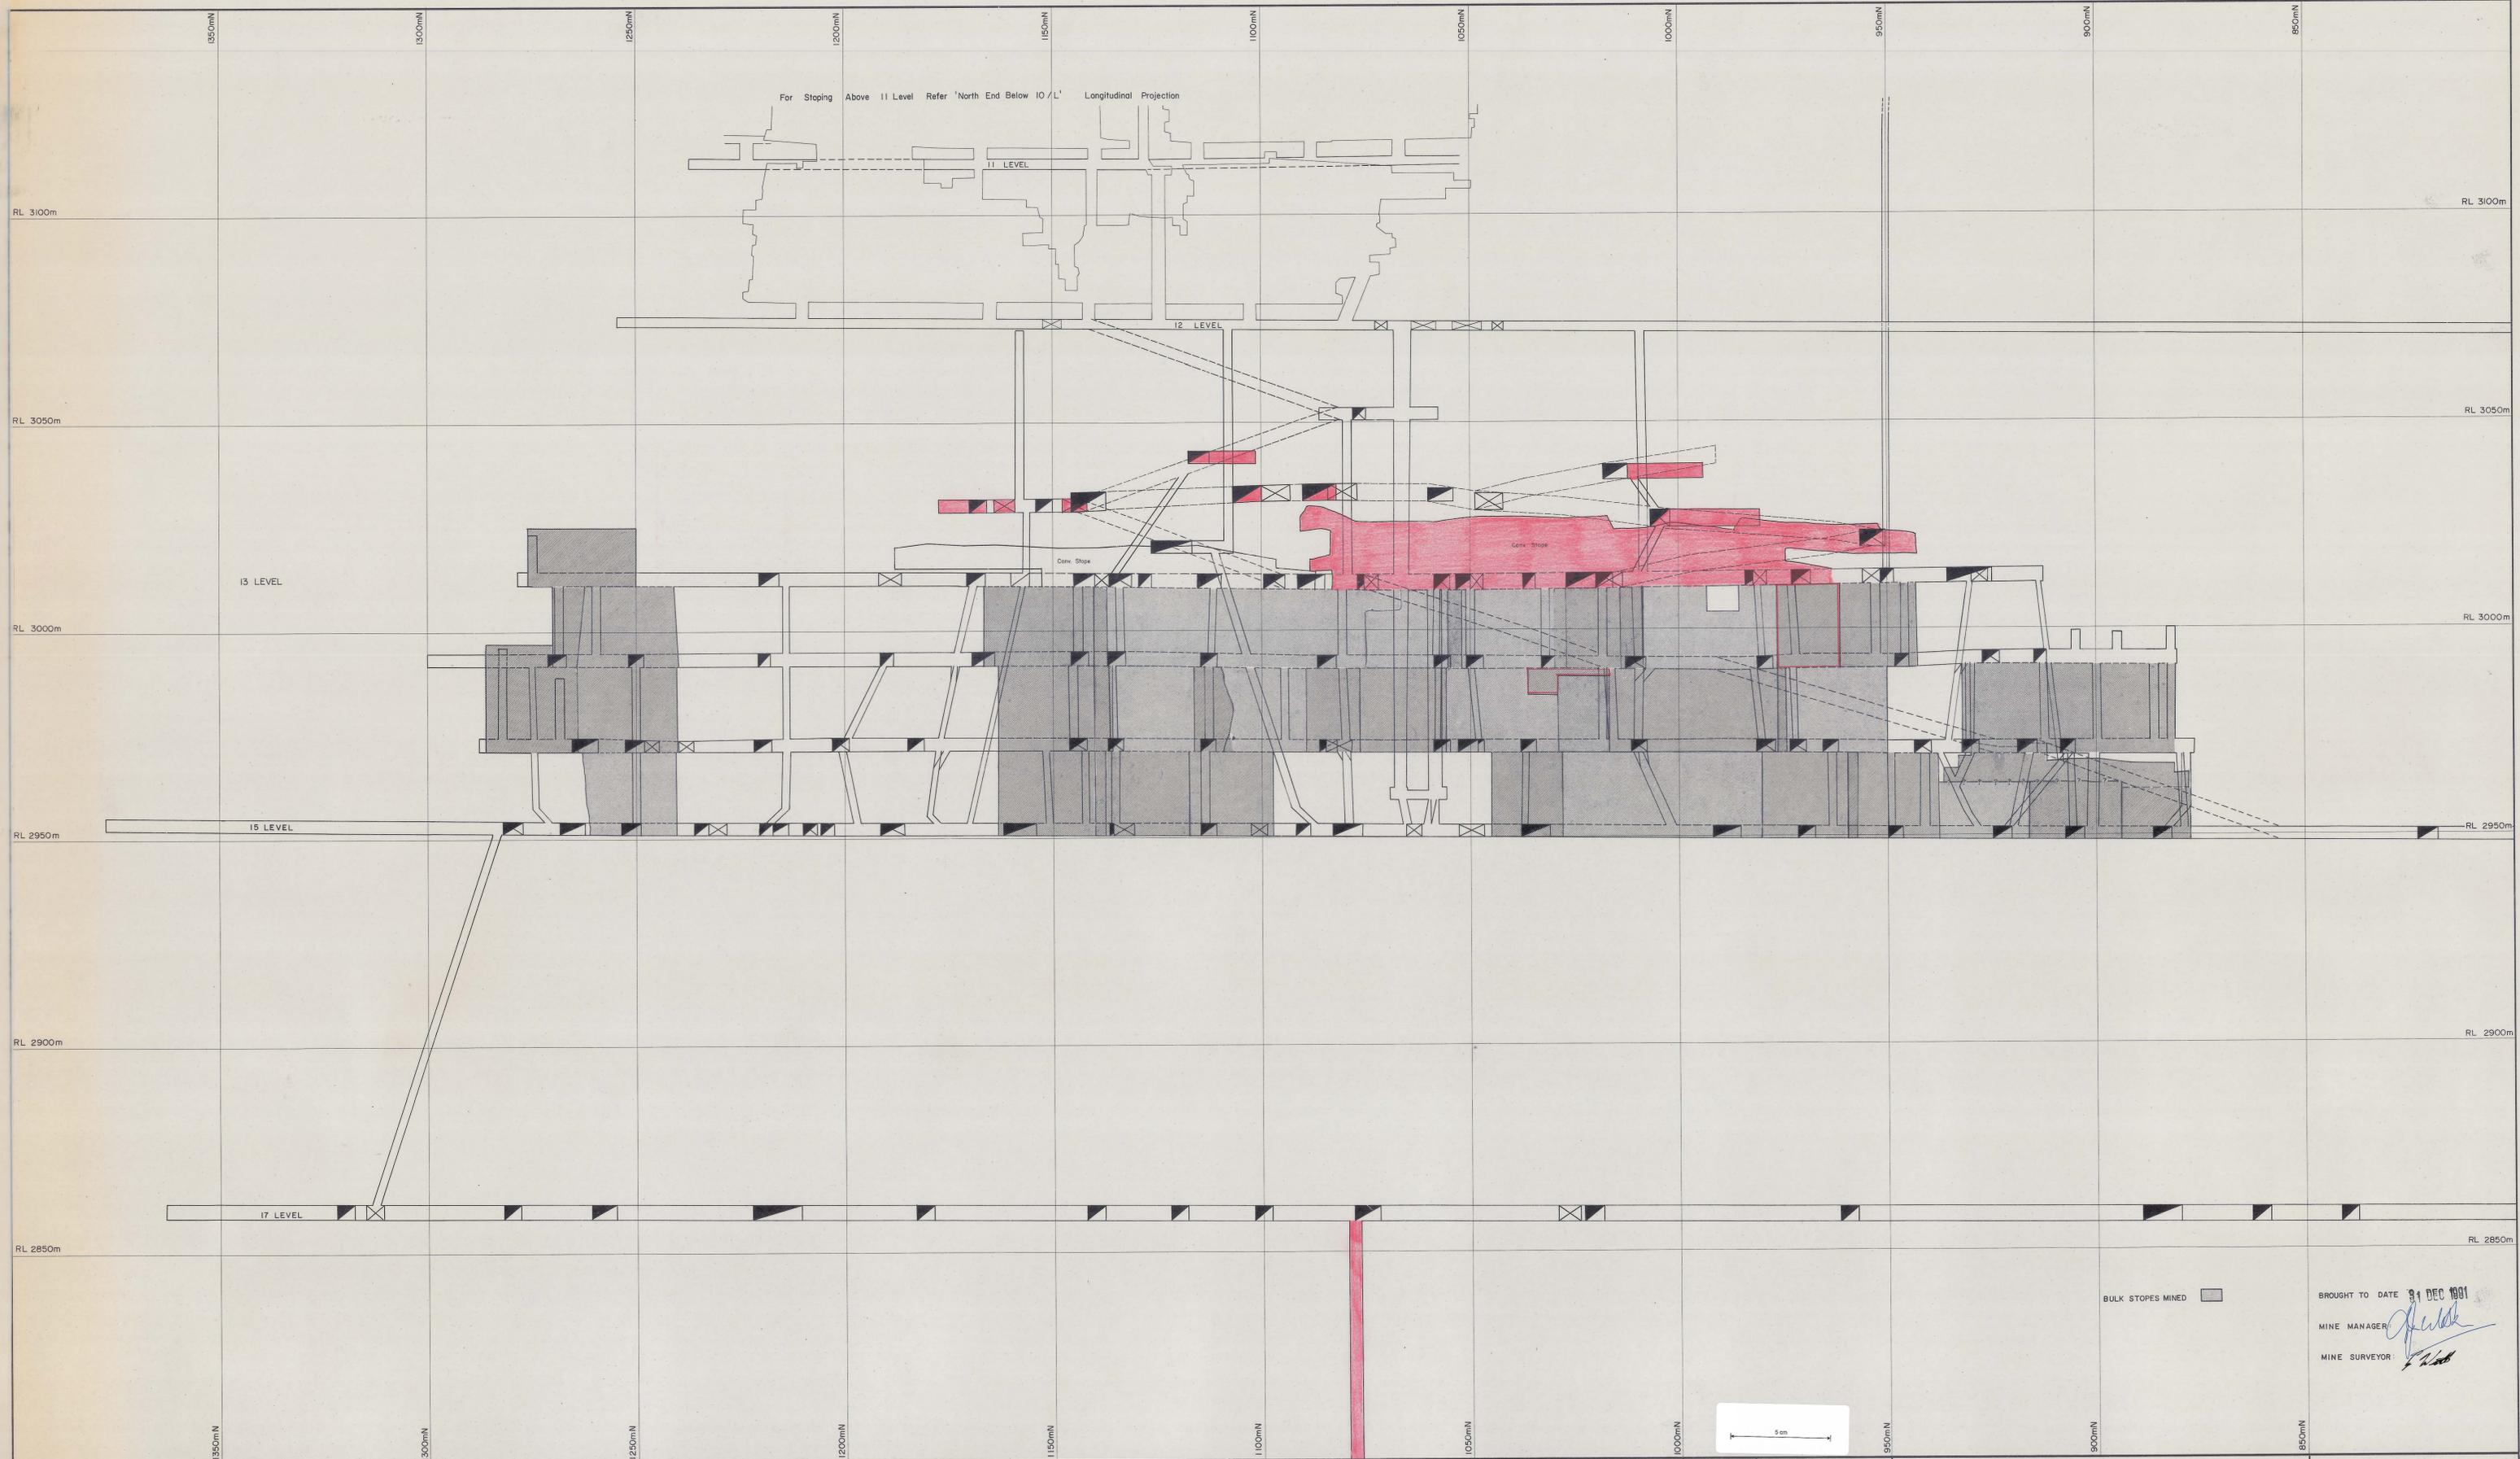

SCALE SHOWING 1:500 METRES AND EQUIVALENT FEET

0 25 50 75 100 Metres

0 100 200 300 400 Feet

ELECTROLYTIC ZINC COMPANY OF AUSTRALASIA LIMITED

WEST COAST MINES, T.A.S.

A.C.N. 004 074 962

SURVEY BY		SCALE	1:500
DRAWN BY	A. G. MORRISON	DATE	19 01 79
TRACED BY	A. G. M.	REFERENCE	

ROSEBERY MINE

LONGITUDINAL PROJECTION

800mN-1400mN - BELOW 10/L

BROUGHT TO DATE 31 DEC 1991

MINE MANAGER *[Signature]*

MINE SURVEYOR *[Signature]*

DRAWING NO: _____

DEPARTMENT OF MINES