



00 S.S. - 185

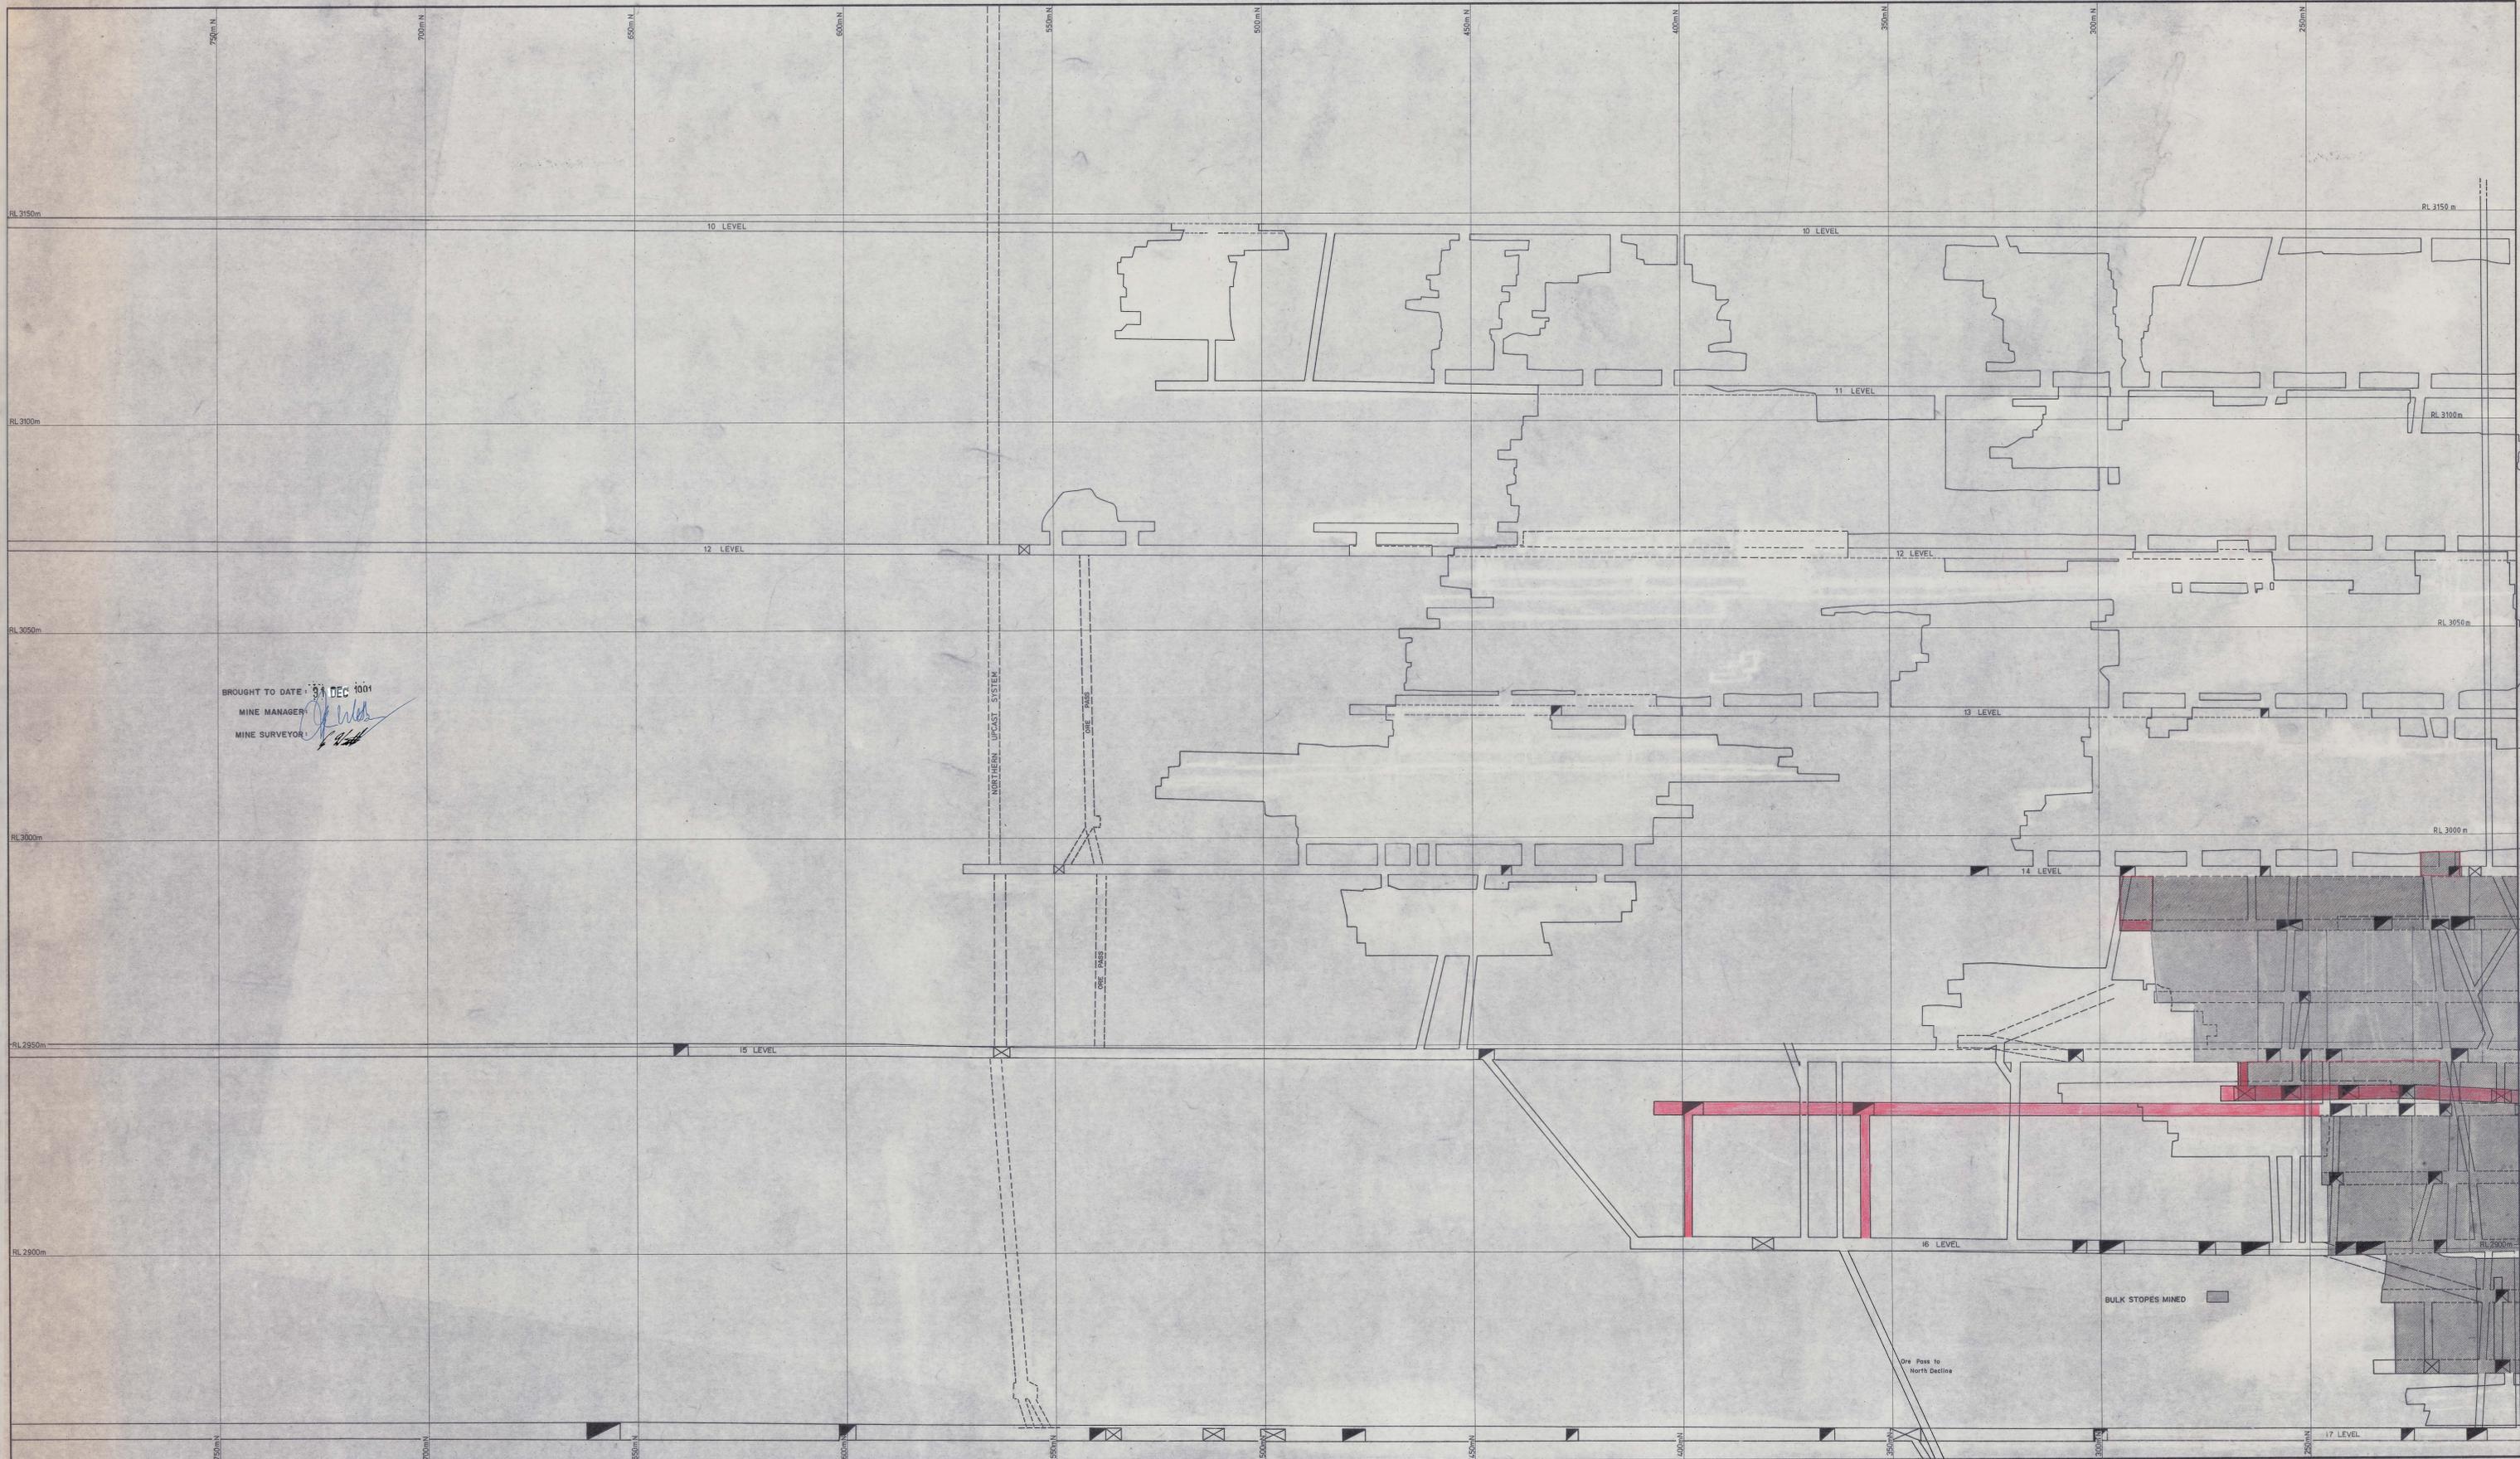

BROUGHT TO DATE: 31 DEC 1001
 MINE MANAGER: *[Signature]*
 MINE SURVEYOR: *[Signature]*

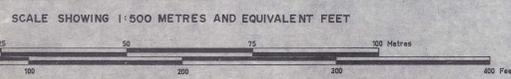

ELECTROLYTIC ZINC COMPANY OF AUSTRALASIA LIMITED
 WEST COAST MINES, T.A.S.
 A.C.N. 004 074 962

SURVEY BY	SCALE	1 : 500
DRAWN BY	DATE	1973
TRACED BY P. J. Lowe	REFERENCE	

ROSEBERY MINE
 LONGITUDINAL PROJECTION
 200mN - 800mN — BELOW 10/L.

DRAWING NO.:
 DEPARTMENT OF MINES