
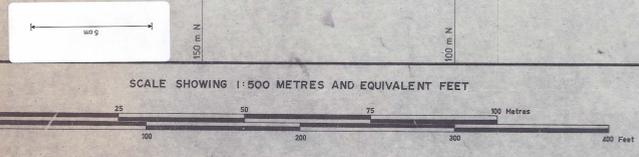


0055-186

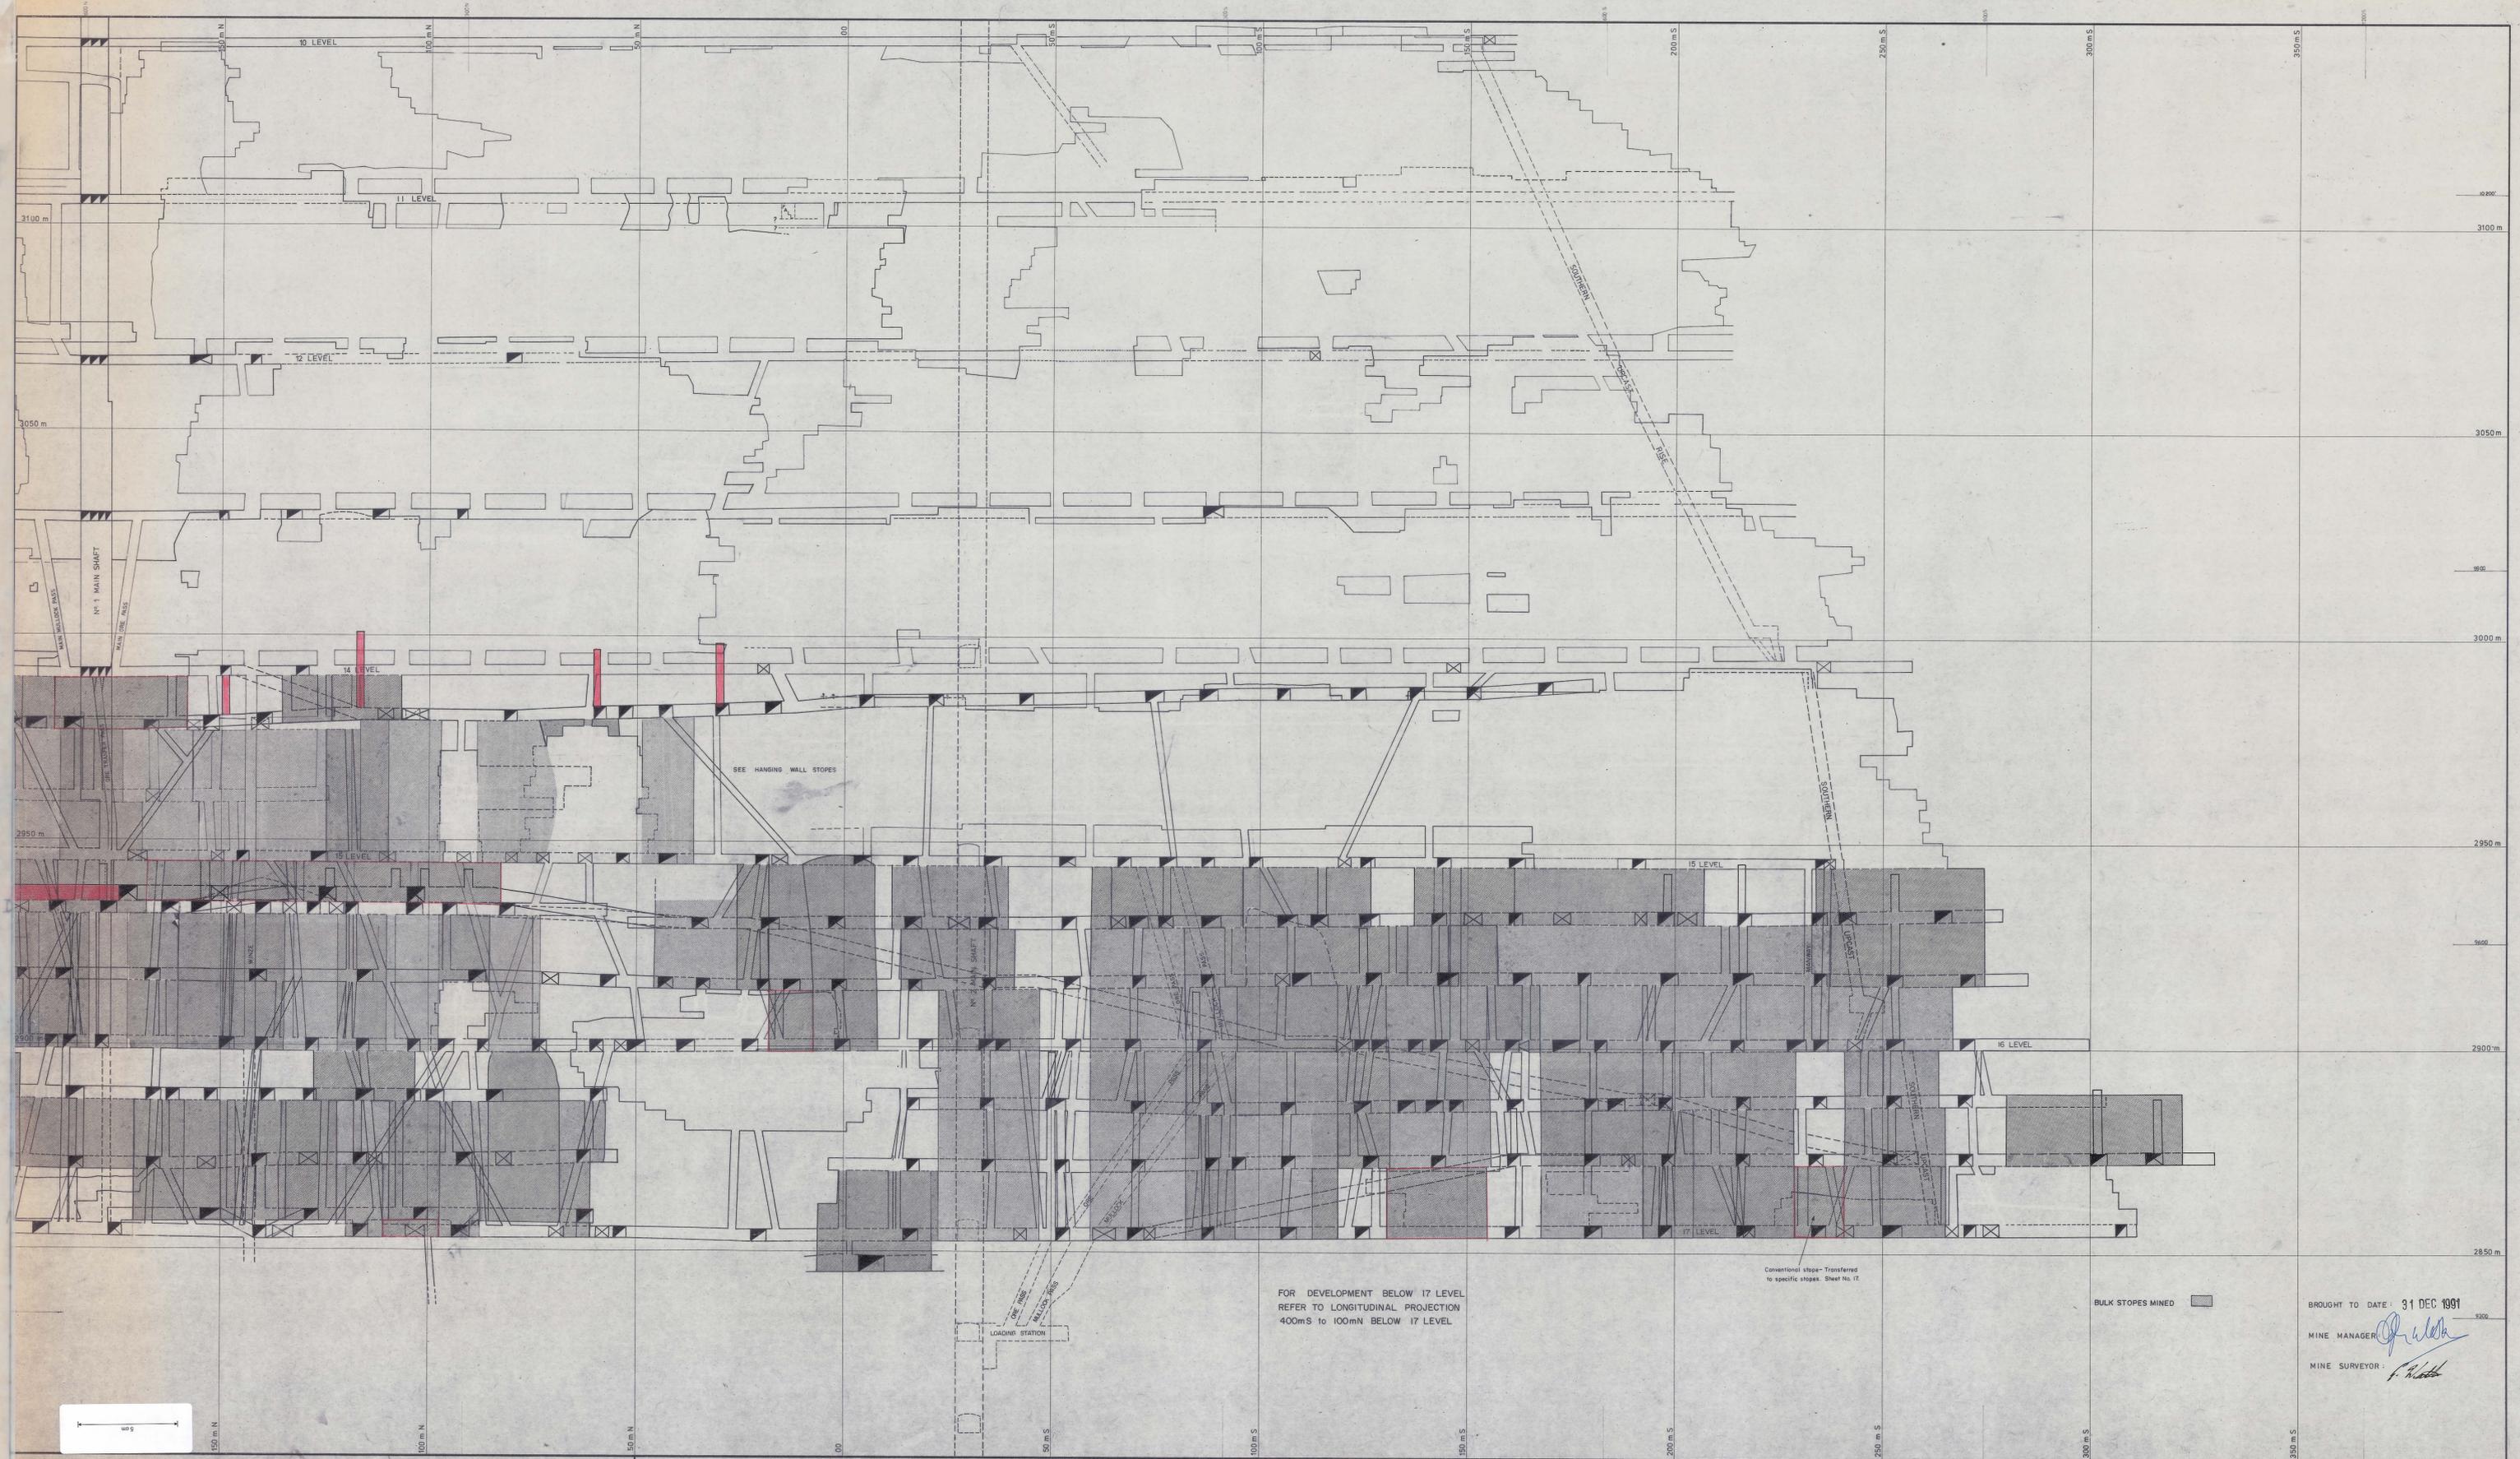

ELECTROLYTIC ZINC COMPANY OF AUSTRALASIA LIMITED
 WEST COAST MINES, T.A.S.
 A.C.N. 004 074 982

SURVEY BY		SCALE	1:500 metres
DRAWN BY		DATE	1973
TRACED BY	S.M. Burrows	REFERENCE	

ROSEBERY MINE
 LONGITUDINAL PROJECTION
 400mS-200mN - BELOW 10/L

BROUGHT TO DATE: 31 DEC 1991
 MINE MANAGER: *[Signature]*
 MINE SURVEYOR: *[Signature]*

DRAWING N°:
 DEPARTMENT OF MINES