

0053-199.

PASMINCO MINING - Rosebery

A.C.N. 004 074 962

	By	Date
Drawn		09-DEC-91
Traced		
Checked		
Approved		

Rosebery Mine


Longitudinal Projection

800mN - 1400mN Below 17 Level

SCALE: 1:500	FILE:
DESIGN:	DRAWING No.
SURVEY:	

Revisions	Details			App.	Details			App.	References	
	No	By	Date		No	By	Date		No	No

DEPARTMENT OF MINES
 BROUGHT TO DATE: 31 DEC 1991
 MINE MANAGER: *[Signature]*
 MINE SURVEYOR: *[Signature]*

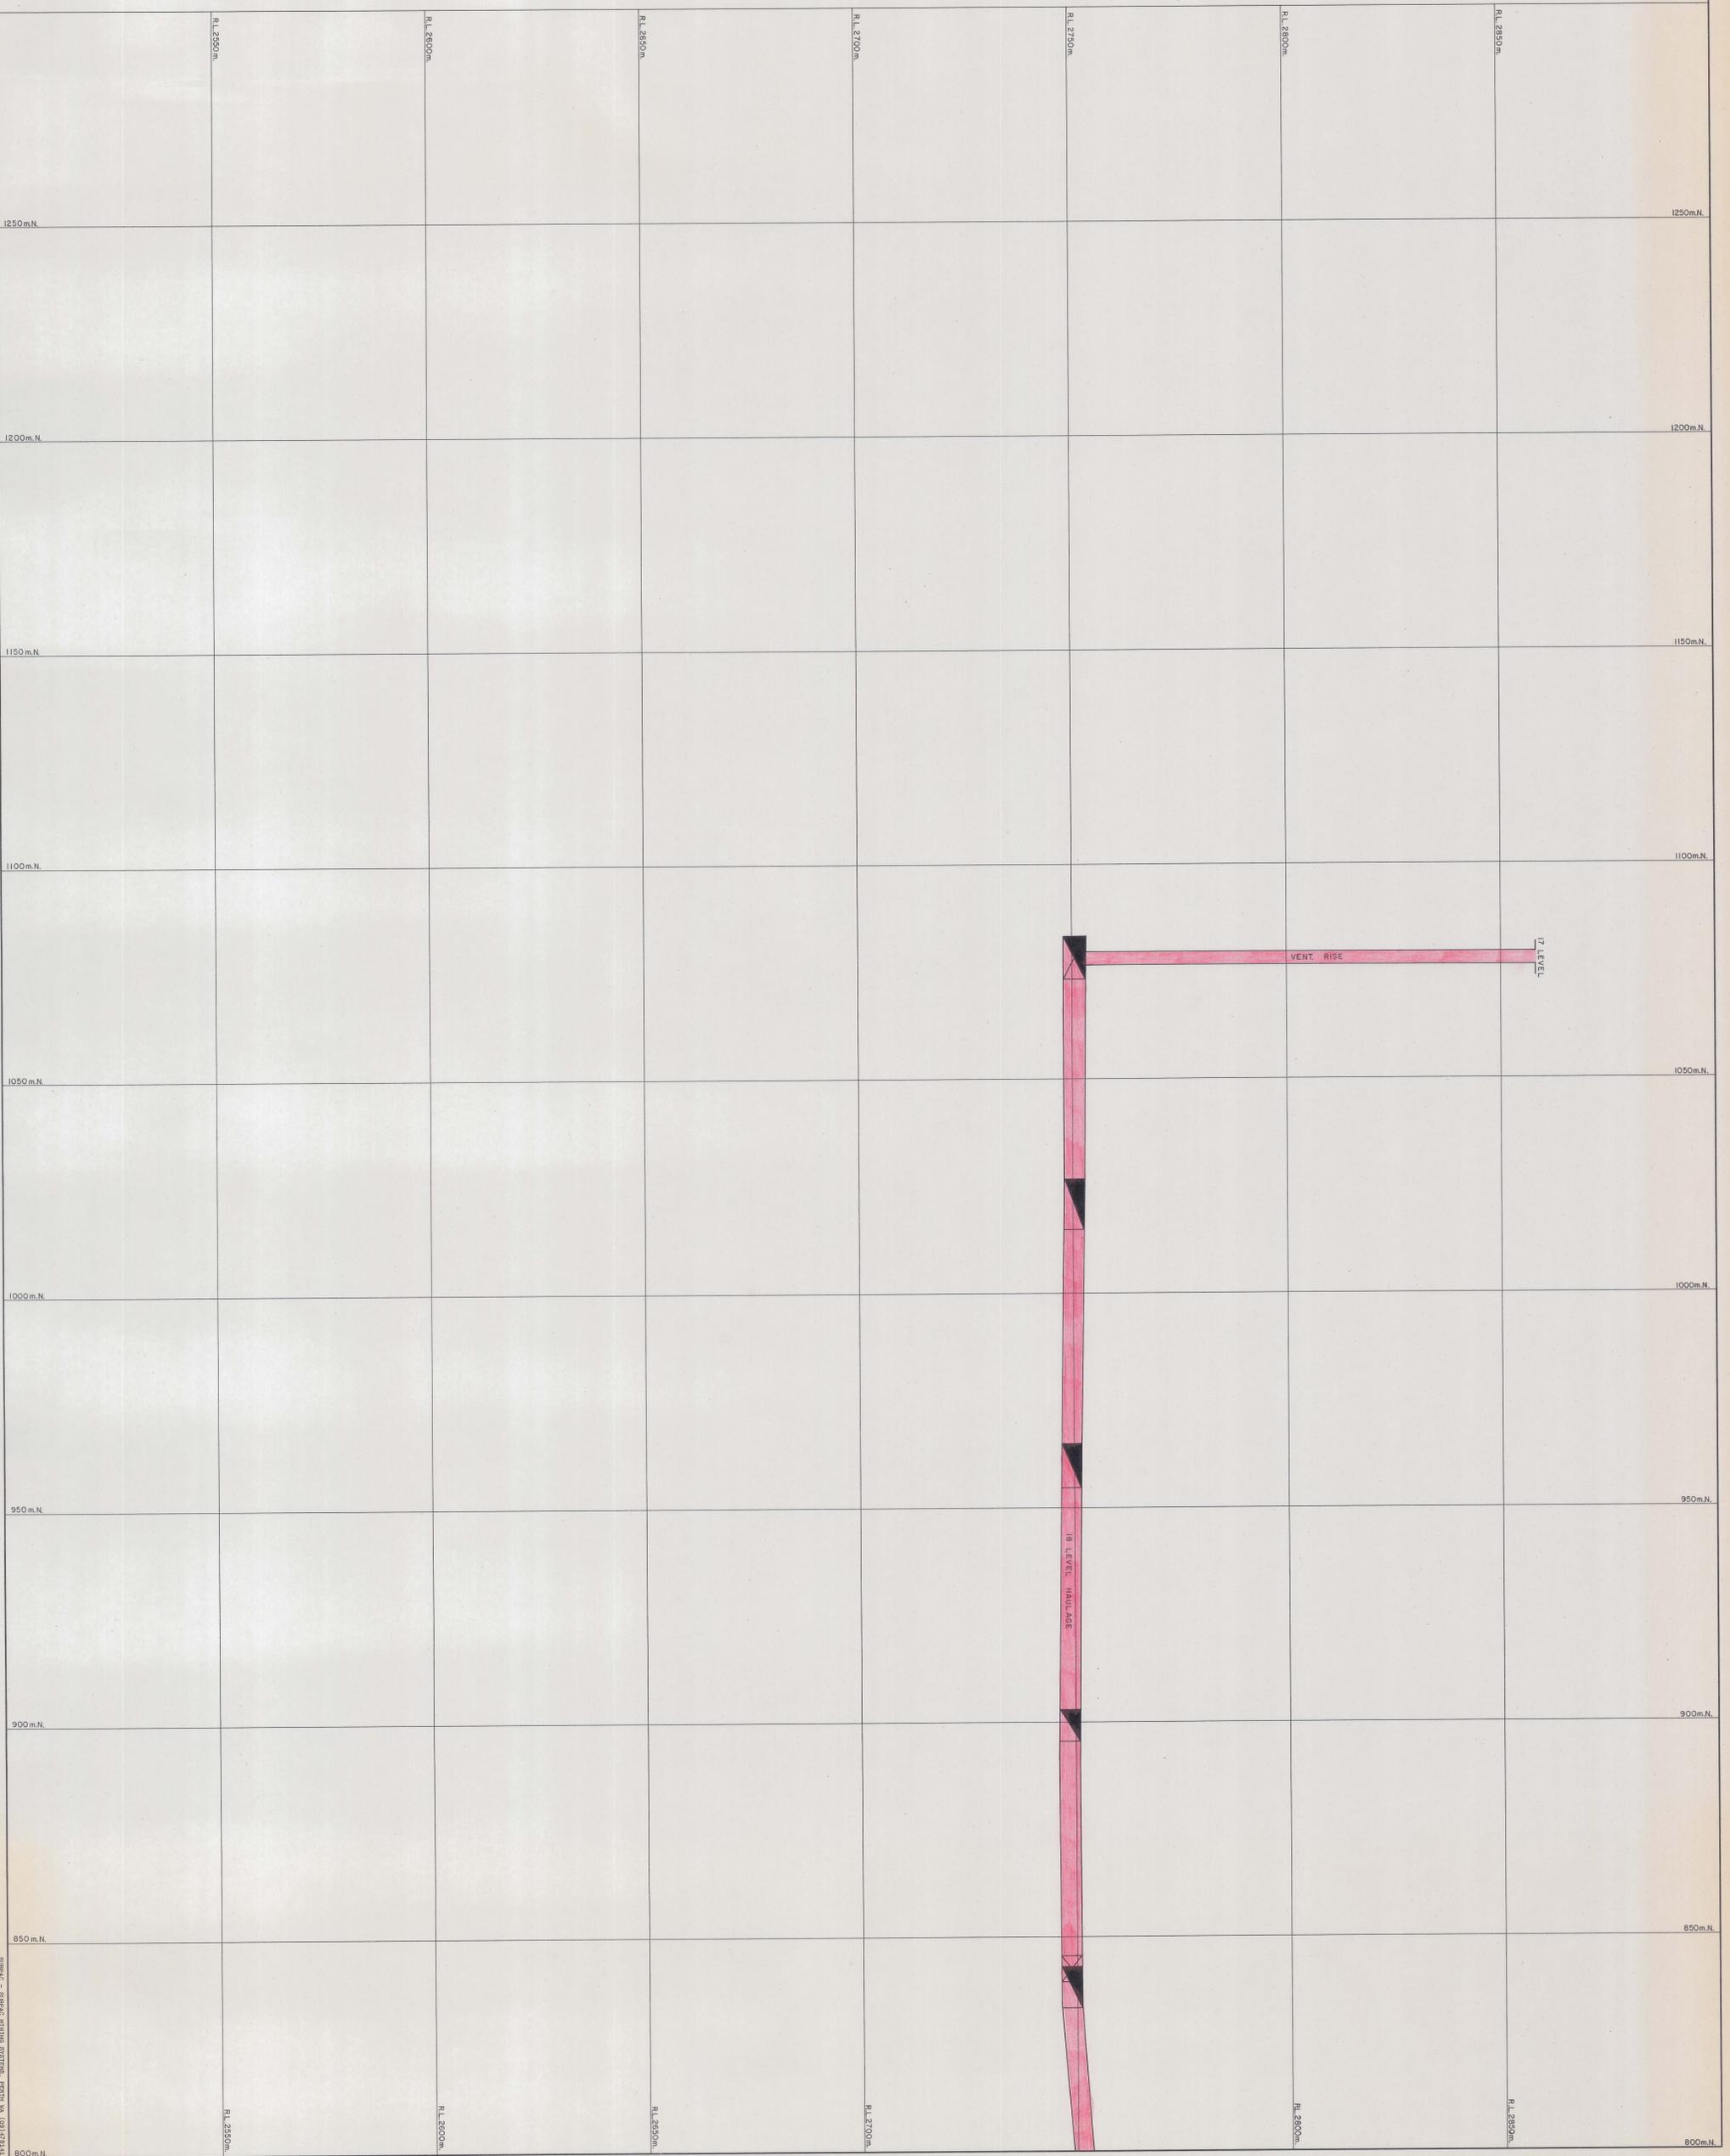

800m.N
 850m.N
 900m.N
 950m.N
 1000m.N
 1050m.N
 1100m.N
 1150m.N
 1200m.N
 1250m.N

RL 2650m

RL 2700m

RL 2750m

RL 2800m

RL 2850m

RL 2850m

800m.N