

0055-204

ELECTROLYTIC ZINC COMPANY OF AUSTRALASIA LIMITED

ROSEBERY

A.C.N. 004 074 962

MINE TECHNICAL SERVICES

Drawn	By	Date
		24-JAN-89
Traced		
Checked		
Approved		

ROSEBERY MINE
17 LEVEL
SHEET 5 OF 5



SCALE: 1: 500	FILE:
DESIGN:	DRAWING No.
SURVEY:	No.



Revisions	No			By			Date			Details			App			References			
	No	By	Date	No	By	Date	No	By	Date	No	By	Date	No	By	Date	No	By	Date	

DEPARTMENT OF MINES

BOUGHT TO DATE: 31 DEC 1991

MINE MANAGER: *[Signature]*

MINE SURVEYOR: *[Signature]*

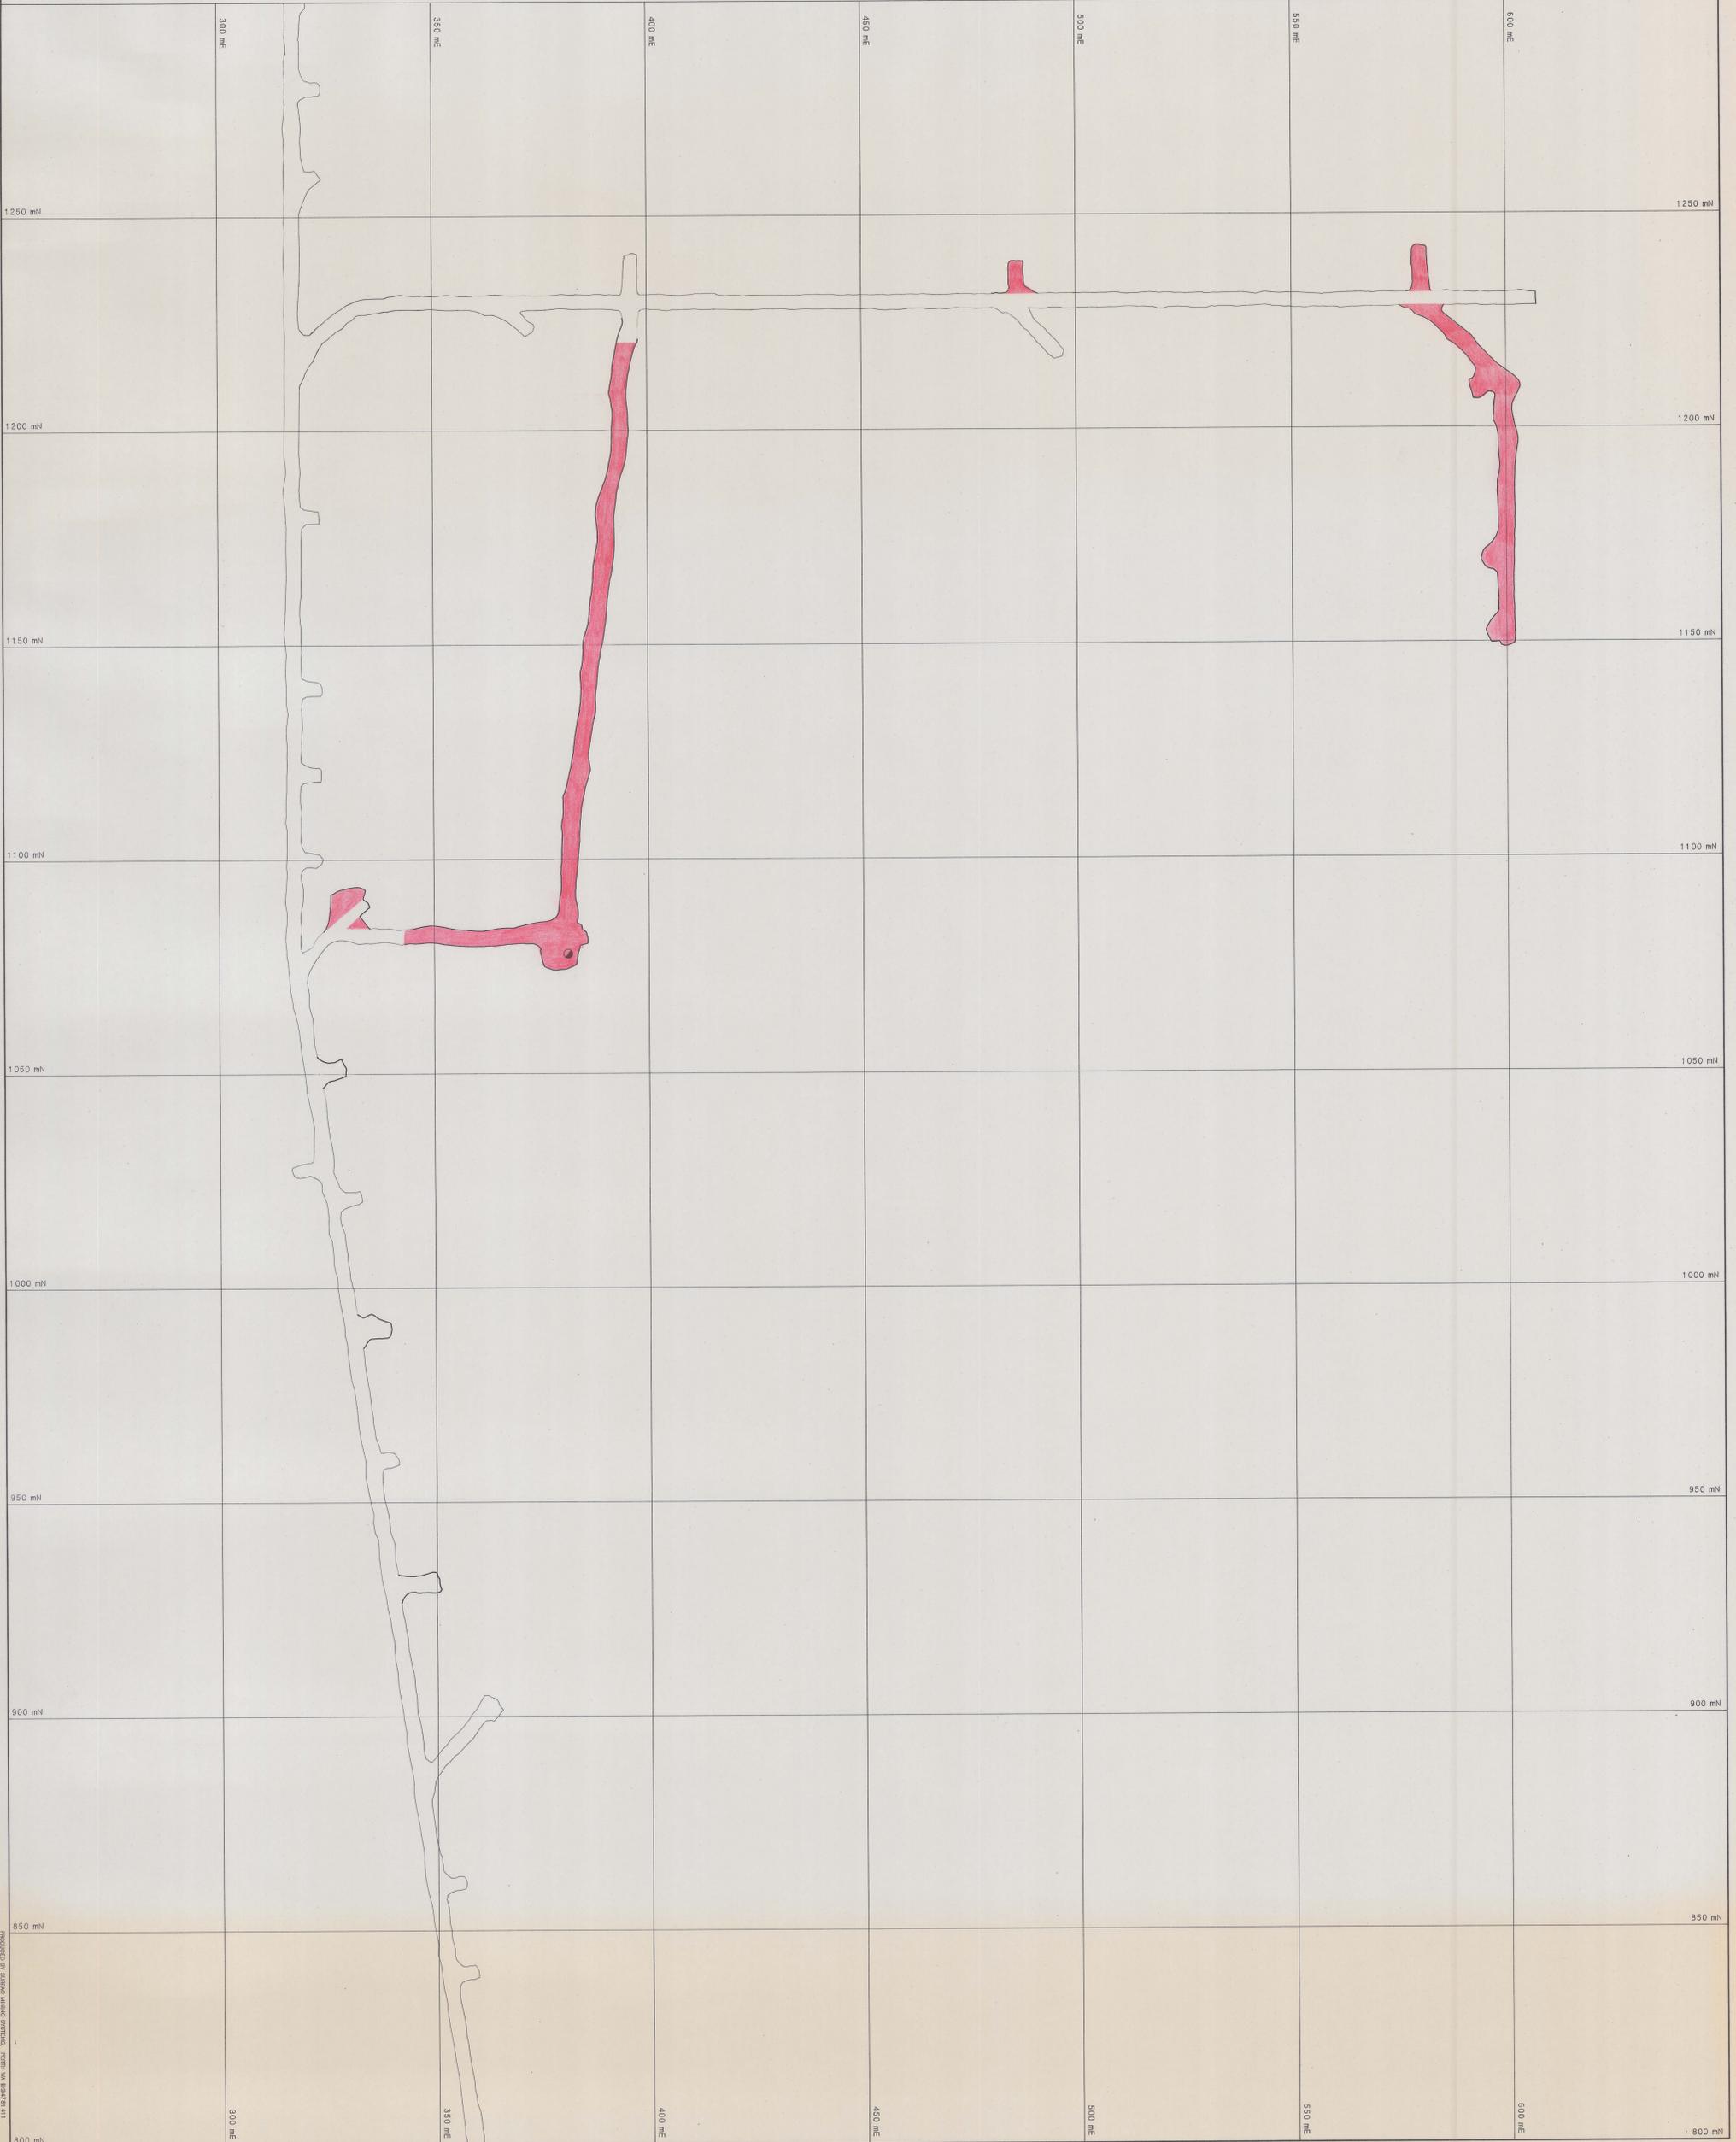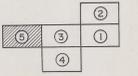

PRODUCED BY ELECTROLYTIC ZINC COMPANY LIMITED, PERTH, WA 6150