


D.S.S. - 206

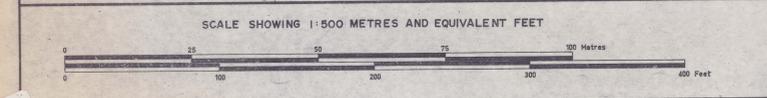

**ELECTROLYTIC ZINC COMPANY OF AUSTRALASIA LIMITED**  
 WEST COAST MINES, T.A.S.  
 A.C.N. 004 074 962

|           |        |           |       |
|-----------|--------|-----------|-------|
| SURVEY BY |        | SCALE     | 1:500 |
| DRAWN BY  |        | DATE      | 1978  |
| TRACED BY | A.G.M. | REFERENCE |       |

ROSEBERY MINE  
 No 16 LEVEL ①

DEPARTMENT OF MINES  
 BROUGHT TO DATE: 31 DEC 1981  
 MINE MANAGER: *[Signature]*  
 MINE SURVEYOR: *[Signature]*

DRAWING No.:  
 ③  
 ②