


0381_043
COSS-208



0381_043
COSS-208

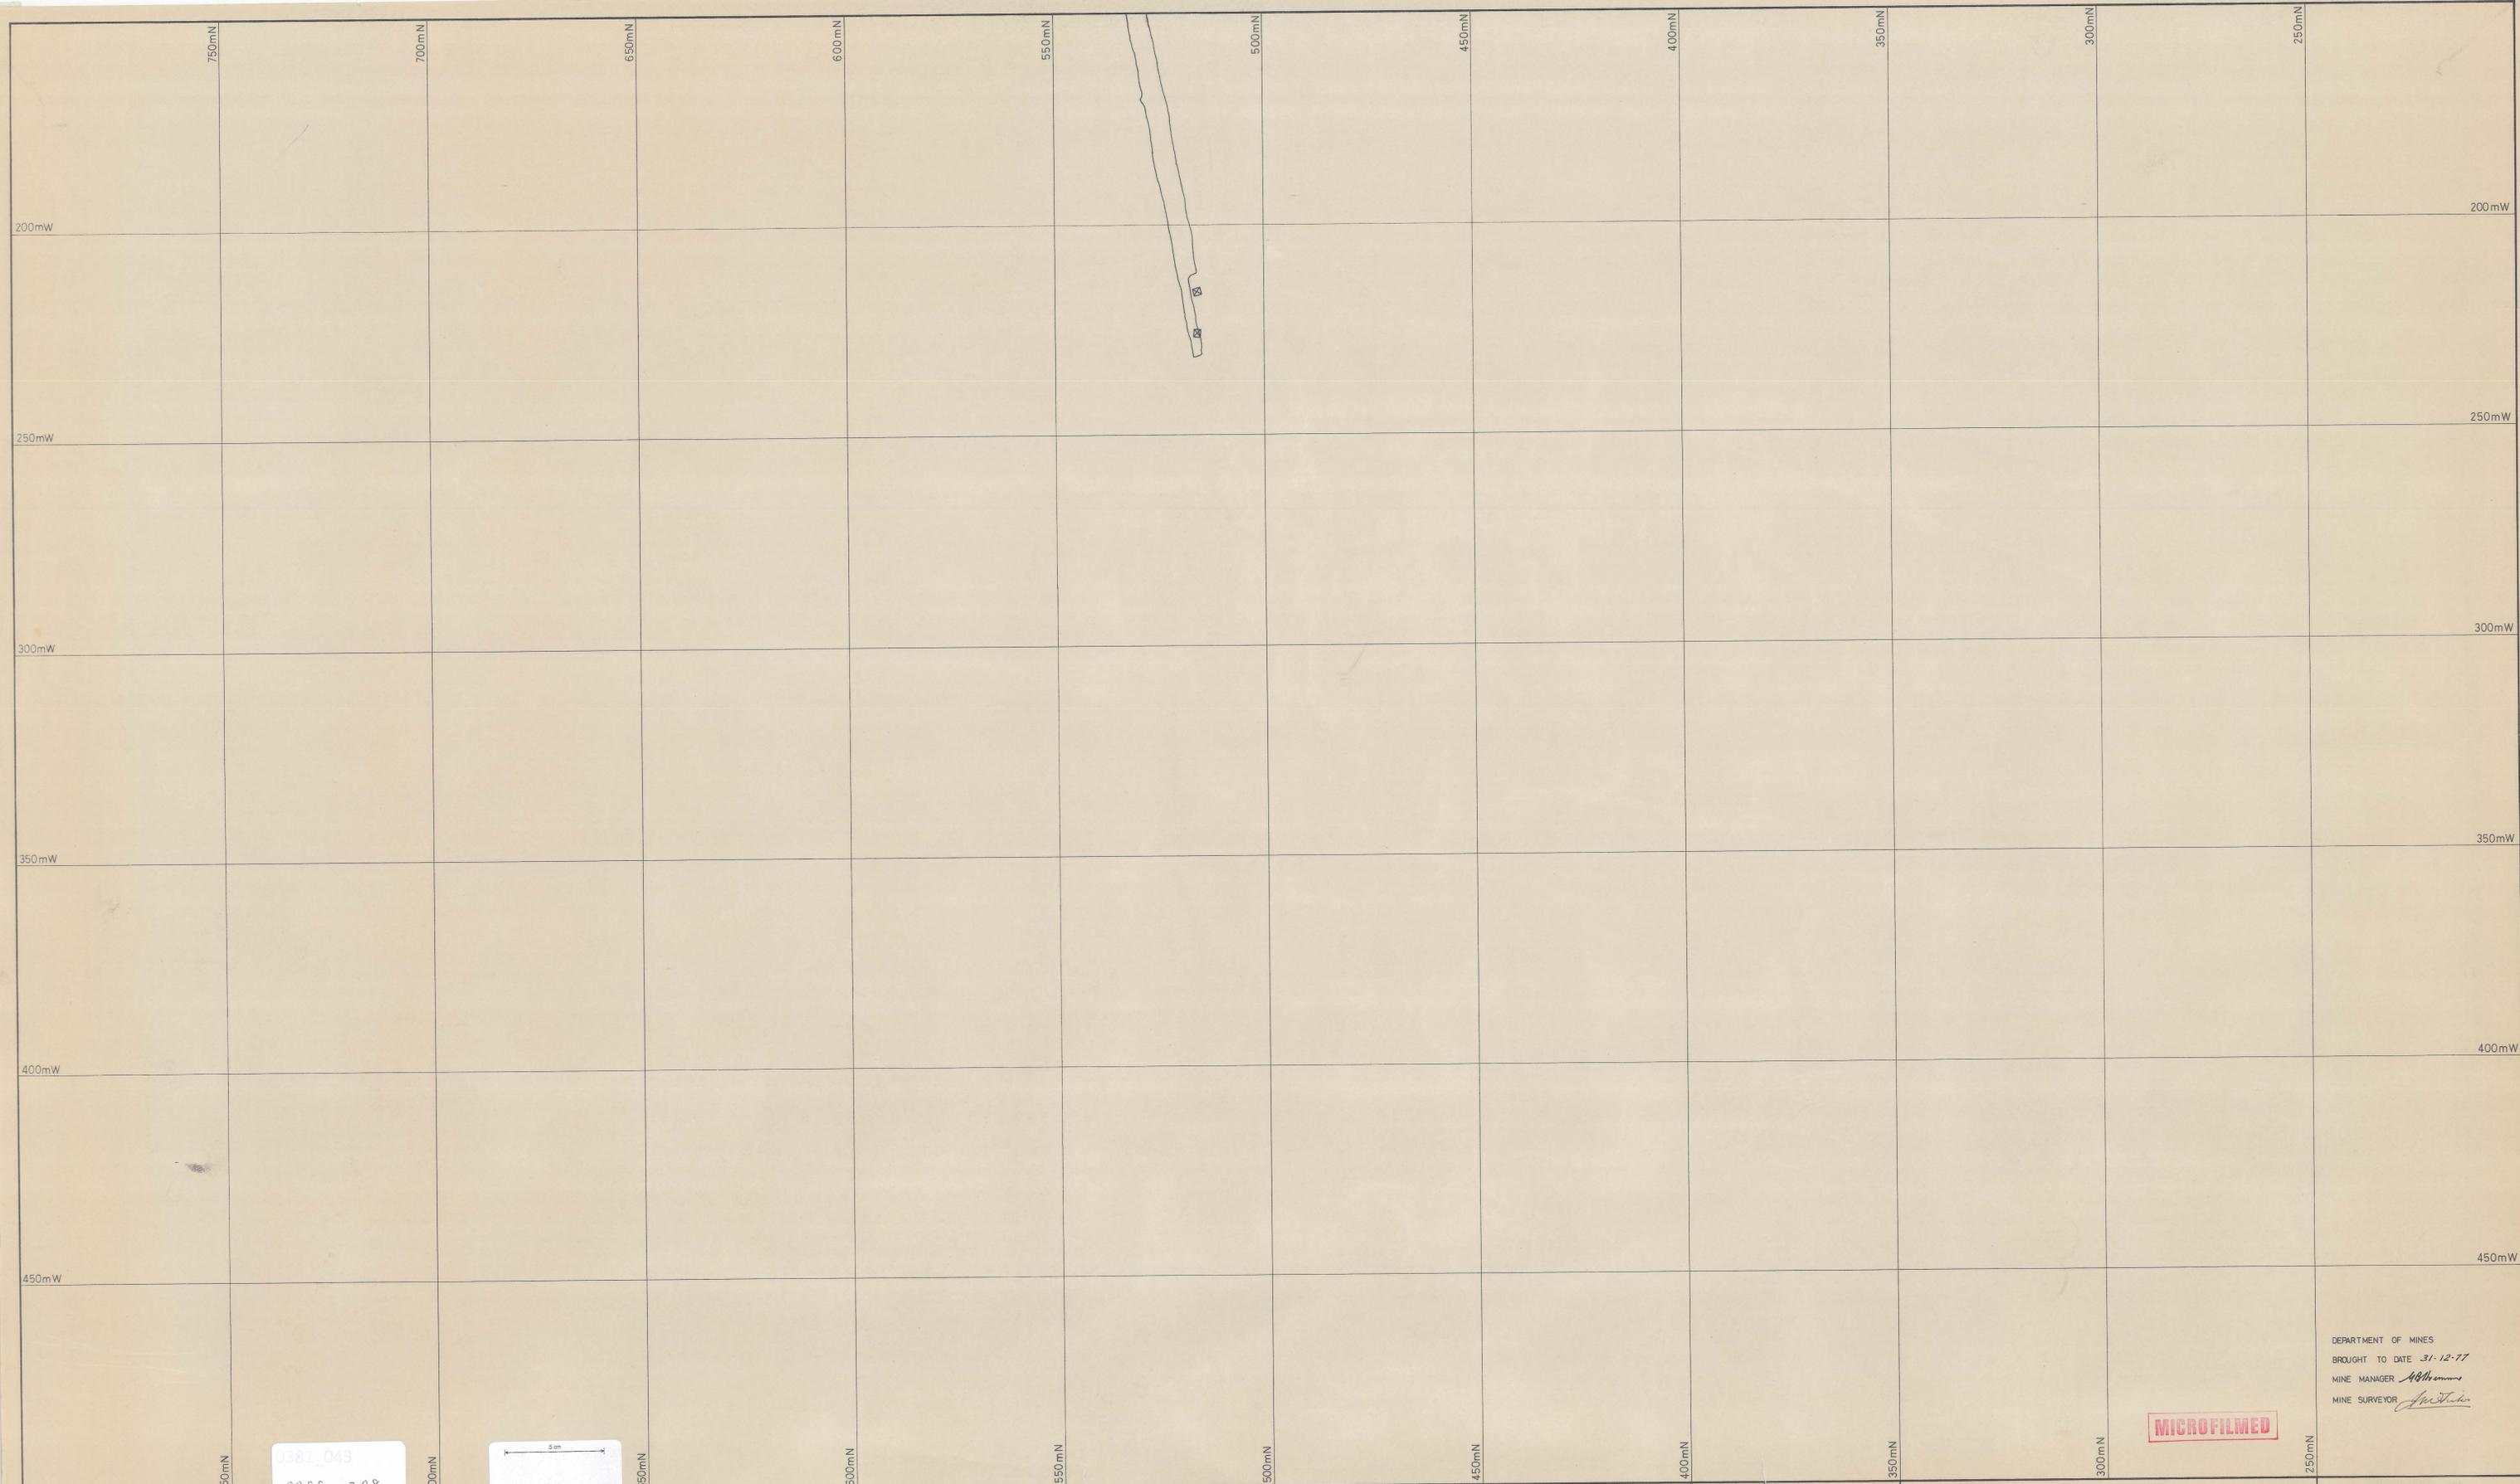

SCALE SHOWING 1:500 METRES AND EQUIVALENT FEET



ELECTROLYTIC ZINC COMPANY OF AUSTRALASIA LIMITED
WEST COAST MINES, TAS.

SURVEY BY		SCALE	1:500
DRAWN BY		DATE	1976
TRACED BY		REFERENCE	

ROSEBERY MINE
N° 8 LEVEL (4)

MICROFILMED

DEPARTMENT OF MINES
BROUGHT TO DATE 31-12-77
MINE MANAGER *ABM*
MINE SURVEYOR *AS*

DRAWING N°
① ② ③
④ 78134