



0055-209

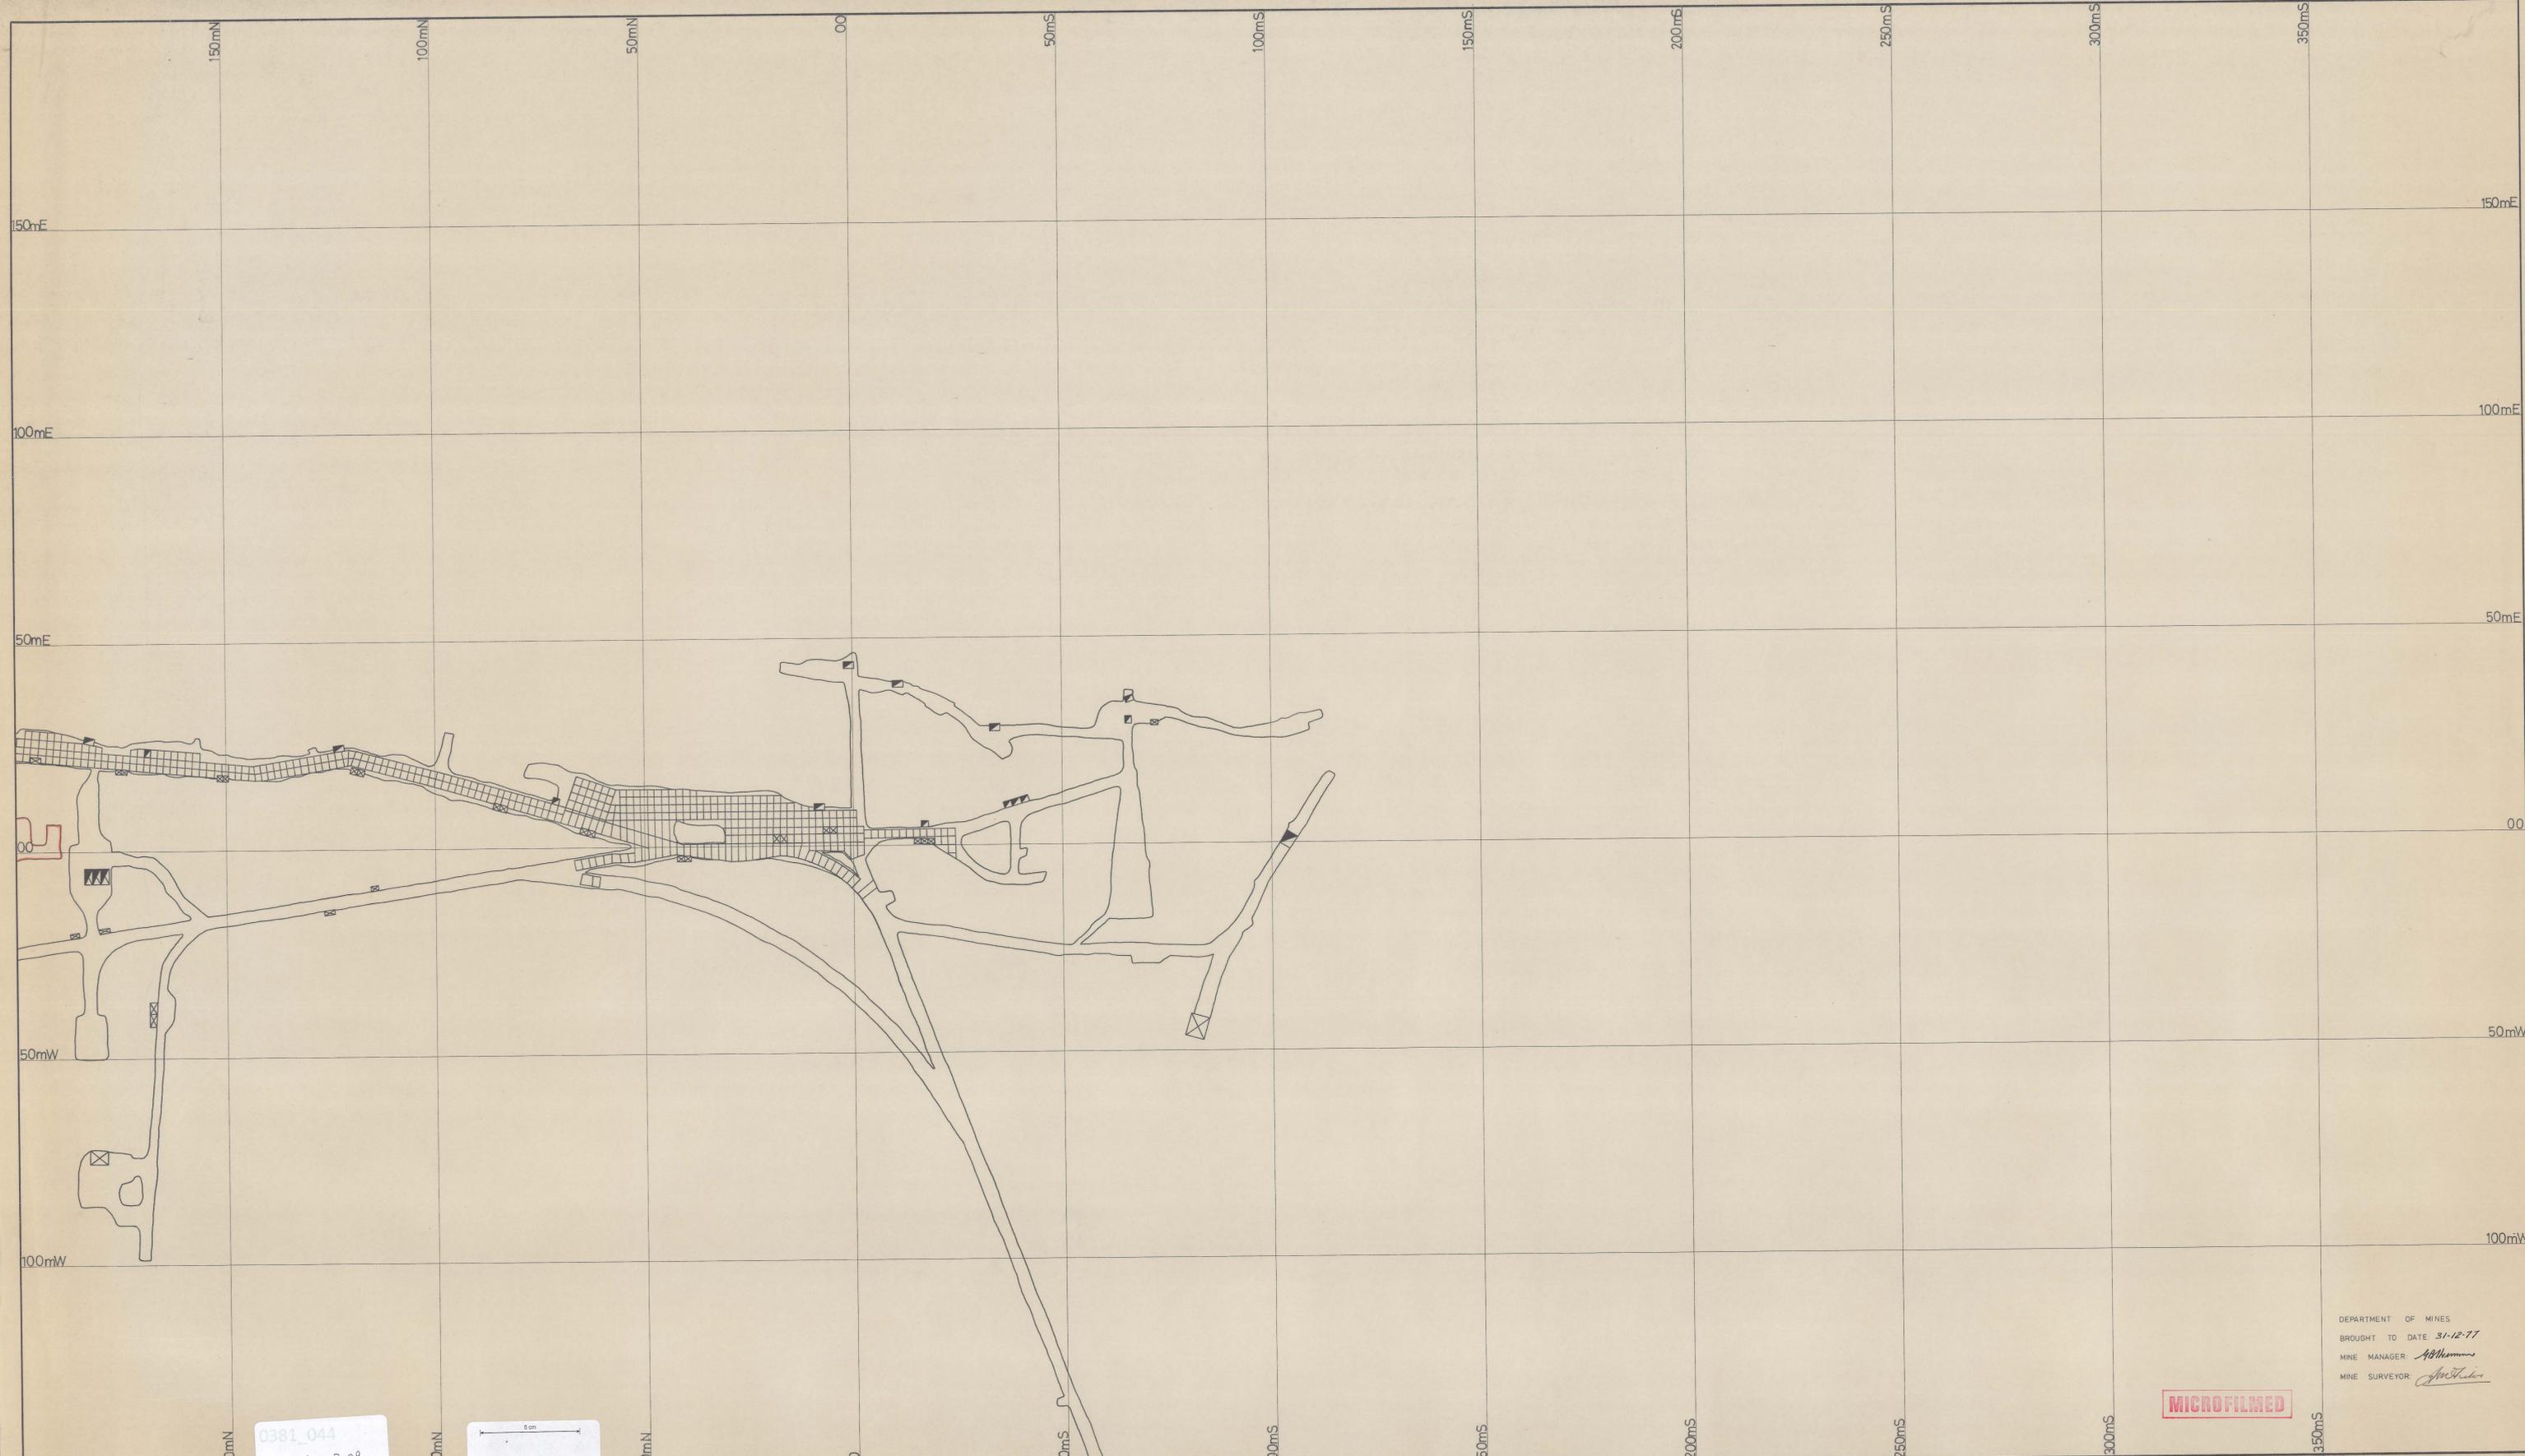

0381_044
0055-209

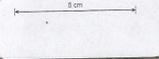

ELECTROLYTIC ZINC COMPANY OF AUSTRALASIA LIMITED
WEST COAST MINES, T.A.S.

SURVEY BY		SCALE	1:500
DRAWN BY		DATE	1975
TRACED BY	I.T.M.	REFERENCE	

ROSEBERY MINE
Nº 8 LEVEL (3)

MICROFILMED

DEPARTMENT OF MINES
BROUGHT TO DATE 31-12-77
MINE MANAGER *A. H. Thomas*
MINE SURVEYOR *J. M. ...*

DRAWING N°:

①	②	③
④		

78133