


0055-210



0381_045
0055-210

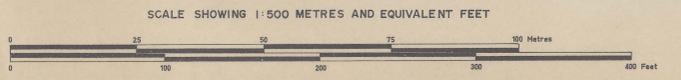

ELECTROLYTIC ZINC COMPANY OF AUSTRALASIA LIMITED
WEST COAST MINES, T.A.S.

SURVEY BY		SCALE	1:500
DRAWN BY		DATE	1975
TRACED BY	I.T.M.	REFERENCE	

ROSEBERY MINE
No. 8 LEVEL (2)

MICROFILMED

DEPARTMENT OF MINES
BROUGHT TO DATE 31-12-77
MINE MANAGER *A.H. Williams*
MINE SURVEYOR *A.H. Williams*

DRAWING No.:
① ② ③
④ 78/52