


0055-211

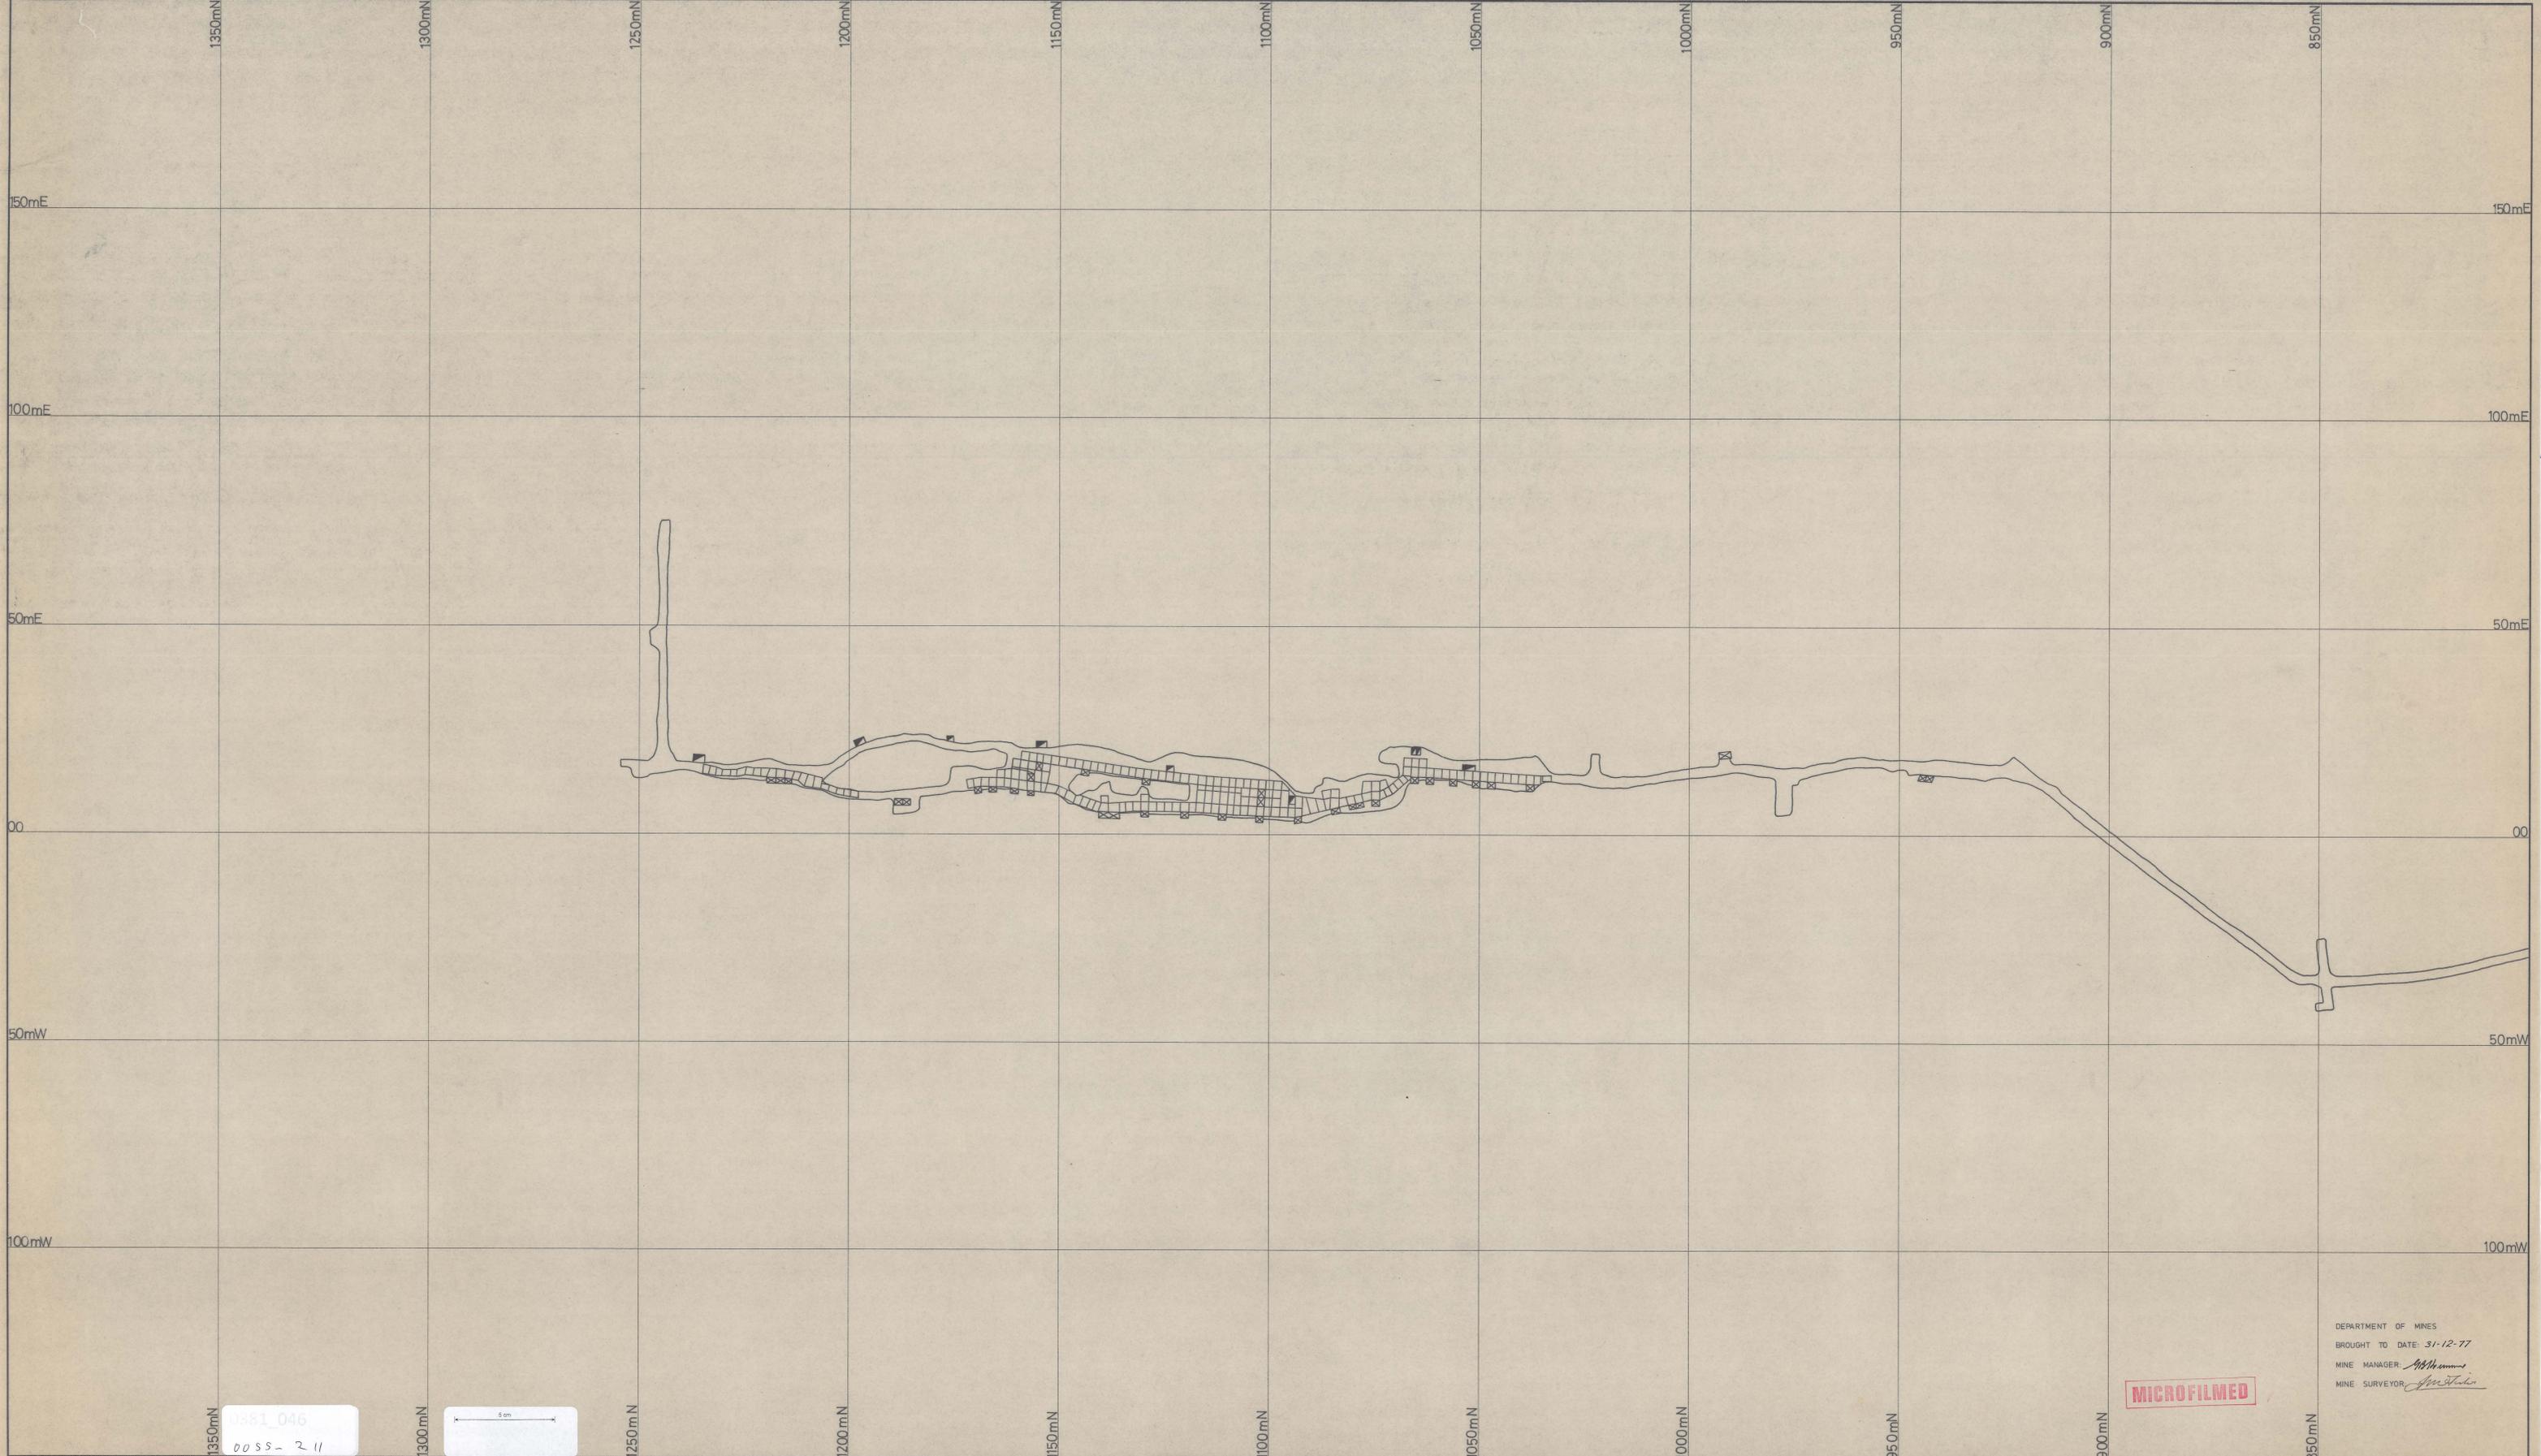


0381\_046  
0055-211

5 cm

MICROFILMED

DEPARTMENT OF MINES  
BROUGHT TO DATE: 31-12-77  
MINE MANAGER: *A.H. ...*  
MINE SURVEYOR: *A.H. ...*

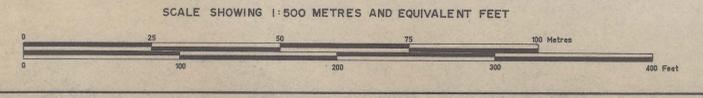

ELECTROLYTIC ZINC COMPANY OF AUSTRALASIA LIMITED  
WEST COAST MINES, T.A.S.

SURVEY BY		SCALE	1:500
DRAWN BY		DATE	1975
TRACED BY	I.T.M.	REFERENCE	

ROSEBERY MINE  
No 8 LEVEL (1)

DRAWING No: 78131

1	2	3
4		