



0055-212

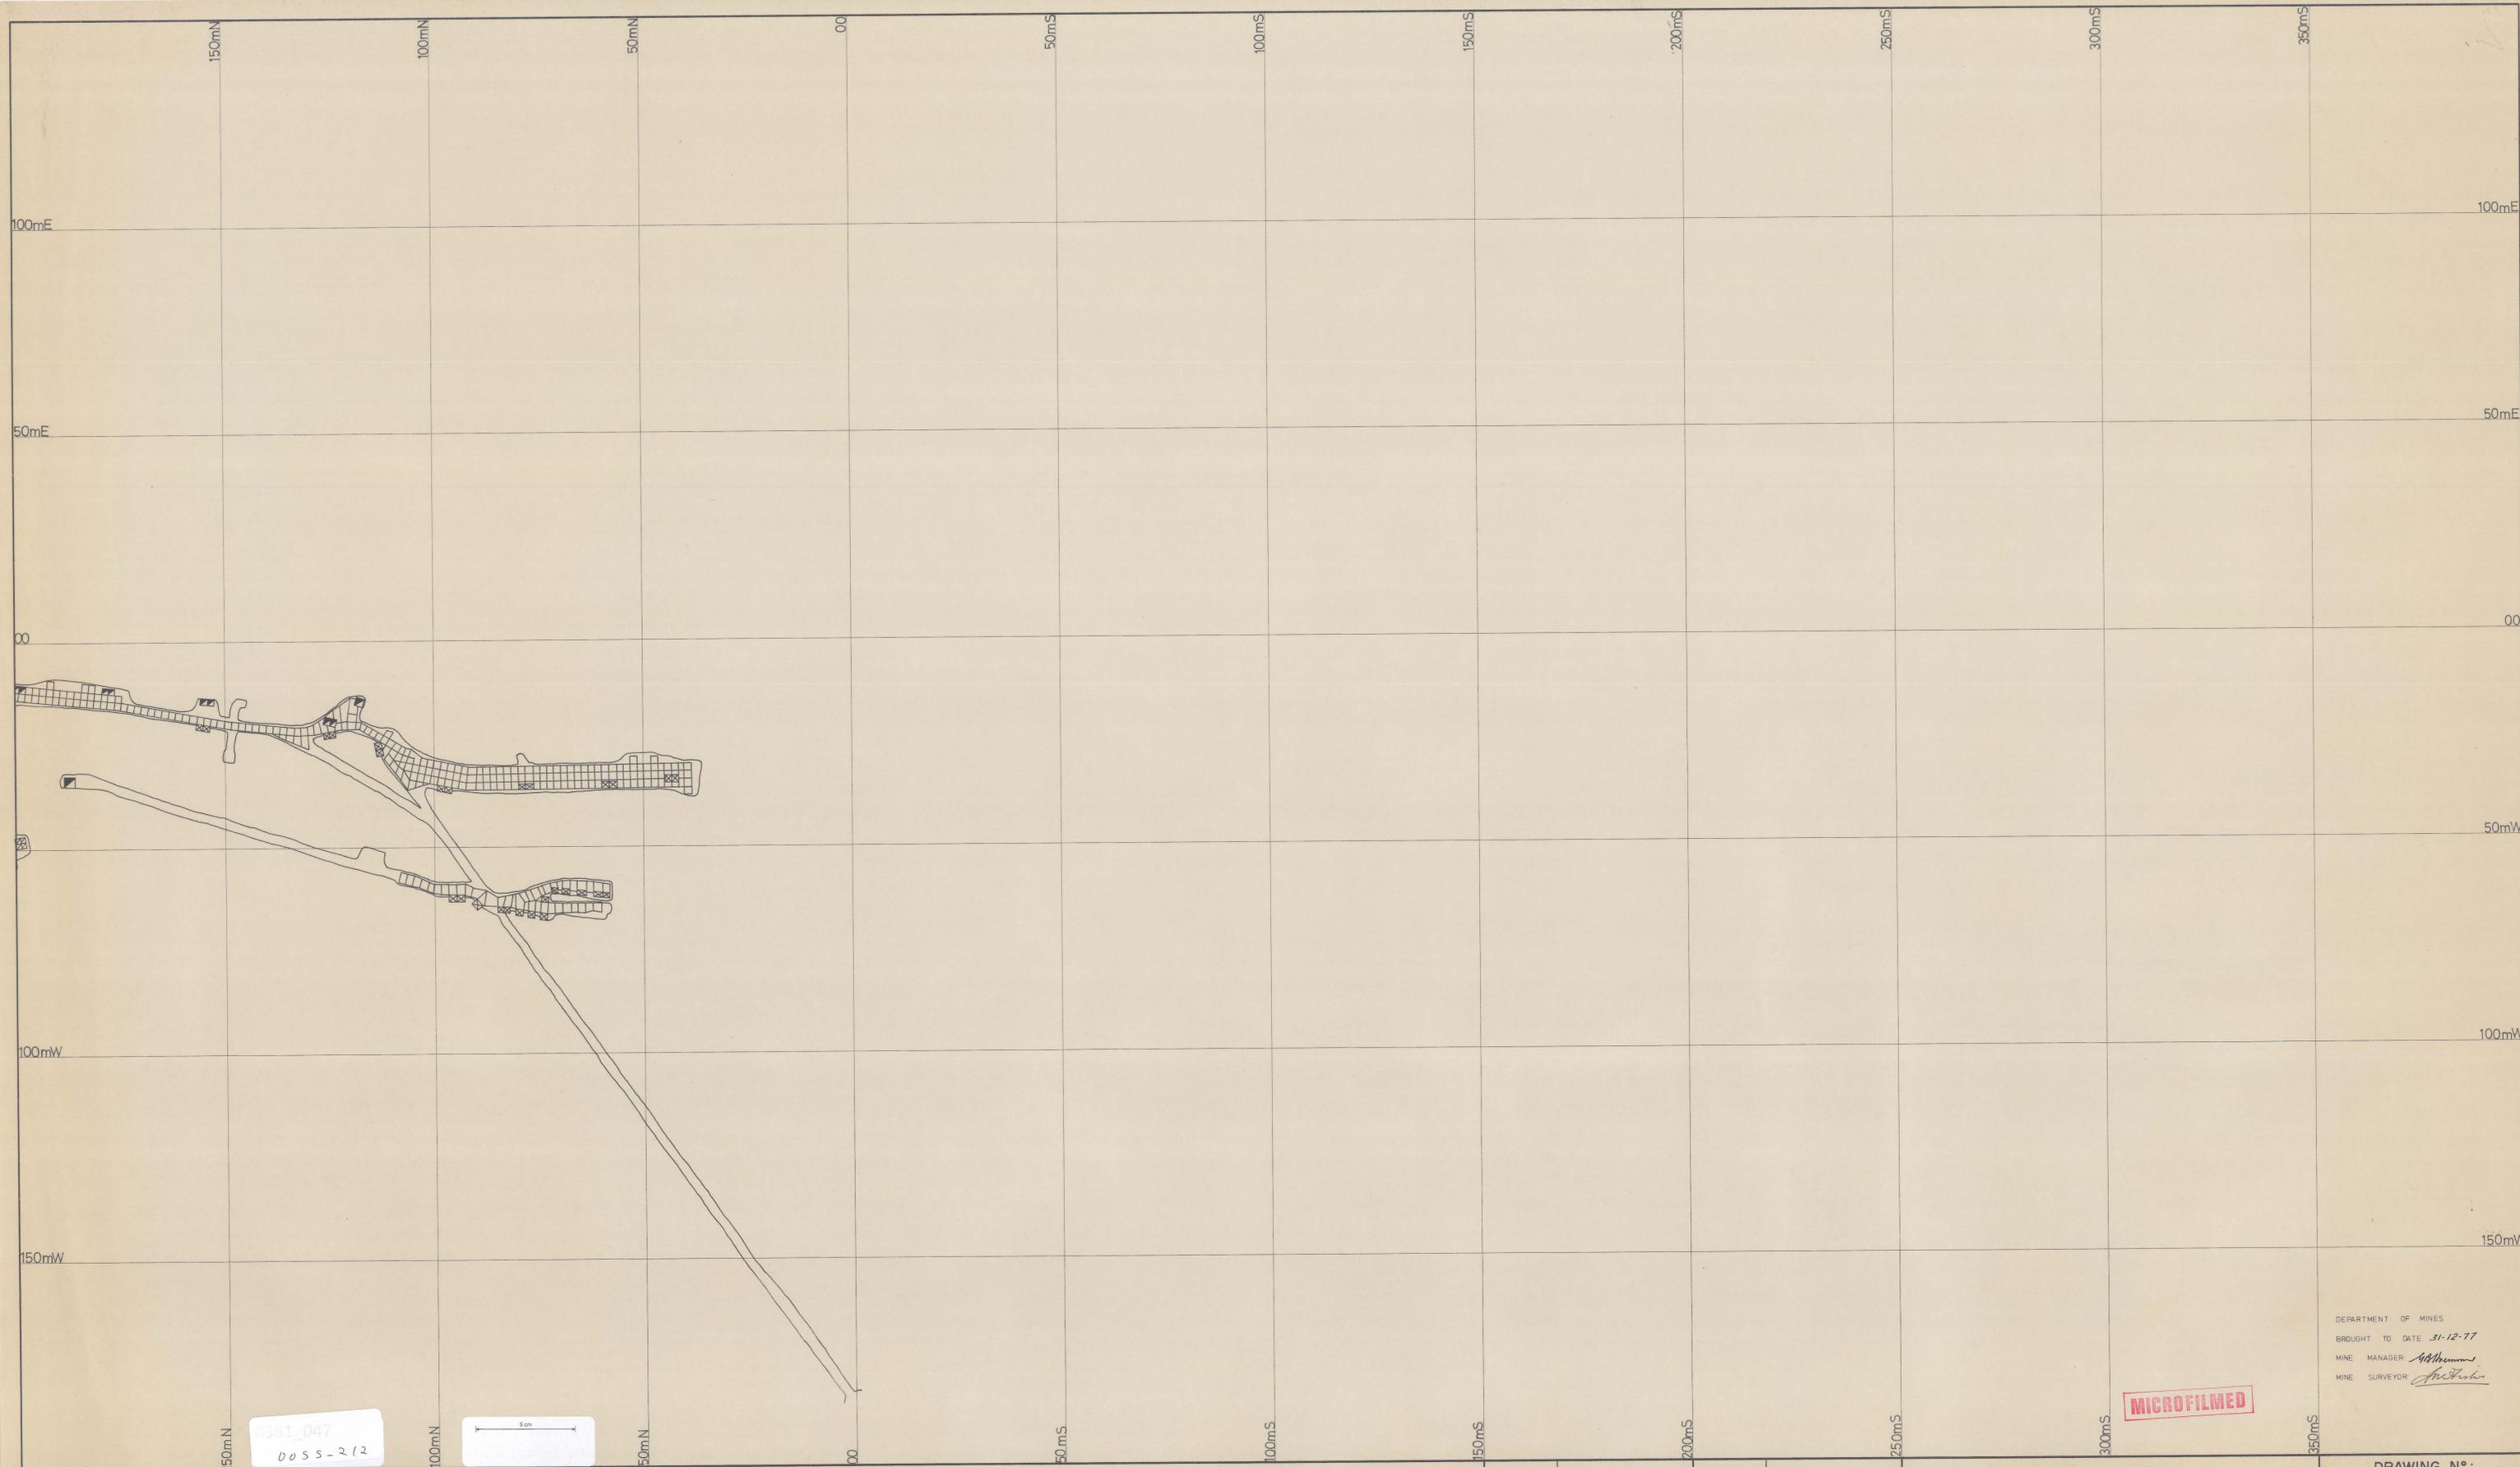

0381\_047  
0055-212

5m

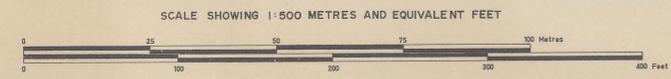

ELECTROLYTIC ZINC COMPANY OF AUSTRALASIA LIMITED  
WEST COAST MINES, T.A.S.

SURVEY BY		SCALE	1:500
DRAWN BY		DATE	1975
TRACED BY	RJR	REFERENCE	

ROSEBERY MINE  
No 6 LEVEL (3)

MICROFILMED

DEPARTMENT OF MINES  
BROUGHT TO DATE 31-12-77  
MINE MANAGER *A. Williams*  
MINE SURVEYOR *John Fisher*

DRAWING No: 78/30