



00 55 - 2 14

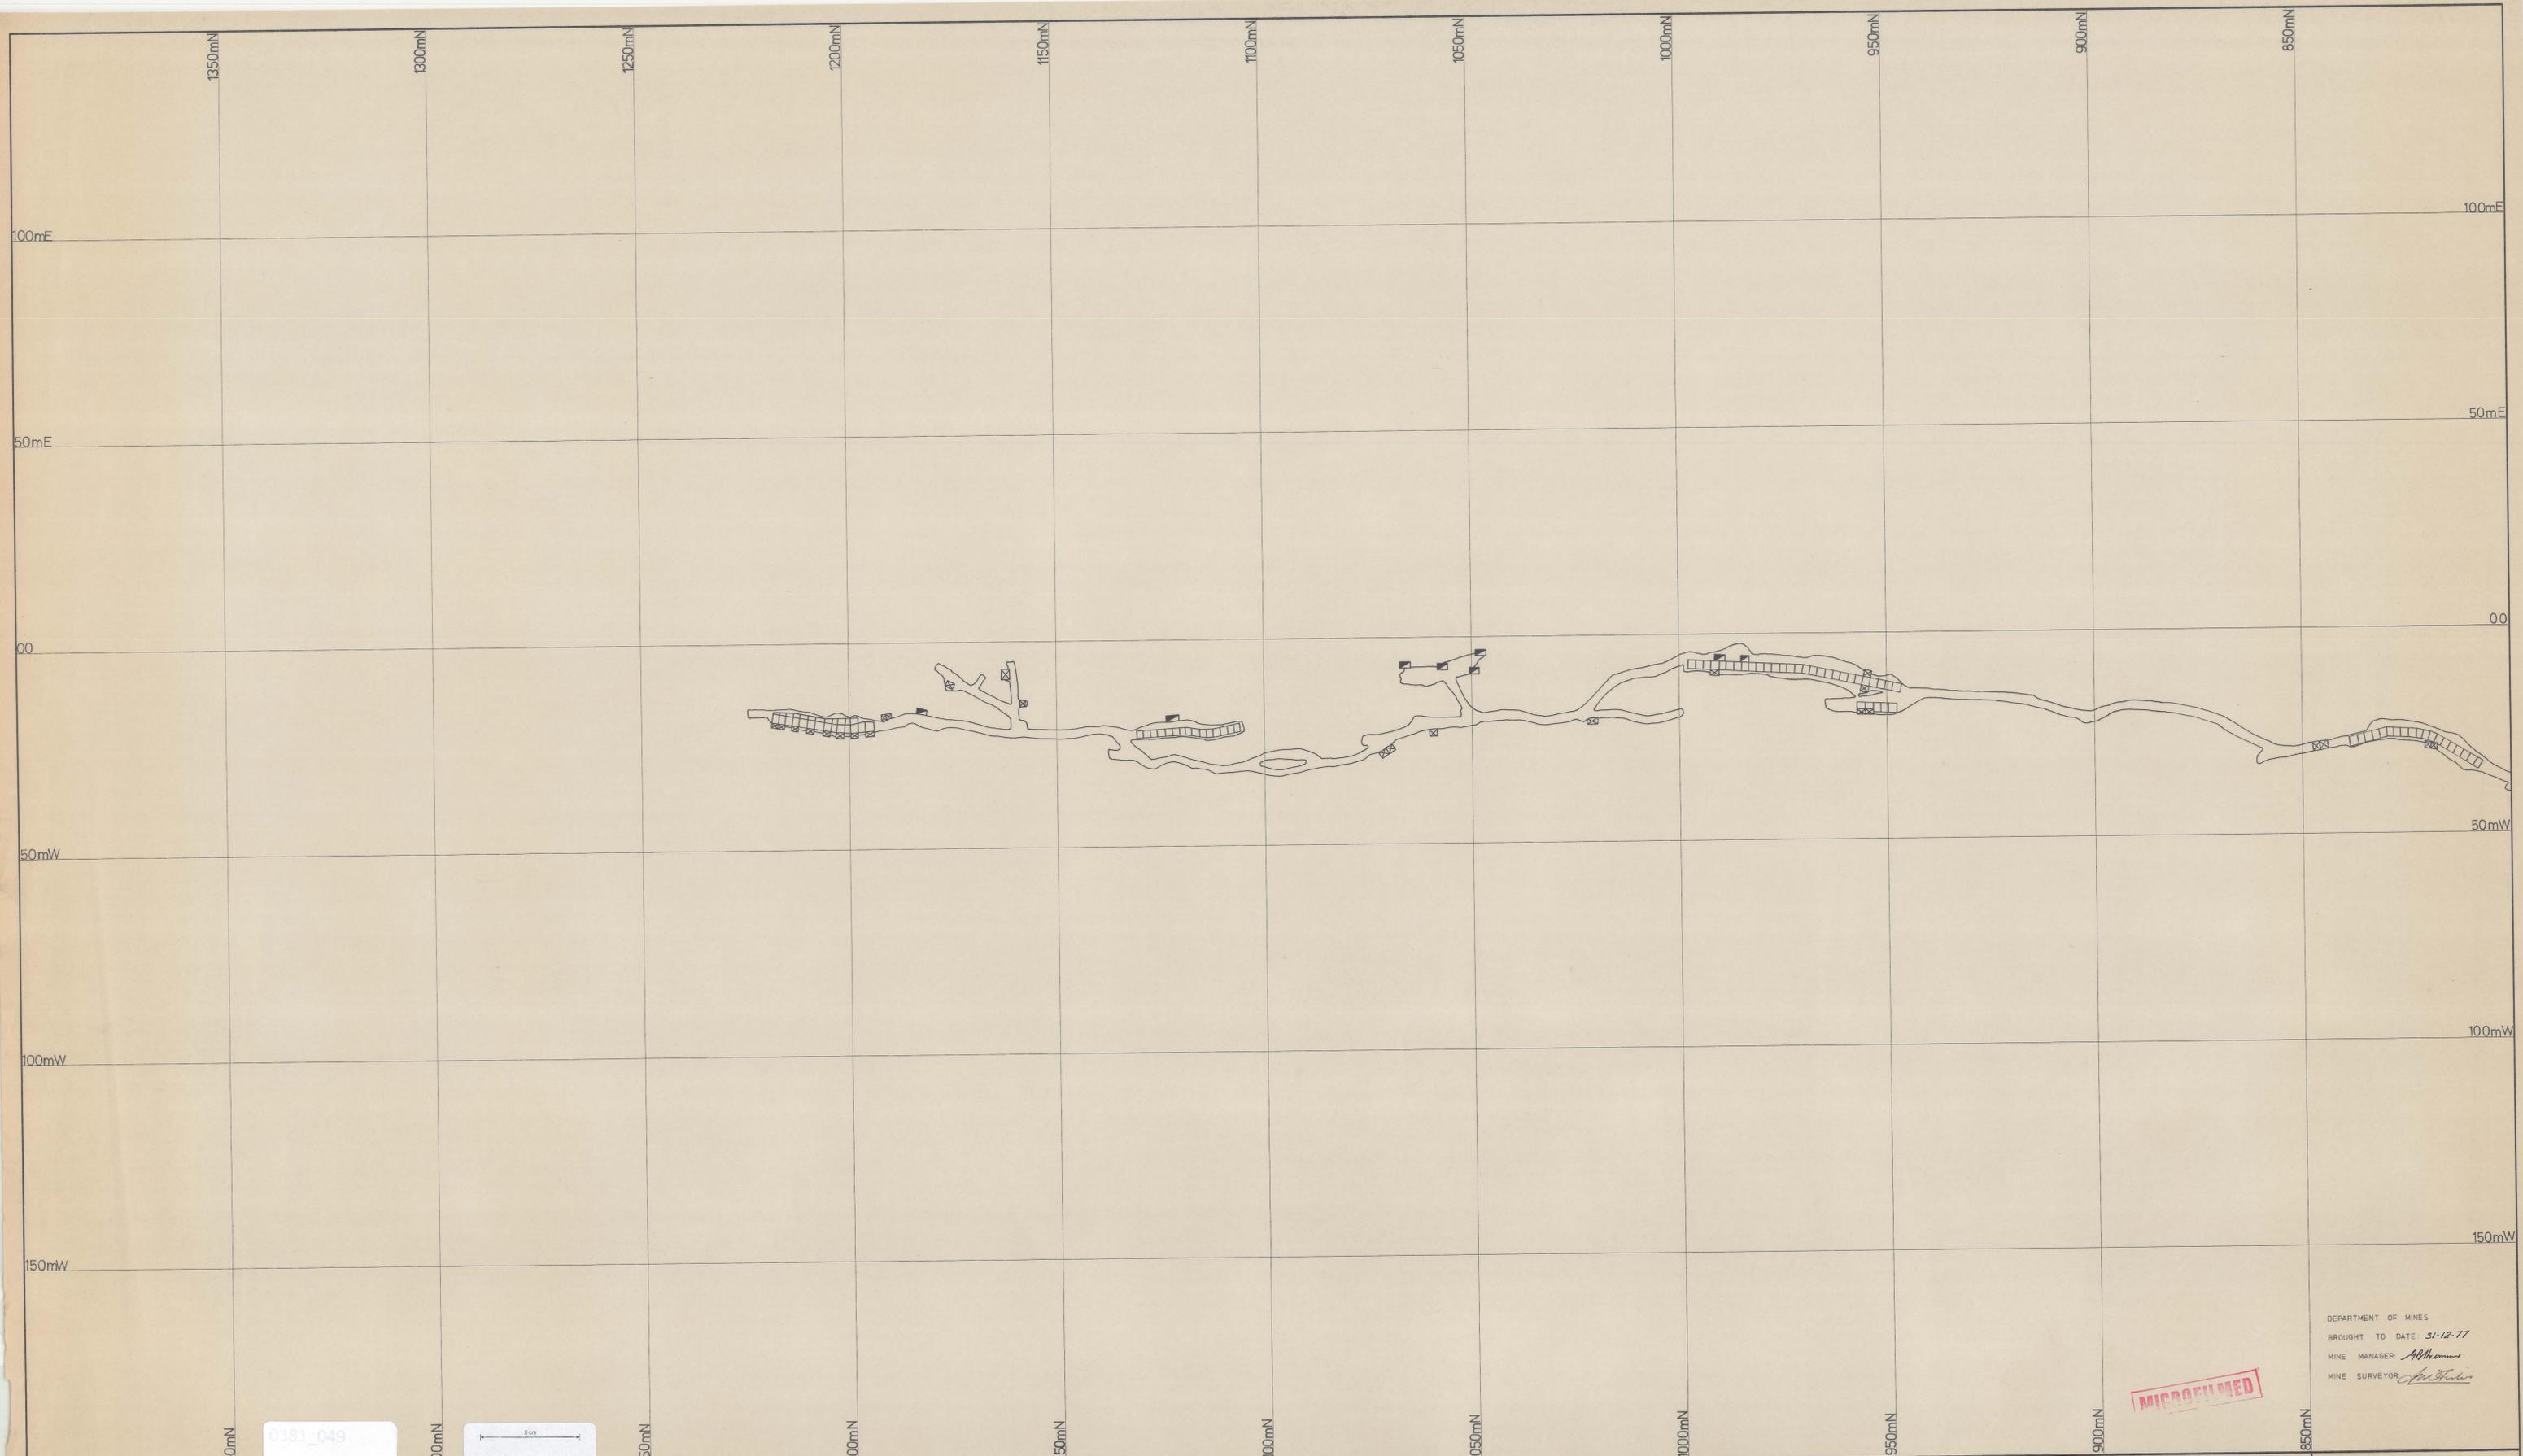

0381_049
0055-214

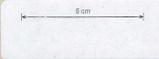

ELECTROLYTIC ZINC COMPANY OF AUSTRALASIA LIMITED
WEST COAST MINES, T.A.S.

SURVEY BY		SCALE	1:500
DRAWN BY		DATE	1975
TRACED BY	RJR	REFERENCE	

ROSEBERY MINE
Nº 6 LEVEL ①

MICROFILMED

DEPARTMENT OF MINES
BROUGHT TO DATE 31-12-77
MINE MANAGER *Abraham*
MINE SURVEYOR *[Signature]*

DRAWING Nº:
① ② ③ 78128