


0055-215



3381_050
0055-215

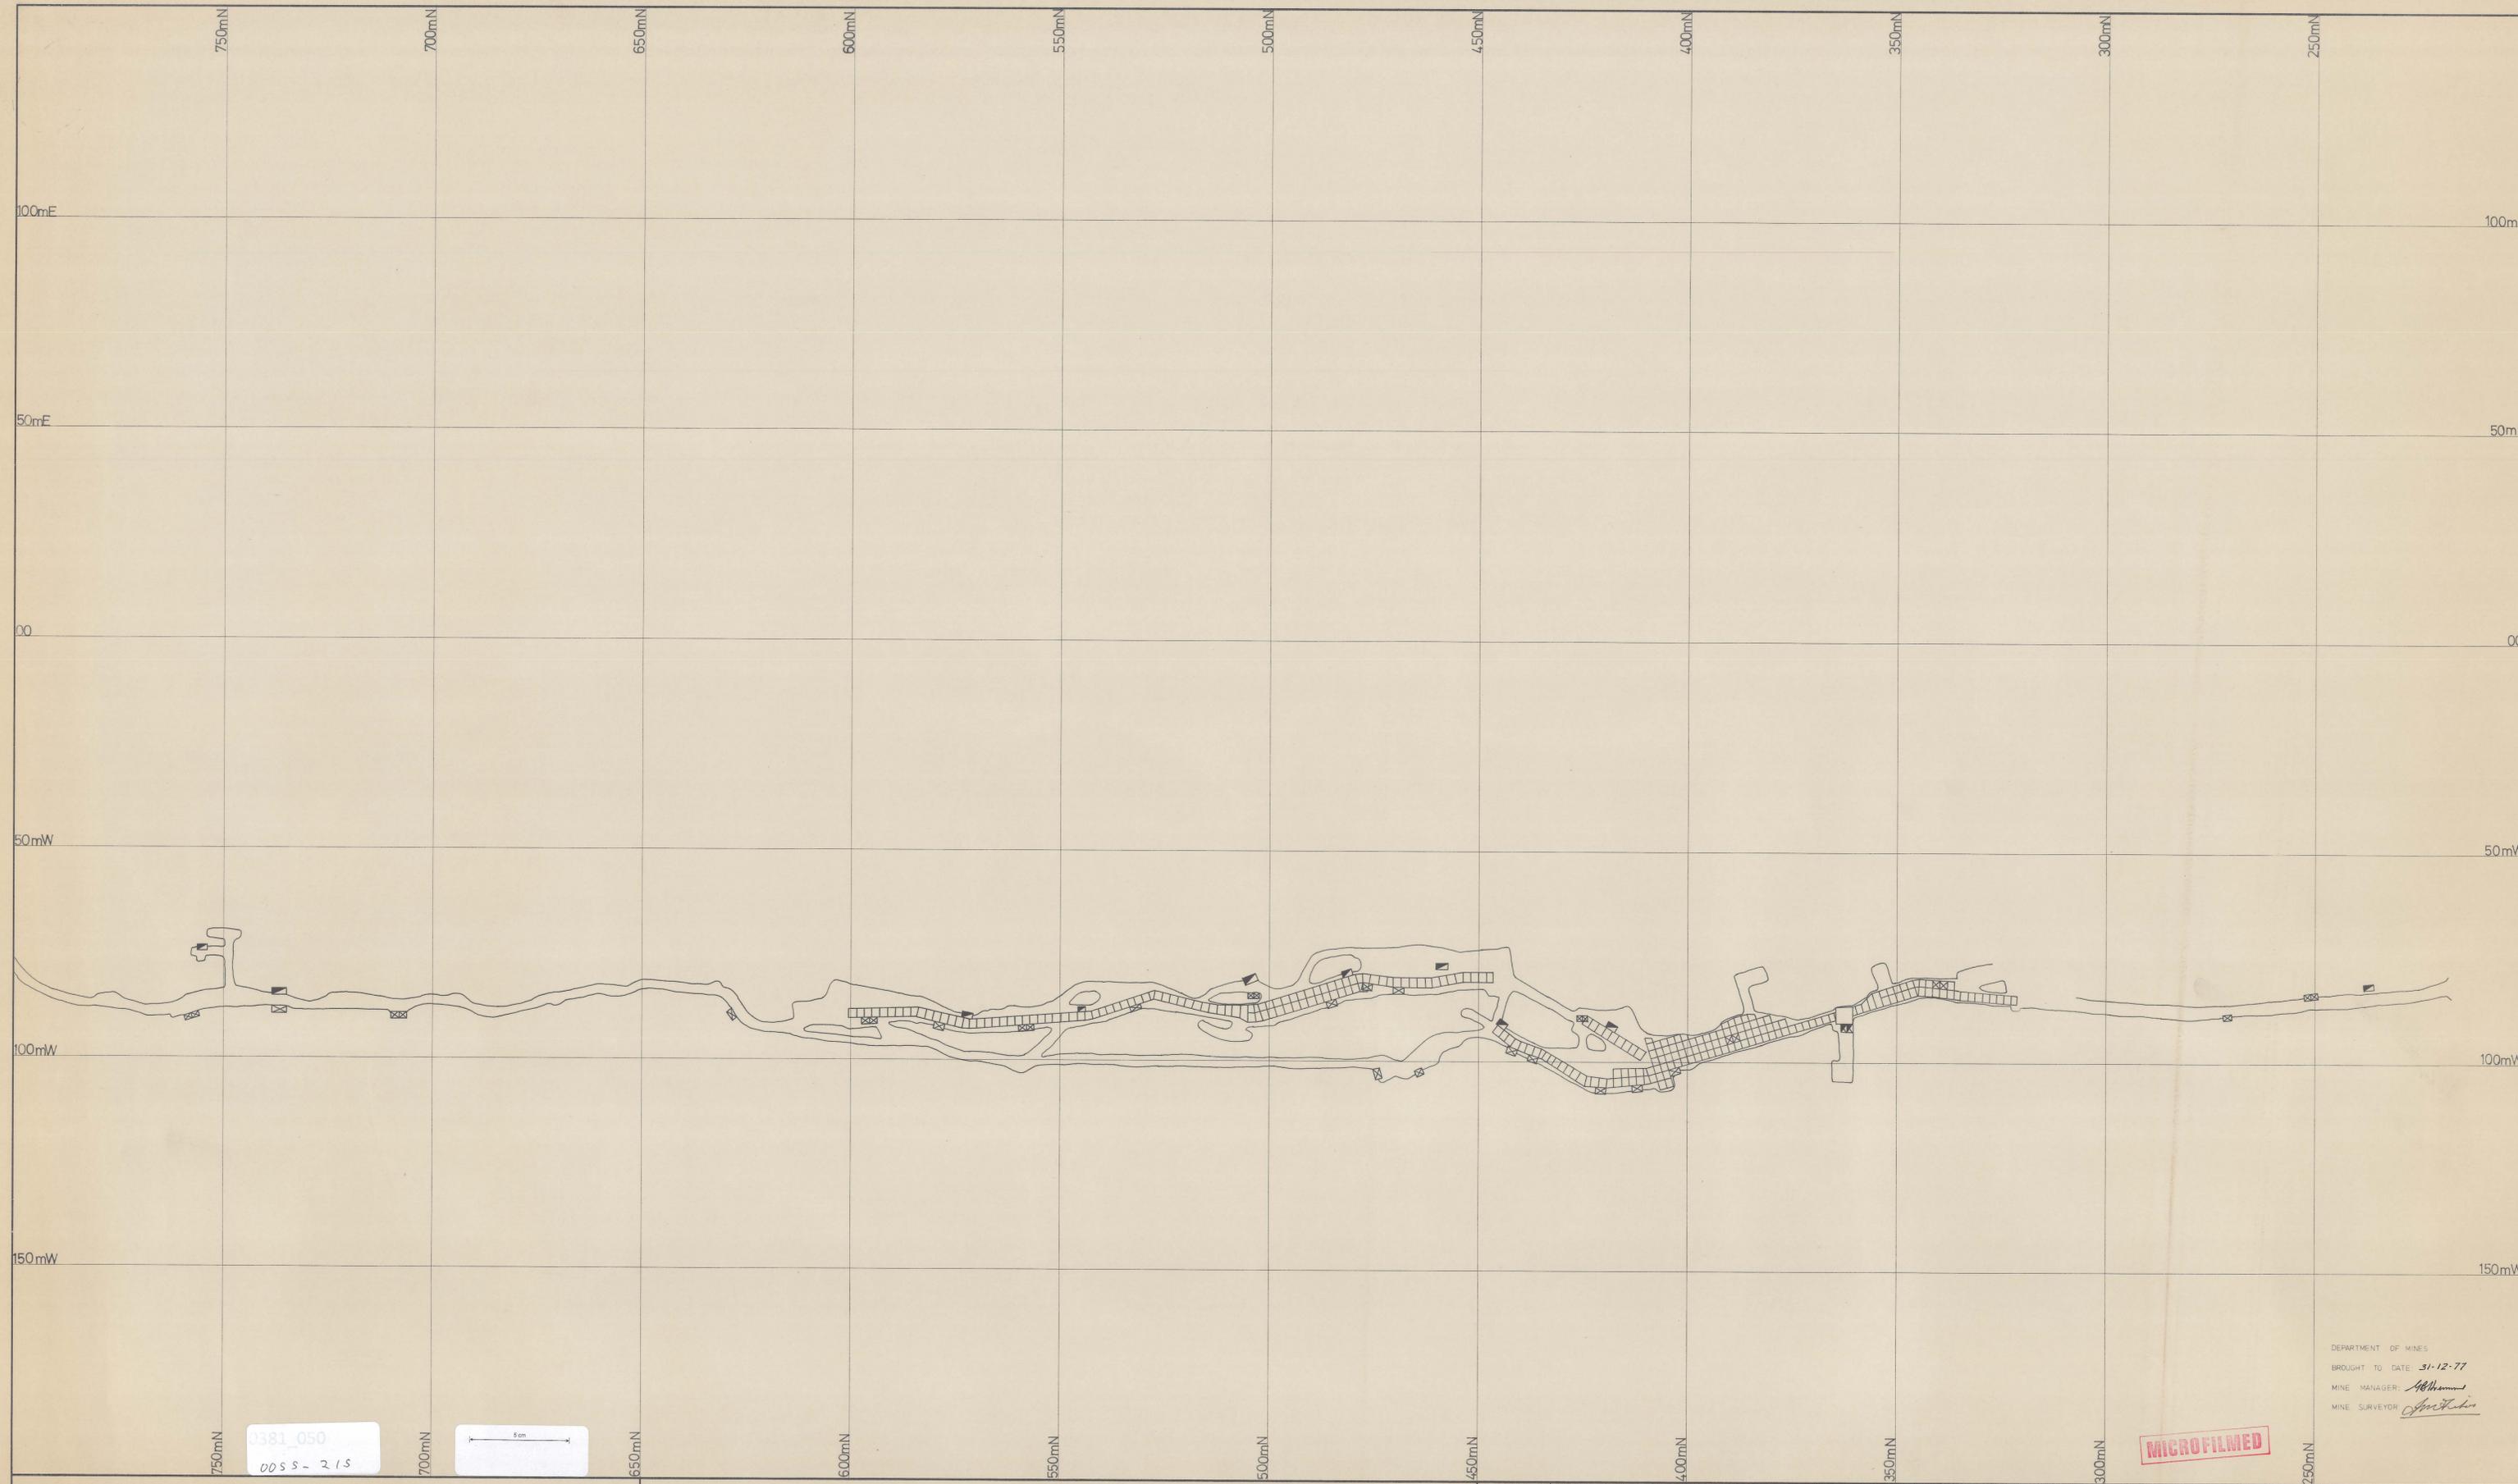

ELECTROLYTIC ZINC COMPANY OF AUSTRALASIA LIMITED
WEST COAST MINES, T.A.S.

SURVEY BY		SCALE	1:500
DRAWN BY		DATE	1975
TRACED BY	RJR	REFERENCE	

ROSEBERRY MINE
No 4 LEVEL (2)

MICROFILMED

DEPARTMENT OF MINES
BROUGHT TO DATE: 31-12-77
MINE MANAGER: *M. Hammett*
MINE SURVEYOR: *J. Smith*

DRAWING No: ① ②
78127