



0055-216

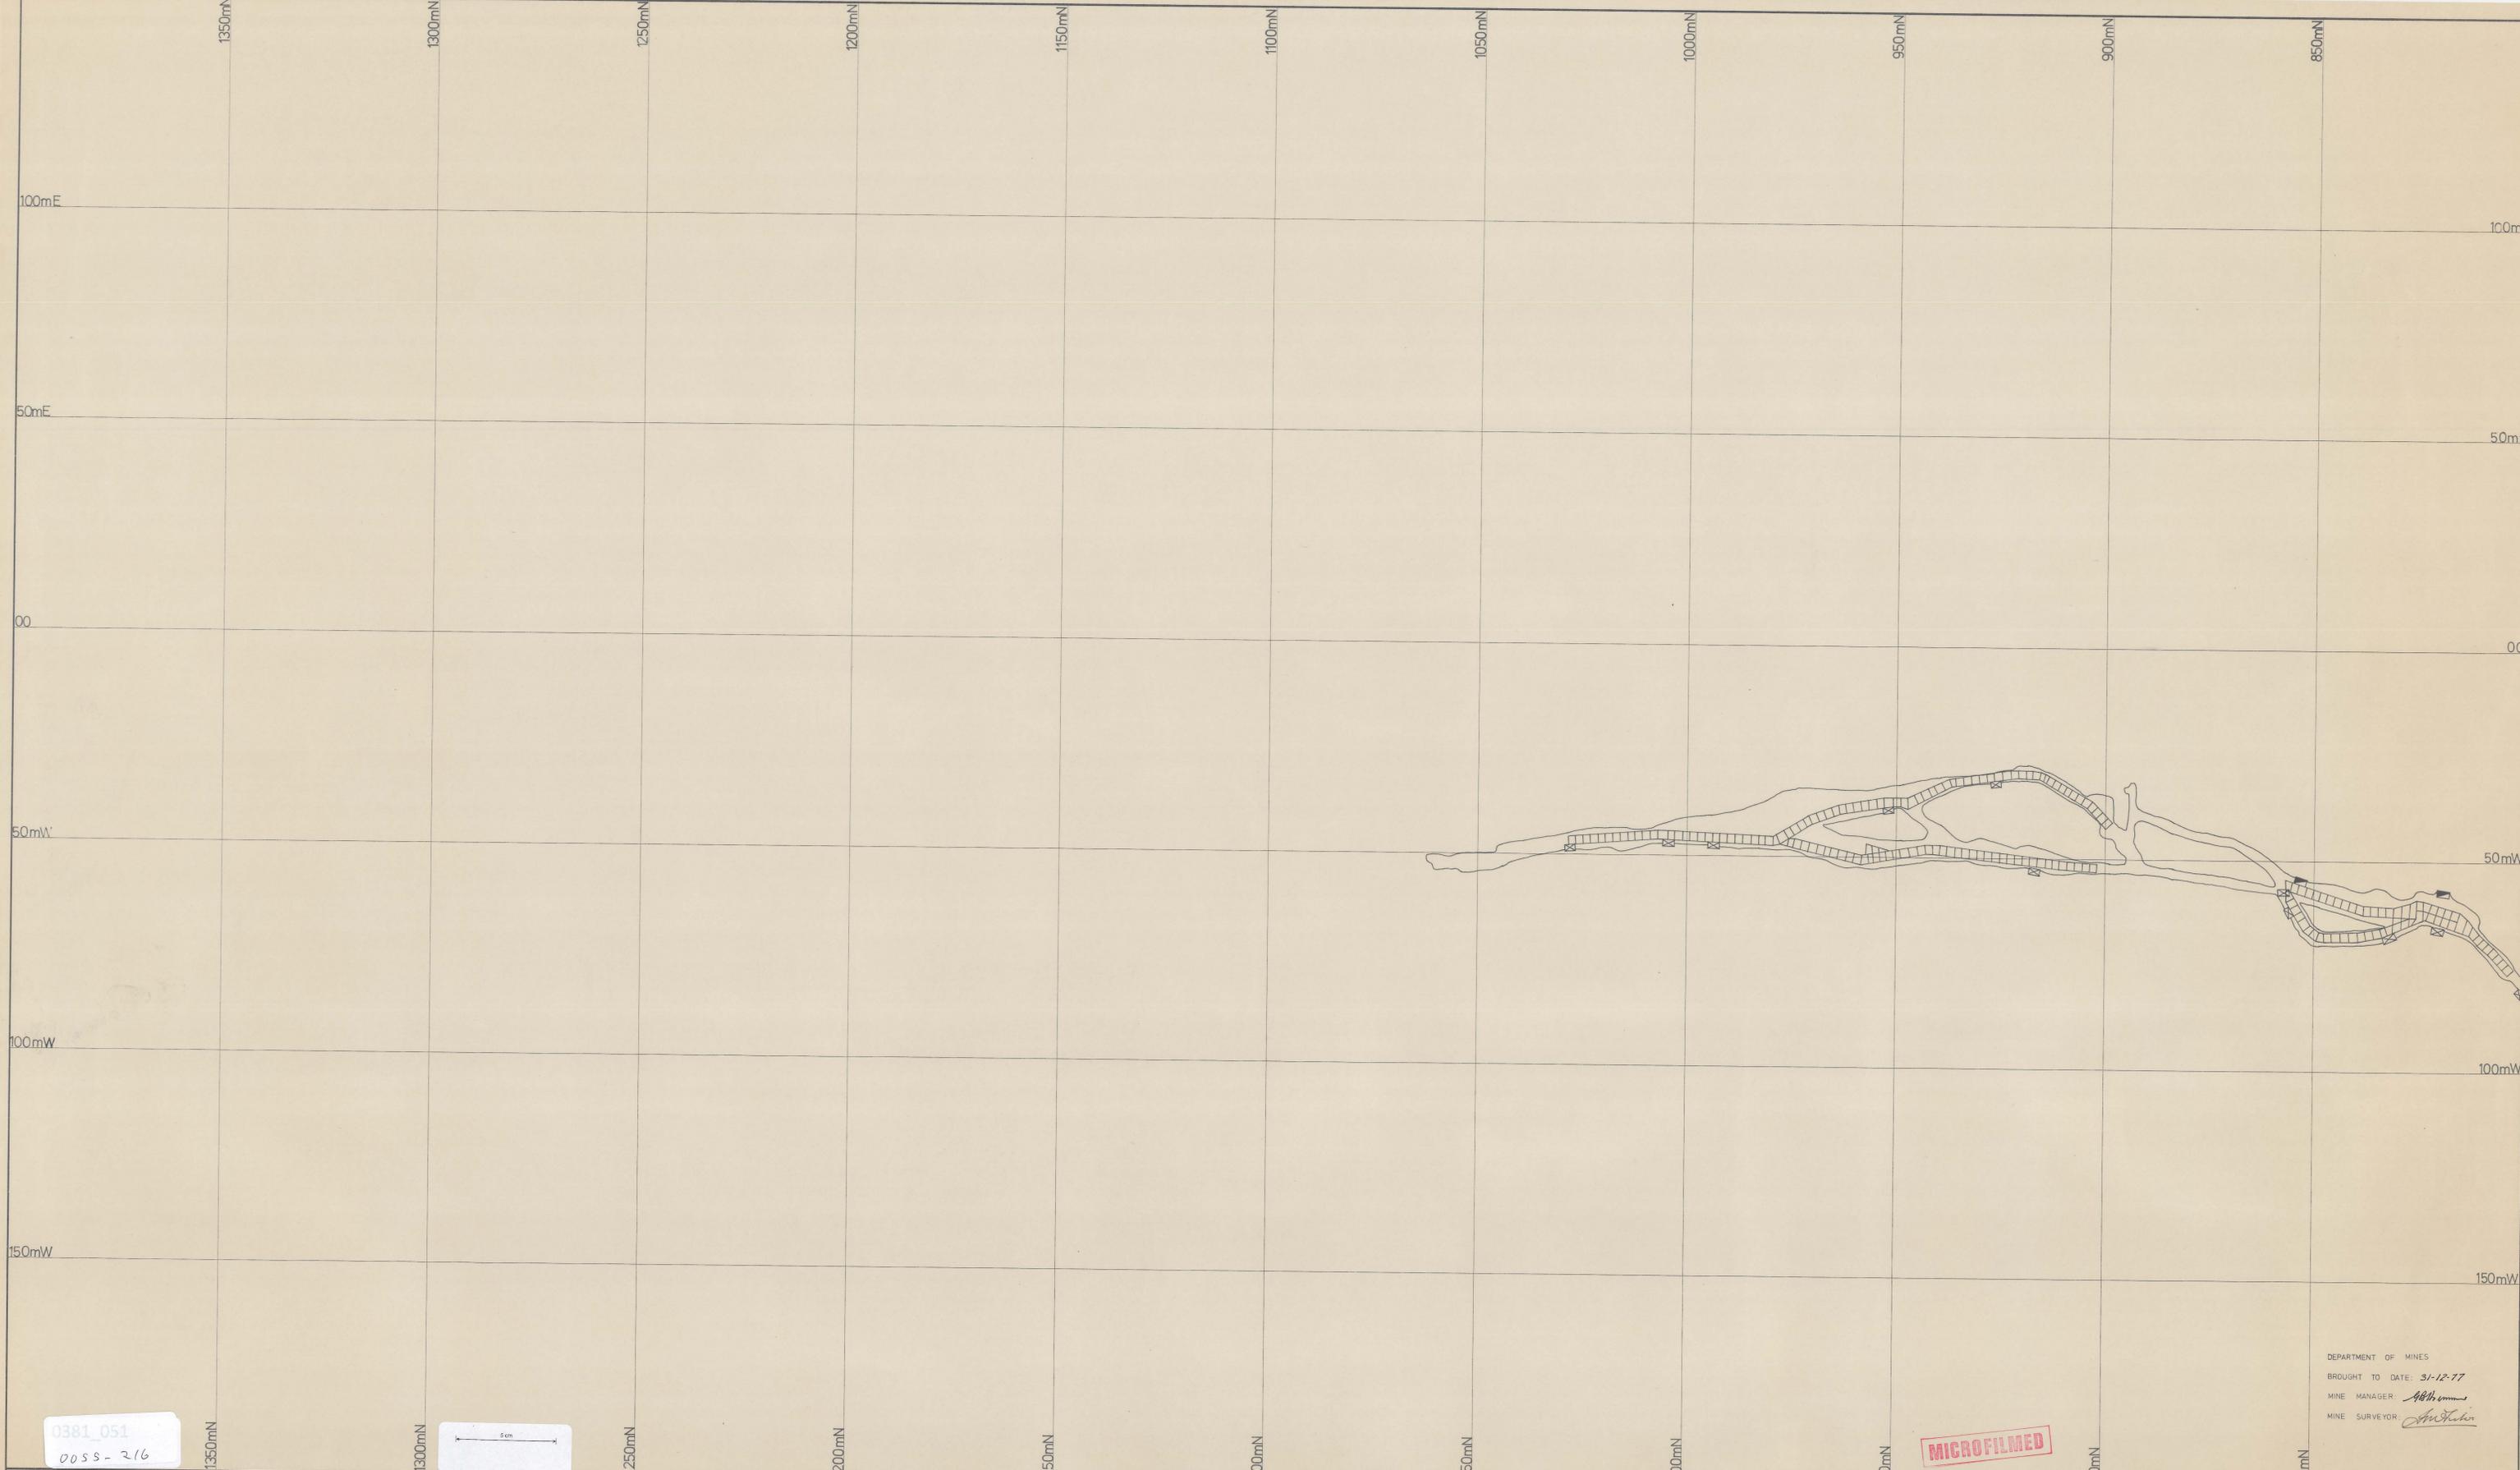

0381_051
0055-216

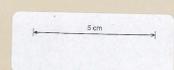

SCALE SHOWING 1:500 METRES AND EQUIVALENT FEET

ELECTROLYTIC ZINC COMPANY OF AUSTRALASIA LIMITED
WEST COAST MINES, T.A.S.

SURVEY BY		SCALE	1:500
DRAWN BY		DATE	1975
TRACED BY	RJR	REFERENCE	

MICROFILMED

ROSEBERY MINE
No 4 LEVEL (1)

DEPARTMENT OF MINES
BROUGHT TO DATE: 31-12-77
MINE MANAGER: *[Signature]*
MINE SURVEYOR: *[Signature]*

DRAWING No: **78126**