



0381-053

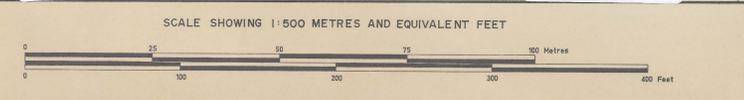

0381_053
0055-218

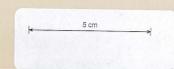

ELECTROLYTIC ZINC COMPANY OF AUSTRALASIA LIMITED
WEST COAST MINES, T.A.S.

| | | |
|---------------|-----------|-------|
| SURVEY BY | SCALE | 1:500 |
| DRAWN BY | DATE | 1975 |
| TRACED BY RJR | REFERENCE | |

DEPARTMENT OF MINES
BROUGHT TO DATE: 31-12-77
MINE MANAGER: *AGH*
MINE SURVEYOR: *AGH*

MICROFILMED

ROSEBERY MINE
Nº 2 LEVEL (1)

DRAWING Nº:
78124