

00 SS-219




0381_054
00 SS-219

50m

MICROFILMED

DEPARTMENT OF MINES
BROUGHT TO DATE: 31-12-77
MINE MANAGER: *Abraham*
MINE SURVEYOR: *John Fisher*

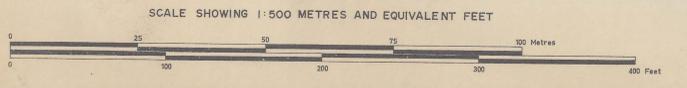

ELECTROLYTIC ZINC COMPANY OF AUSTRALASIA LIMITED
WEST COAST MINES, T.A.S.

SURVEY BY		SCALE	1:500
DRAWN BY		DATE	1975
TRACED BY	RJR	REFERENCE	

ROSEBERY MINE
No 1 LEVEL (2)

DRAWING No: 78123