


0055_220




0381_055
0055-220

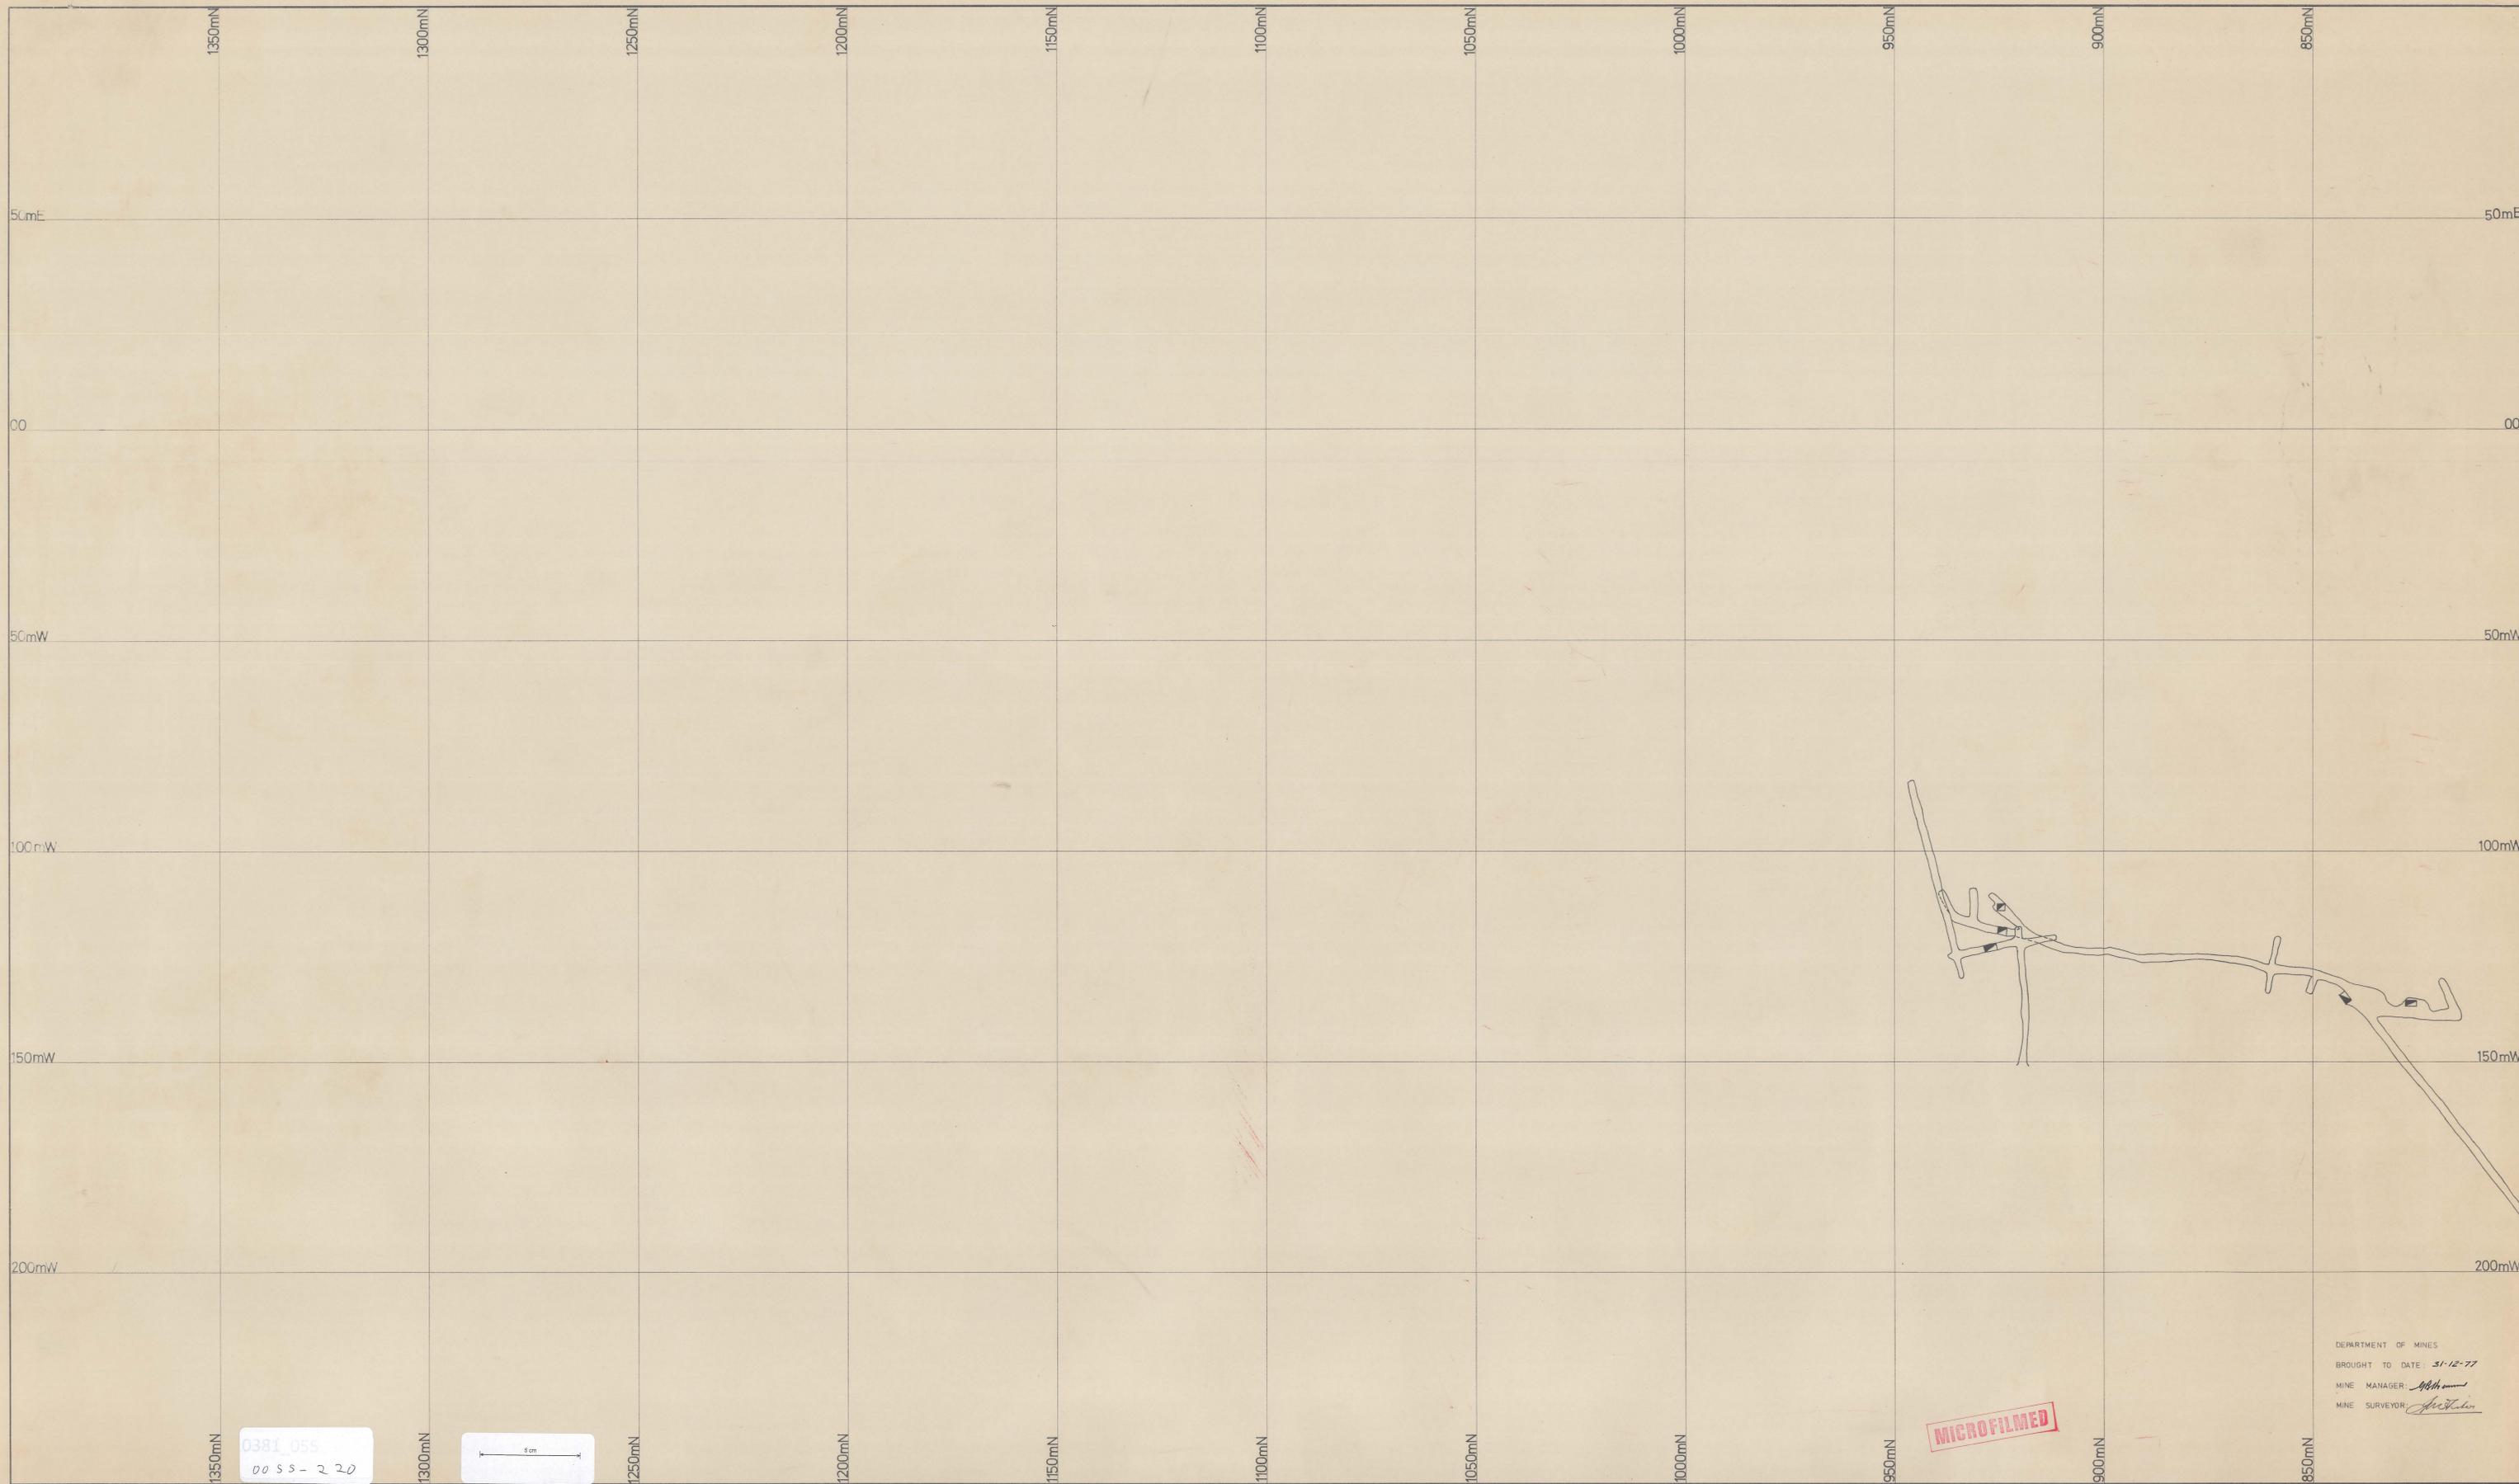

MICROFILMED

DEPARTMENT OF MINES
BROUGHT TO DATE: 31-12-77
MINE MANAGER: *[Signature]*
MINE SURVEYOR: *[Signature]*

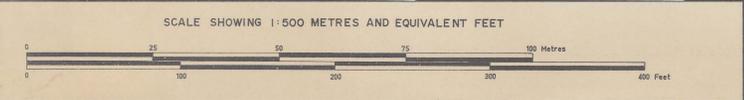

ELECTROLYTIC ZINC COMPANY OF AUSTRALASIA LIMITED
WEST COAST MINES, T.A.S.

SURVEY BY		SCALE	1:500
DRAWN BY		DATE	1975
TRACED BY	RJR	REFERENCE	

ROSEBERY MINE
No 1 LEVEL (1)

DRAWING No: **78-122**