


0053-221



0053-221

BROUGHT TO DATE : 31-12-77
 MINE MANAGER : *M. H. ...*
 MINE SURVEYOR : *J. ...*

MICROFILMED

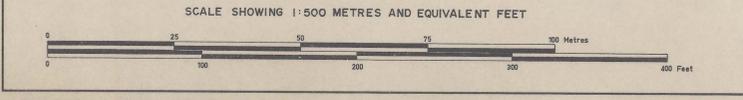

ELECTROLYTIC ZINC COMPANY OF AUSTRALASIA LIMITED
 WEST COAST MINES, T.A.S.

SURVEY BY		SCALE	1 : 500
DRAWN BY		DATE	1973
TRACED BY	P.J. Lowe	REFERENCE	

HERCULES MINE
 LONGITUDINAL PROJECTION

78162

DRAWING NO. :
 DEPARTMENT OF MINES