
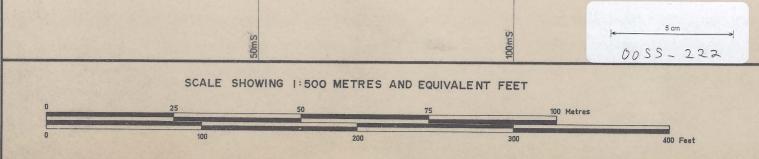


0055-222

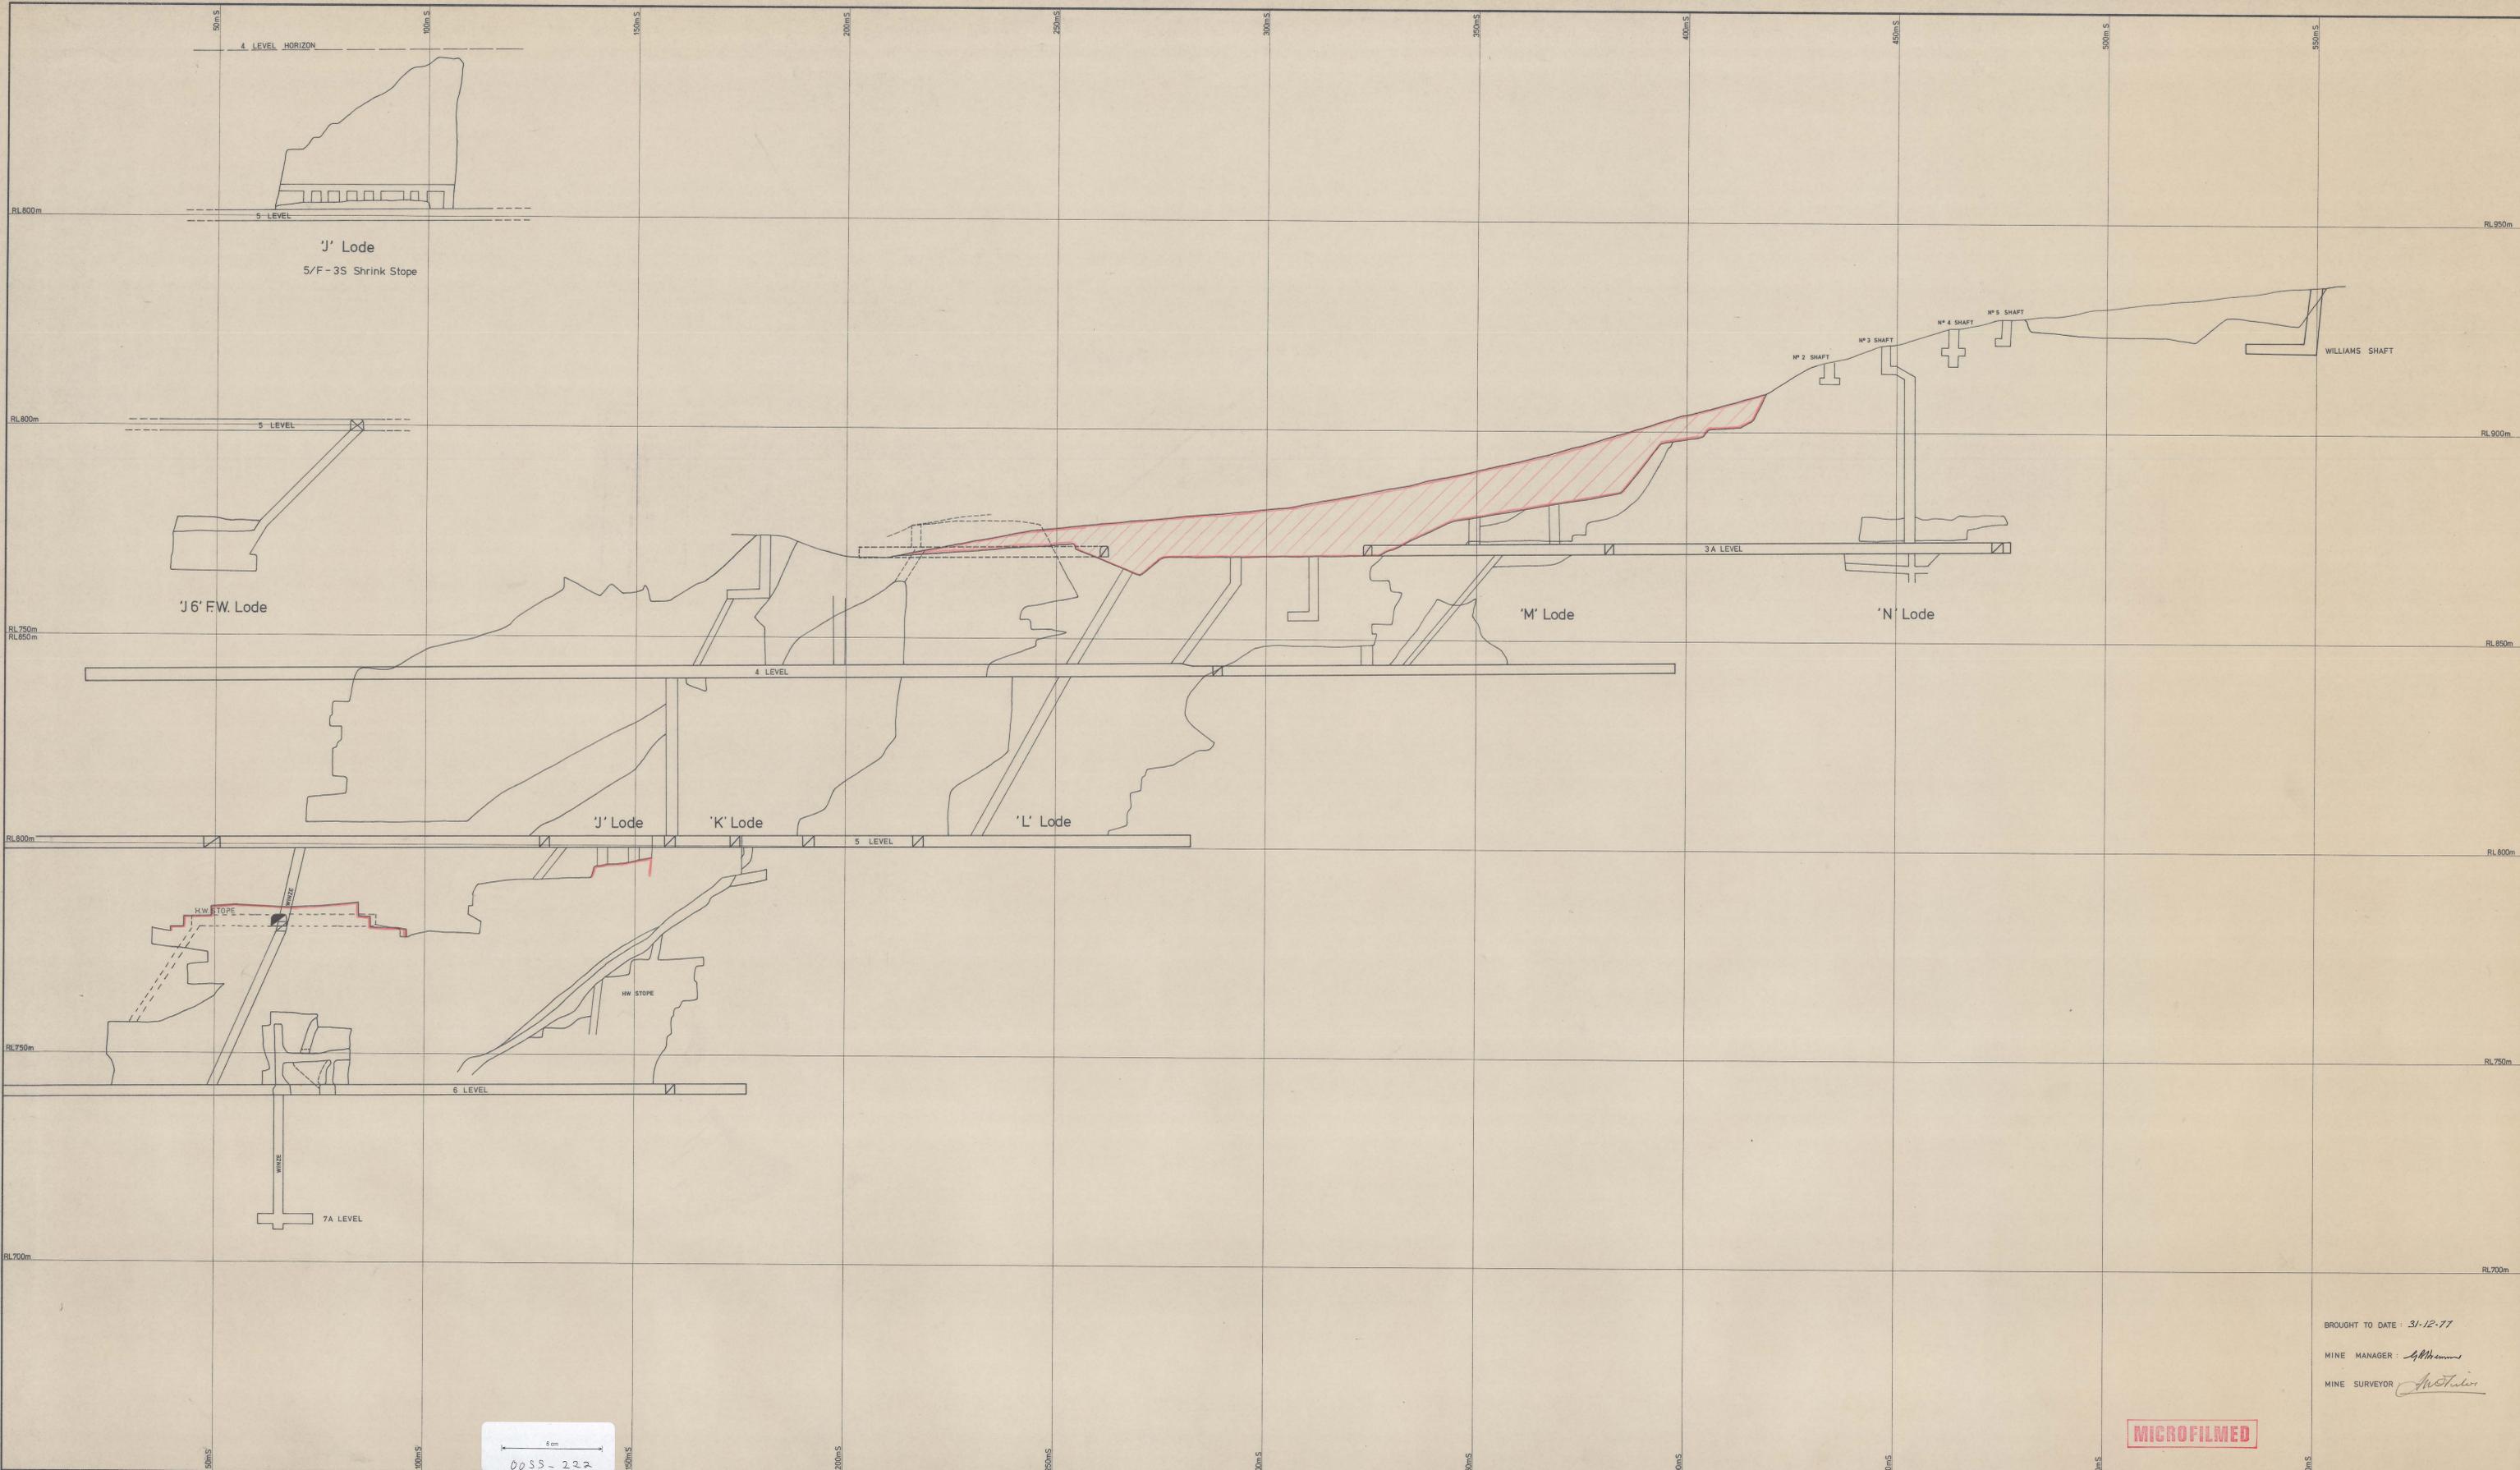

ELECTROLYTIC ZINC COMPANY OF AUSTRALASIA LIMITED
WEST COAST MINES, TAS.

SURVEY BY		SCALE	1 : 500
DRAWN BY		DATE	1973
TRACED BY	P. J. Lowe	REFERENCE	

HERCULES MINE
LONGITUDINAL PROJECTION

MICROFILMED

78161

BROUGHT TO DATE: 31-12-77
MINE MANAGER: *[Signature]*
MINE SURVEYOR: *[Signature]*

DRAWING NO.:
DEPARTMENT OF MINES