

00 55 - 223




'C' Lode

'E' Lode

'B' Lode

BROUGHT TO DATE: 31-12-77  
 MINE MANAGER: *A. Brown*  
 MINE SURVEYOR: *J. Smith*

MICROFILMED

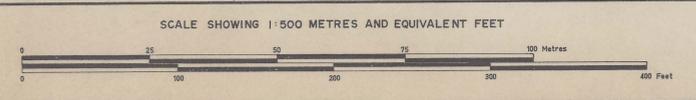

ELECTROLYTIC ZINC COMPANY OF AUSTRALASIA LIMITED  
 WEST COAST MINES, T.A.S.

SURVEY BY		SCALE	1 : 500
DRAWN BY		DATE	1973
TRACED BY	P.J. Lowe	REFERENCE	

HERCULES MINE  
 LONGITUDINAL PROJECTION 78160

DRAWING NO: \_\_\_\_\_  
 DEPARTMENT OF MINES