


0055-224



BROUGHT TO DATE : 31-12-77  
 MINE MANAGER : *Abraham*  
 MINE SURVEYOR : *John*

**MICROFILMED**

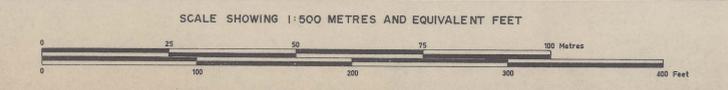

**ELECTROLYTIC ZINC COMPANY OF AUSTRALASIA LIMITED**  
 WEST COAST MINES, T.A.S.

SURVEY BY		SCALE	1 : 500
DRAWN BY		DATE	1973
TRACED BY	P.J. Lowe	REFERENCE	

HERCULES MINE  
 LONGITUDINAL PROJECTION *78159*  
 DRAWING N°:  
 DEPARTMENT OF MINES